PARENT PARCEL: 12-00-023-000-023, -064

CHILD PARCEL: 12-00-023-000-105, -106

STARTING POINT: INTERSECTION OF C/L OF SNELL RD. AND C/L OF N. BOONE RD.

17-03760

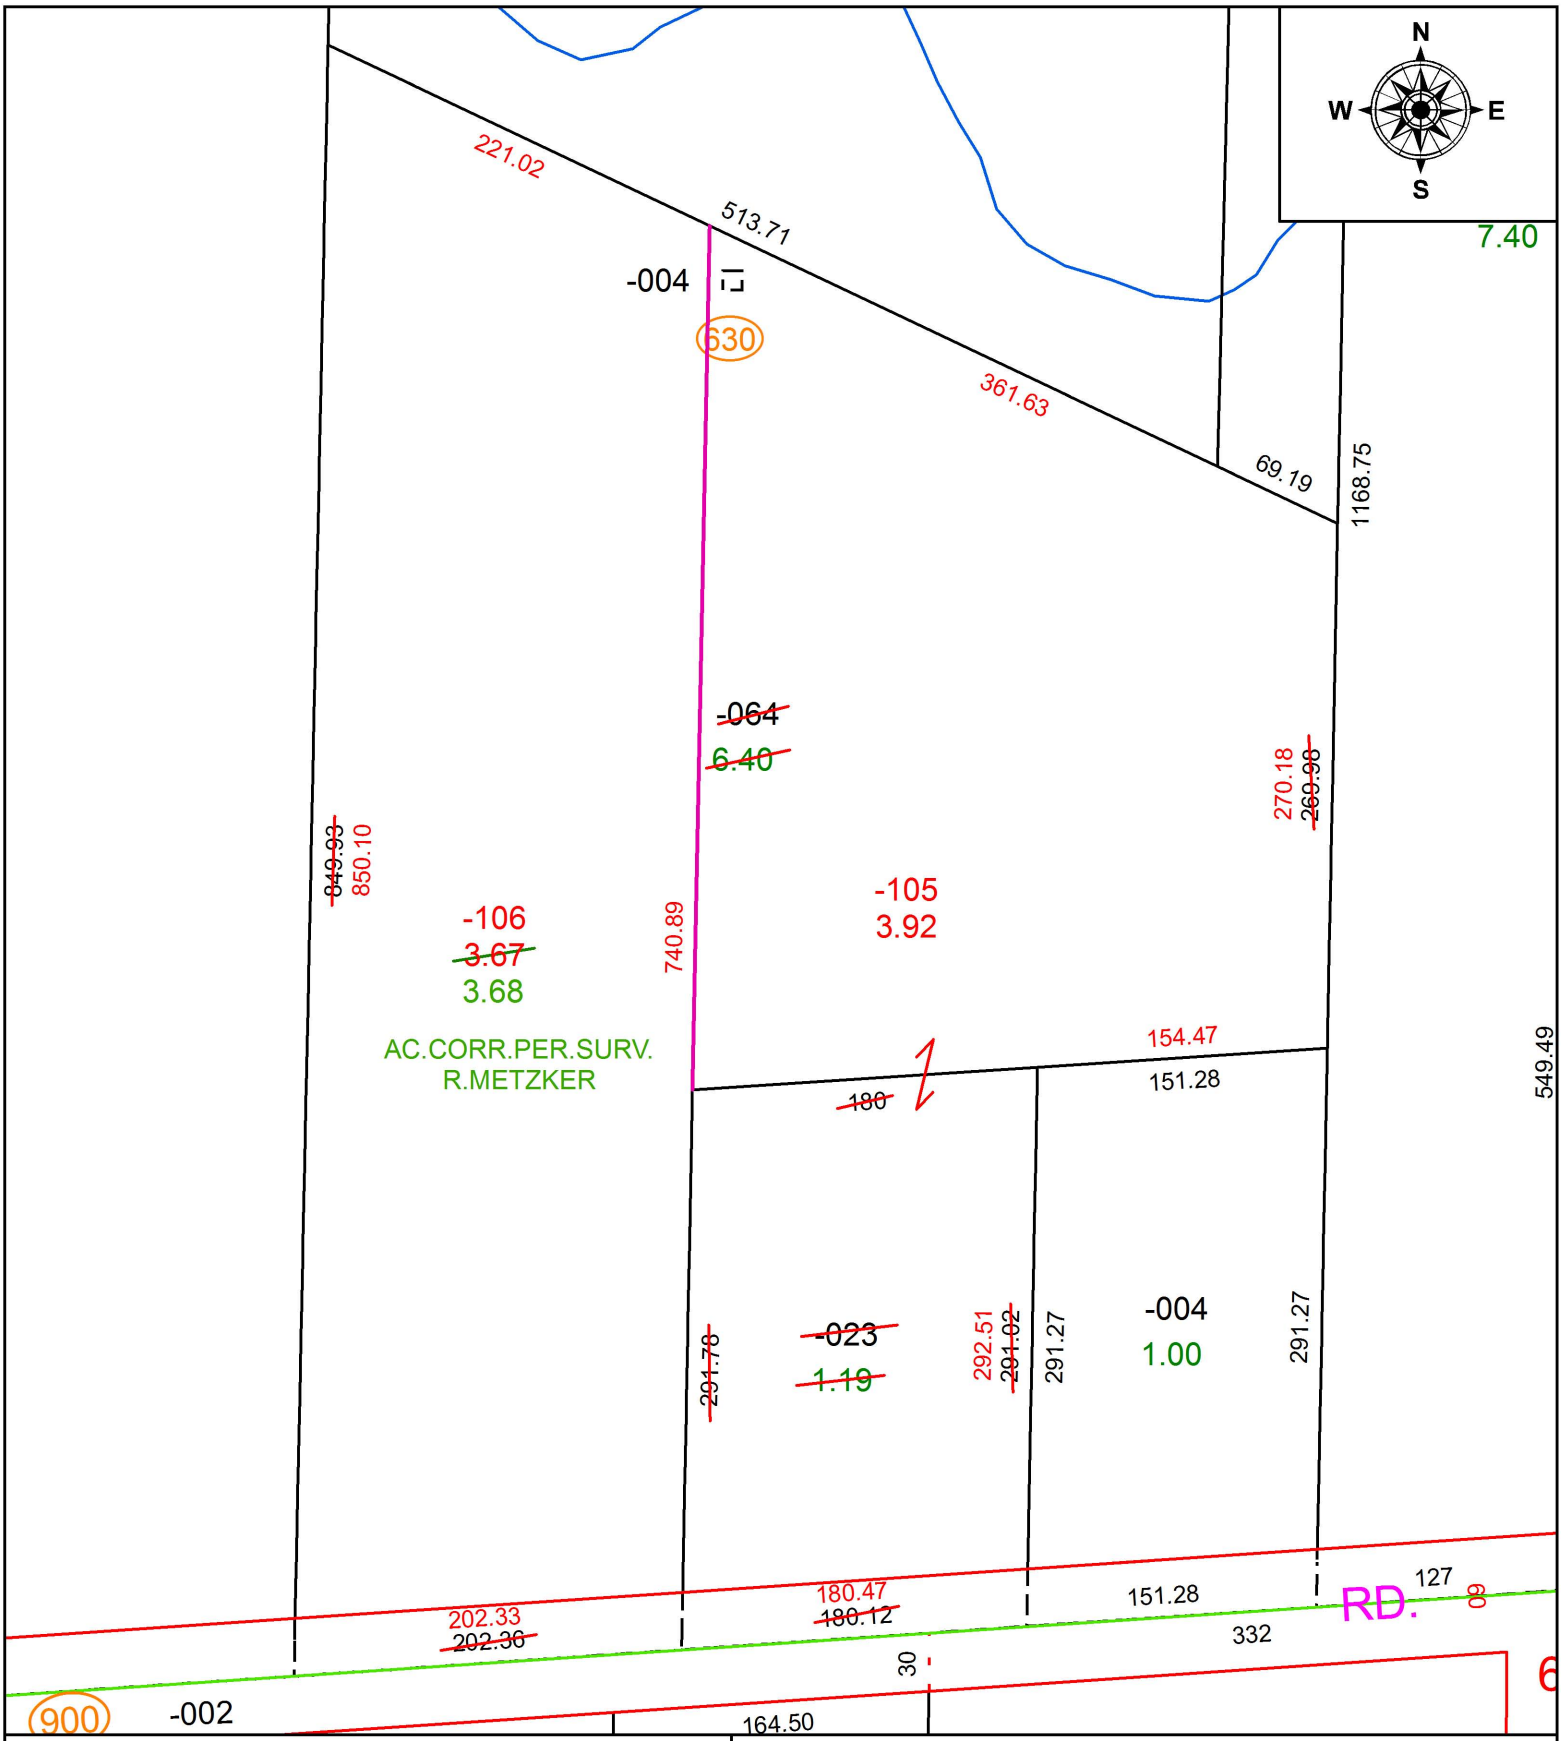

SPLITS/DEEDS PROCESSED

LORAIN COUNTY TAX MAP DEPARTMENT
226 MIDDLE AVE. ELYRIA, OH

SURVEYED BY: RICHARD METZKER
CLOSURE: 1: 181,523
MAP PAGE(S): 12-00-023
APPOVED BY: RRM **DATE:** 12-21-17
SCALE: 1" = 100 **PRIOR INSTRUMENT:** 19980569219