PARENT PARCEL: 21-05-038-000-015

CHILD PARCEL: 21-05-038-000-016, -017

STARTING POINT: INTERSECTION OF C/L OF QUARRY RD, AND C/L OF GRIGGS RD.

17-03763

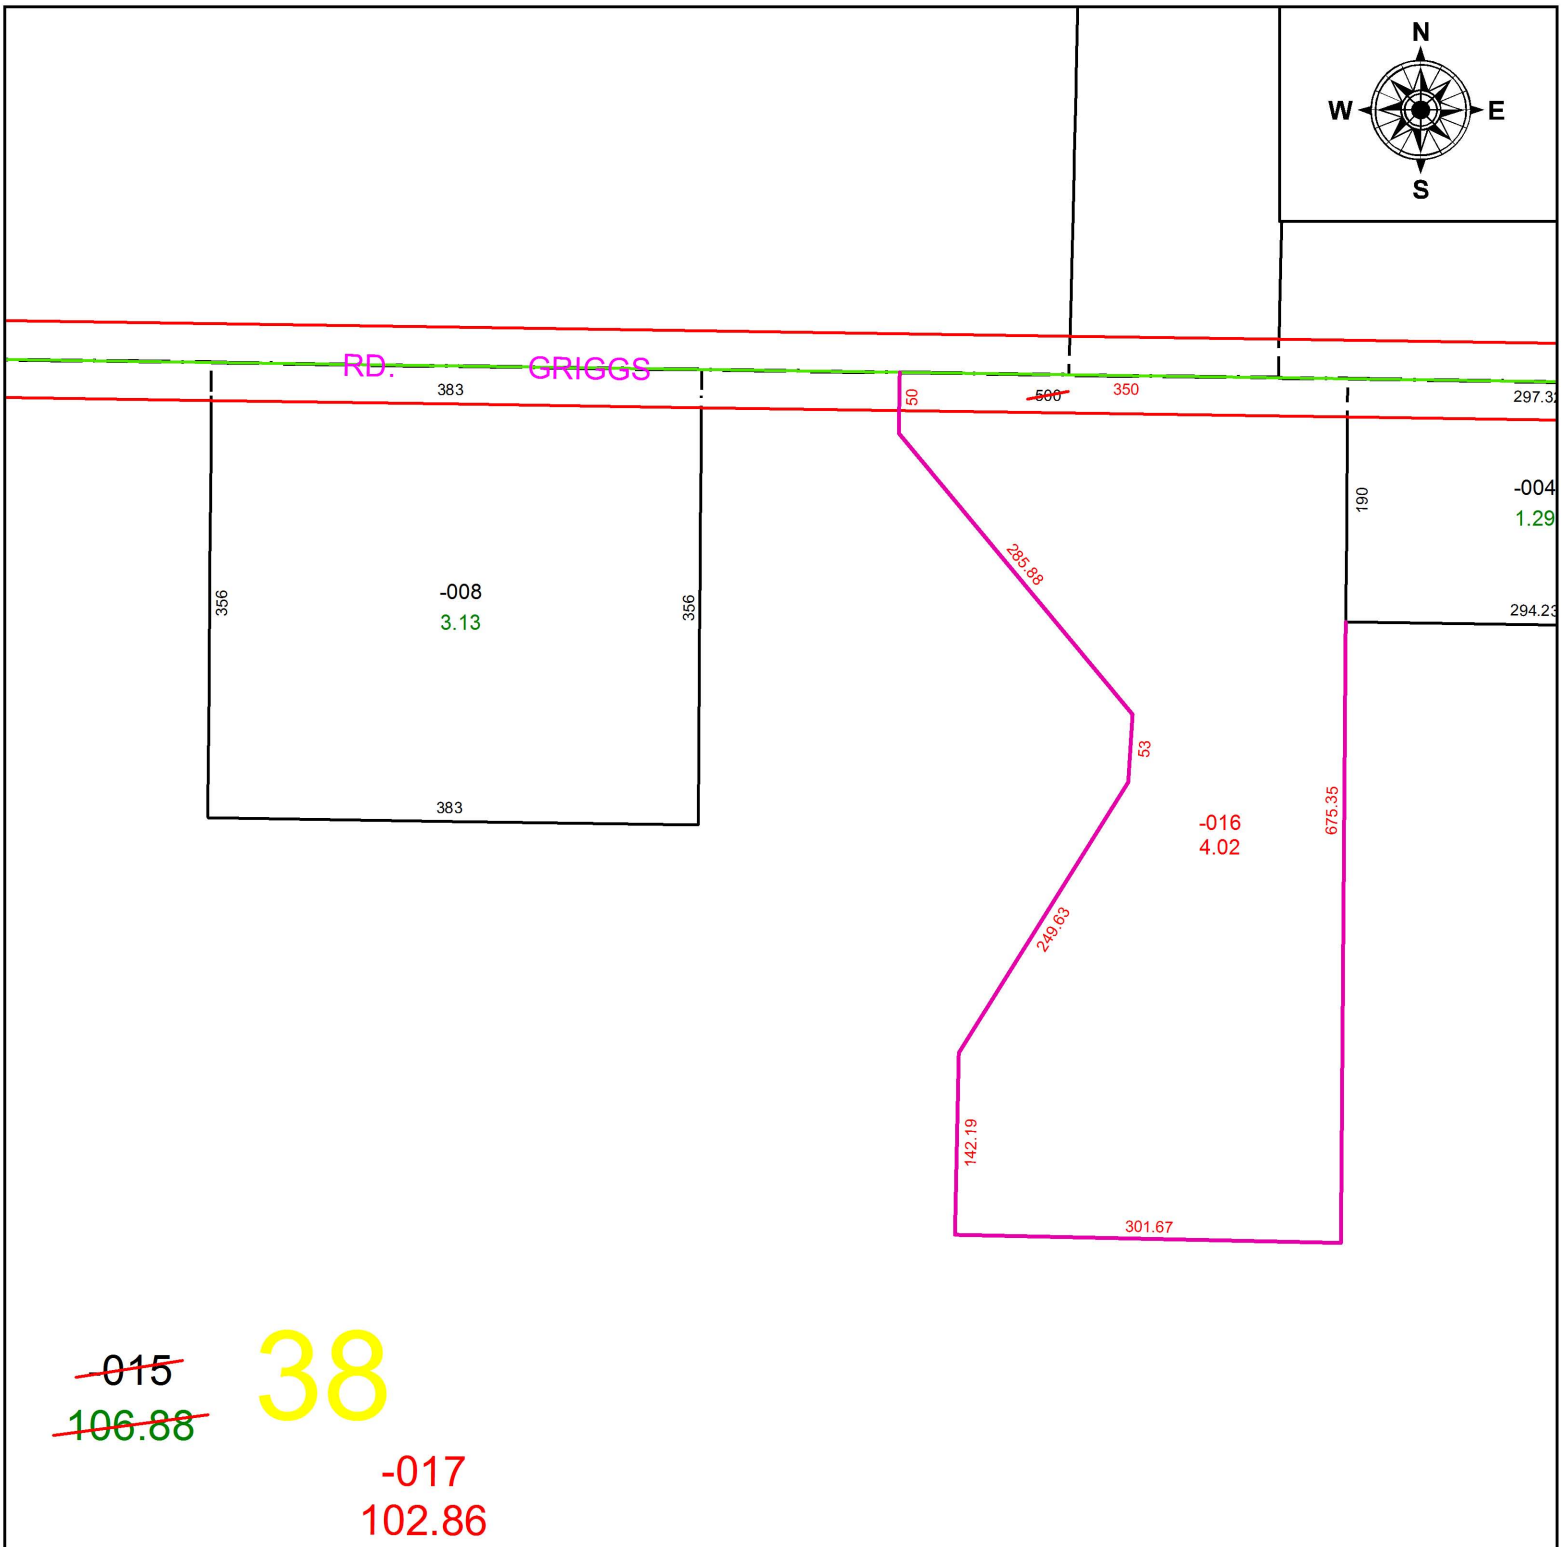

SPLITS/DEEDS PROCESSED

LORAIN COUNTY TAX MAP DEPARTMENT
226 MIDDLE AVE. ELYRIA, OH

SURVEYED BY: JAMES ALLEN COTTRELL
CLOSURE: 1: 220,117
MAP PAGE(S): 21-A
APPOVED BY: RRM **DATE:** 1-3-18
SCALE: 1" = 150 **PRIOR INSTRUMENT:** 20090298237