PARENT PARCEL: 07-00-001-000-081
CHILD PARCEL: 07-00-001-000-383, -384
STARTING POINT: NORTHEAST CORNER OF S/L 19 IN SWAN SUB.

17-03766

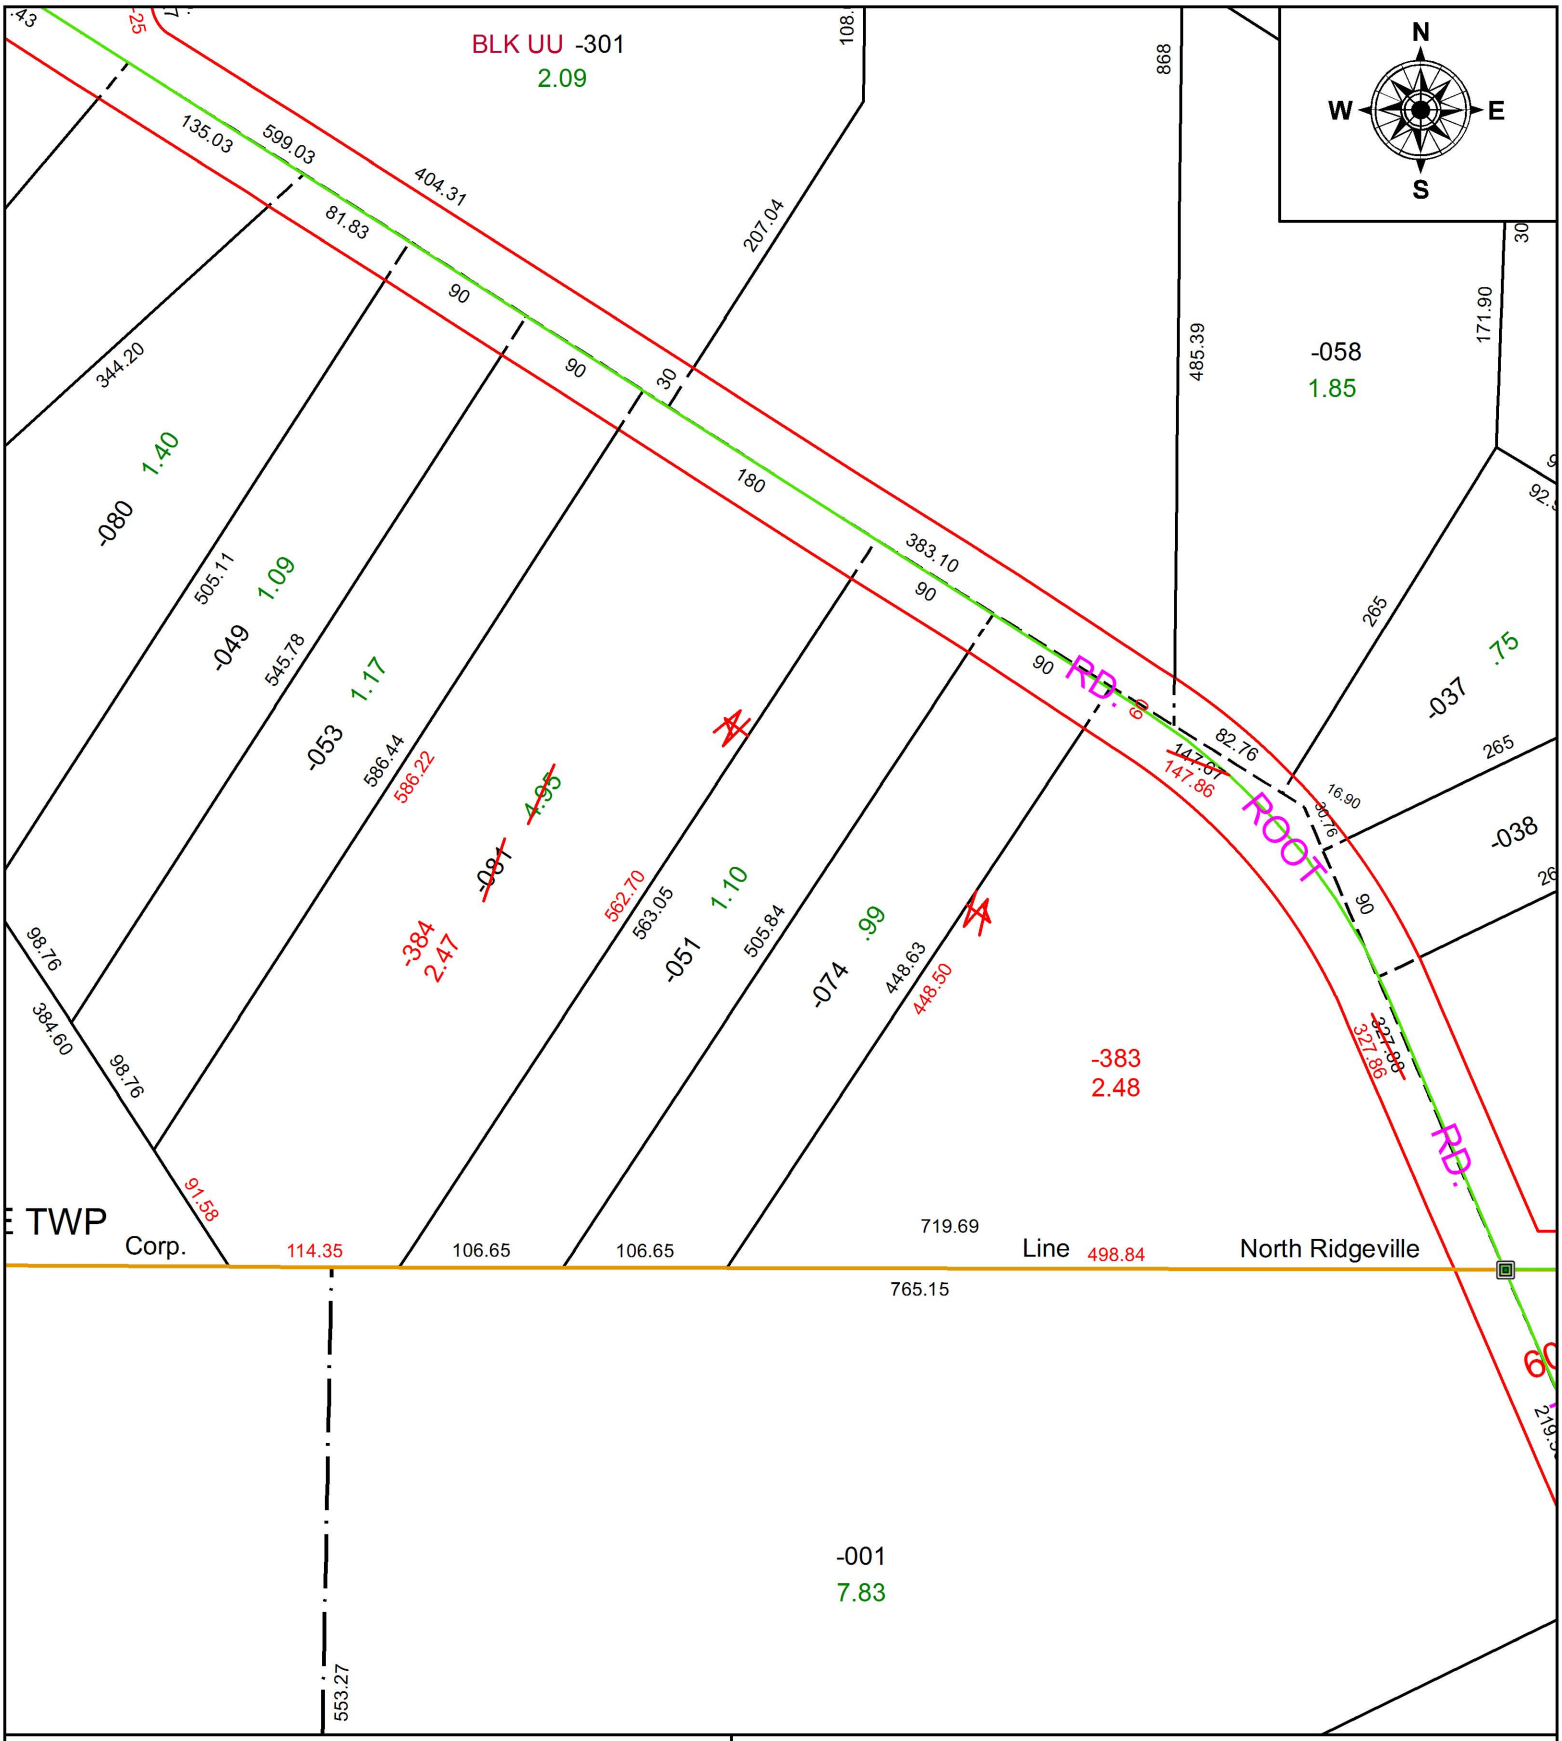

SPLITS/DEEDS PROCESSED
LORAIN COUNTY TAX MAP DEPARTMENT
226 MIDDLE AVE. ELYRIA, OH

SURVEYED BY: GERALD L. YETZER
CLOSURE: 1: 225,227
MAP PAGE(S): 7-00-001
APPOVED BY: RRM **DATE:** 1-3-18
SCALE: 1" = 125 **PRIOR INSTRUMENT:** 20170623174