PARENT PARCEL: 09-00-014-101-054, -060

CHILD PARCEL: 09-00-014-101-061 THRU -063

STARTING POINT: SOUTHWEST CORNER OF O.L.14

18-03771

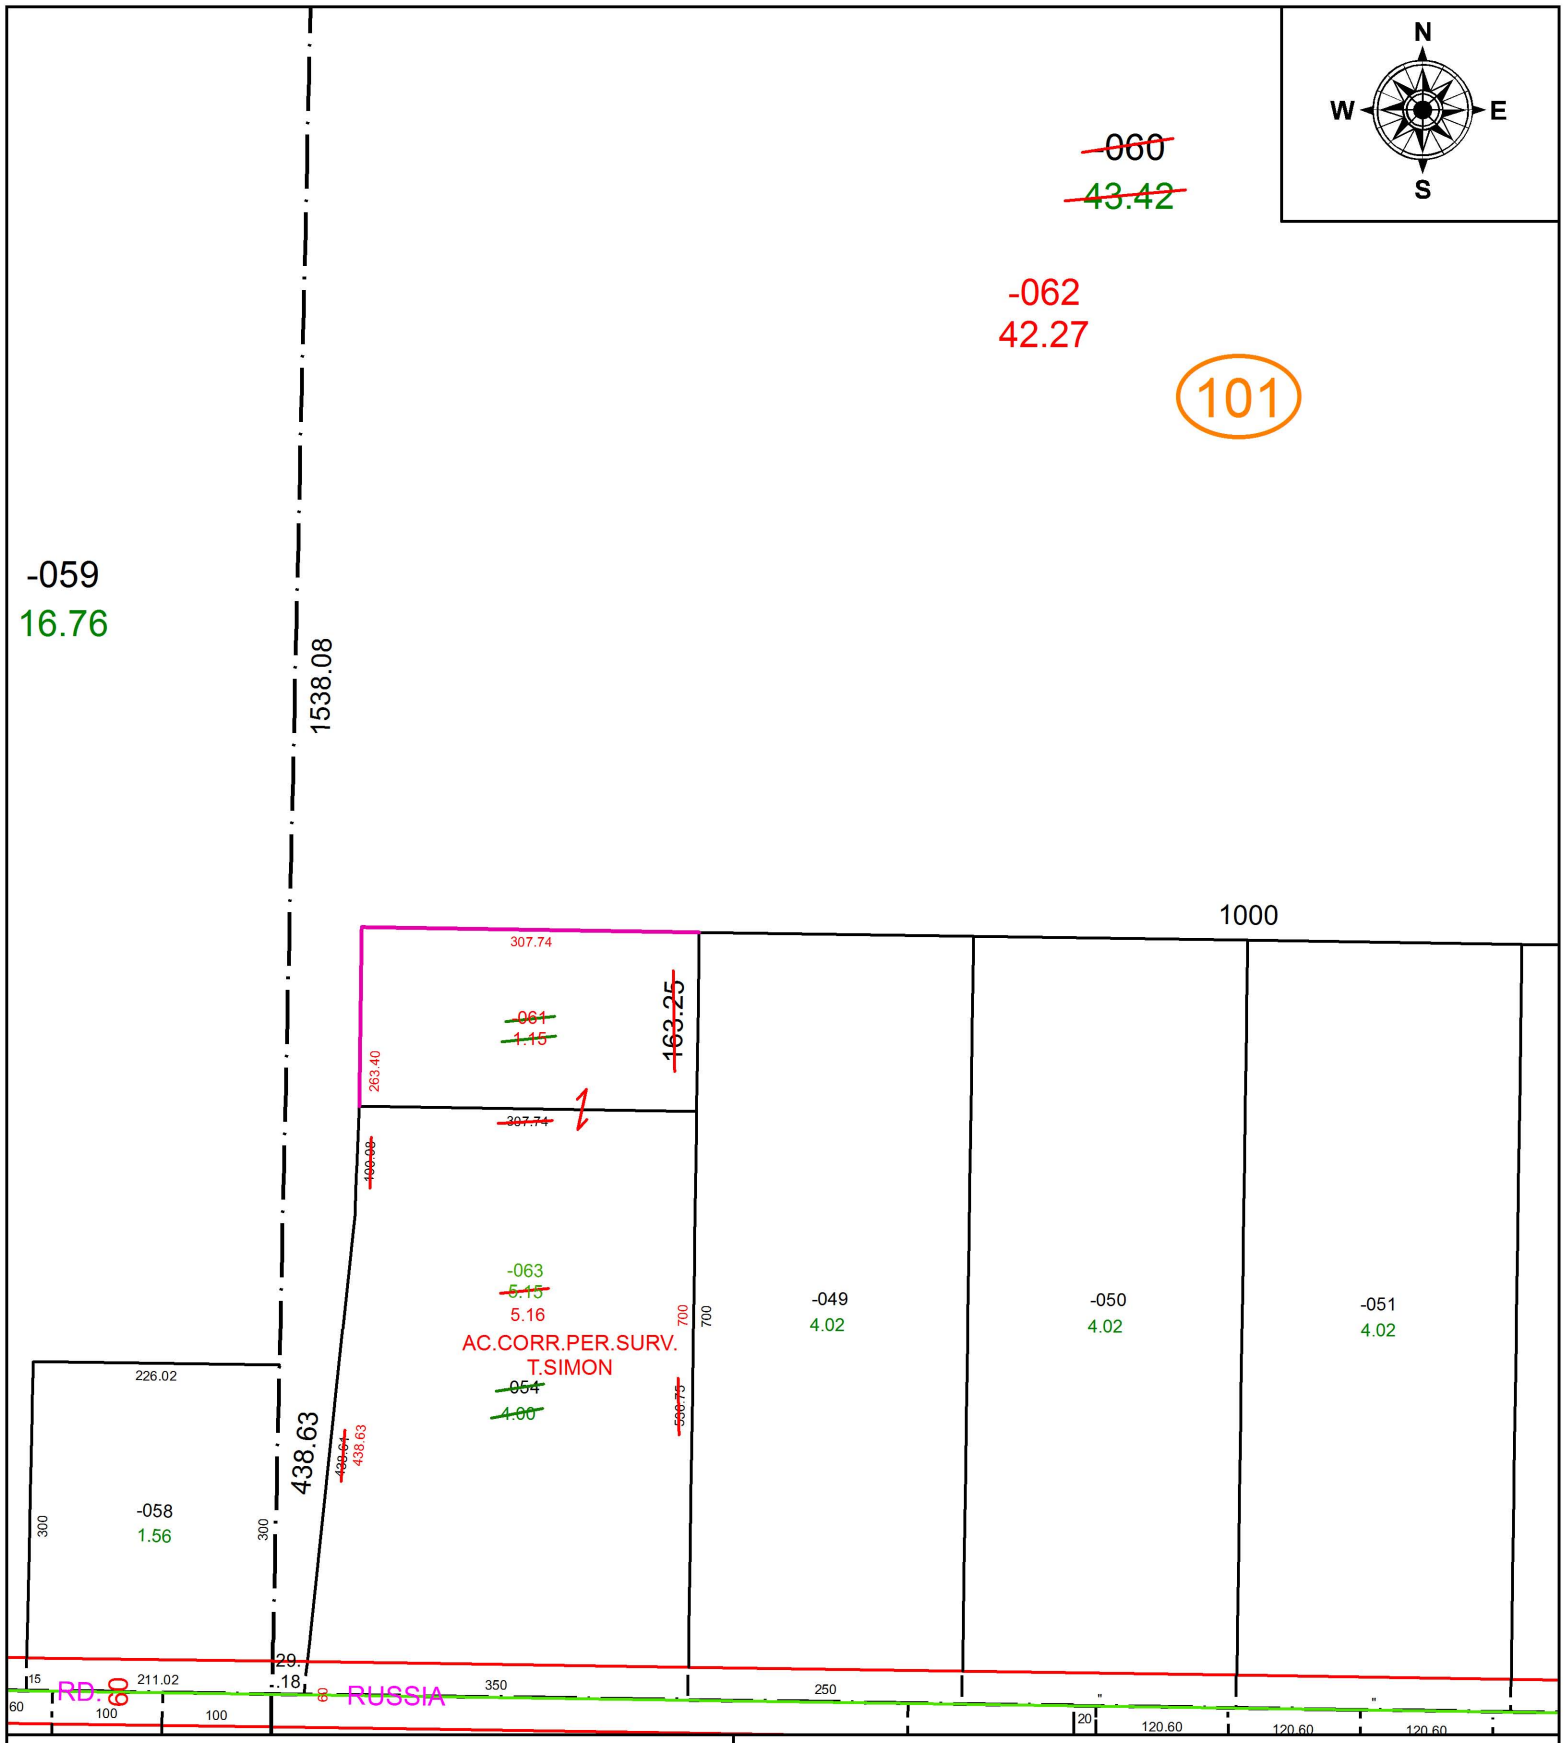

SPLITS/DEEDS PROCESSED

LORAIN COUNTY TAX MAP DEPARTMENT
226 MIDDLE AVE. ELYRIA, OH

SURVEYED BY: THOMAS A. SIMON
CLOSURE: 1: 303,268
MAP PAGE(S): 9-00-014
APPOVED BY: RRM **DATE:** 1-18-18
SCALE: 1" = 175 **PRIOR INSTRUMENT:** 20130487016