**PARENT PARCEL:** 11-00-034-000-025
**CHILD PARCEL:** 11-00-034-630-001
**STARTING POINT:**

# 17-03775-G

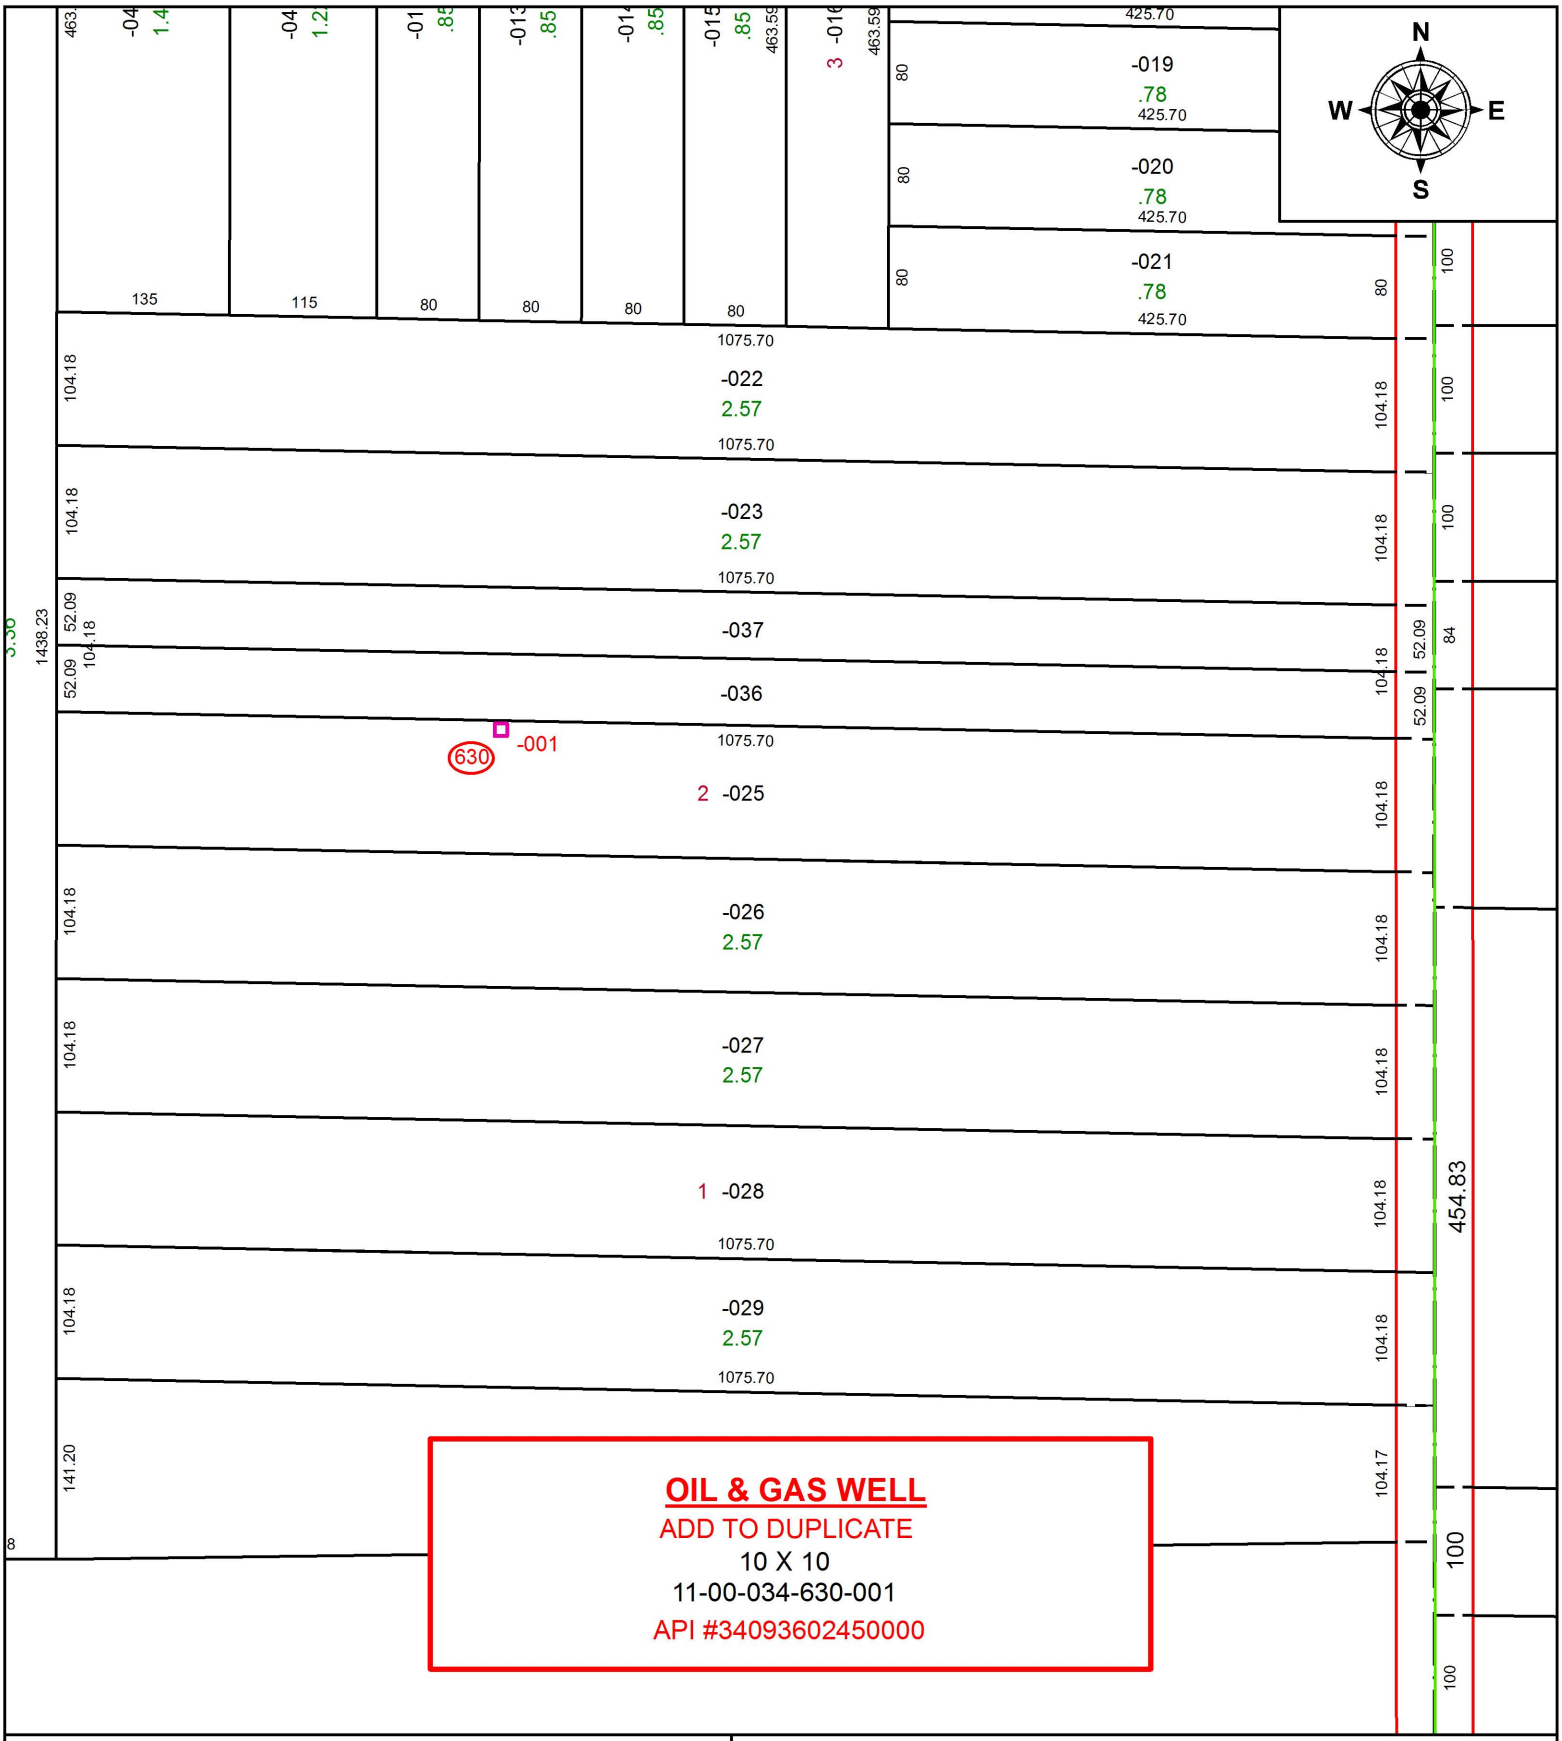


**SPLITS/DEEDS PROCESSED**

LORAIN COUNTY TAX MAP DEPARTMENT
226 MIDDLE AVE. ELYRIA, OH

**SURVEYED BY:** N/A
**CLOSURE:** N/A
**MAP PAGE(S):** 11-00-034
**APPOVED BY:** RRM **DATE:** 9-26-17
**SCALE:** 1" = 150 **PRIOR INSTRUMENT:** N/A