PARENT PARCEL: 05-00-083-000-017
CHILD PARCEL: 05-00-083-000-021, -022
STARTING POINT: NORTHEAST CORNER OF O.L.83

18-03777

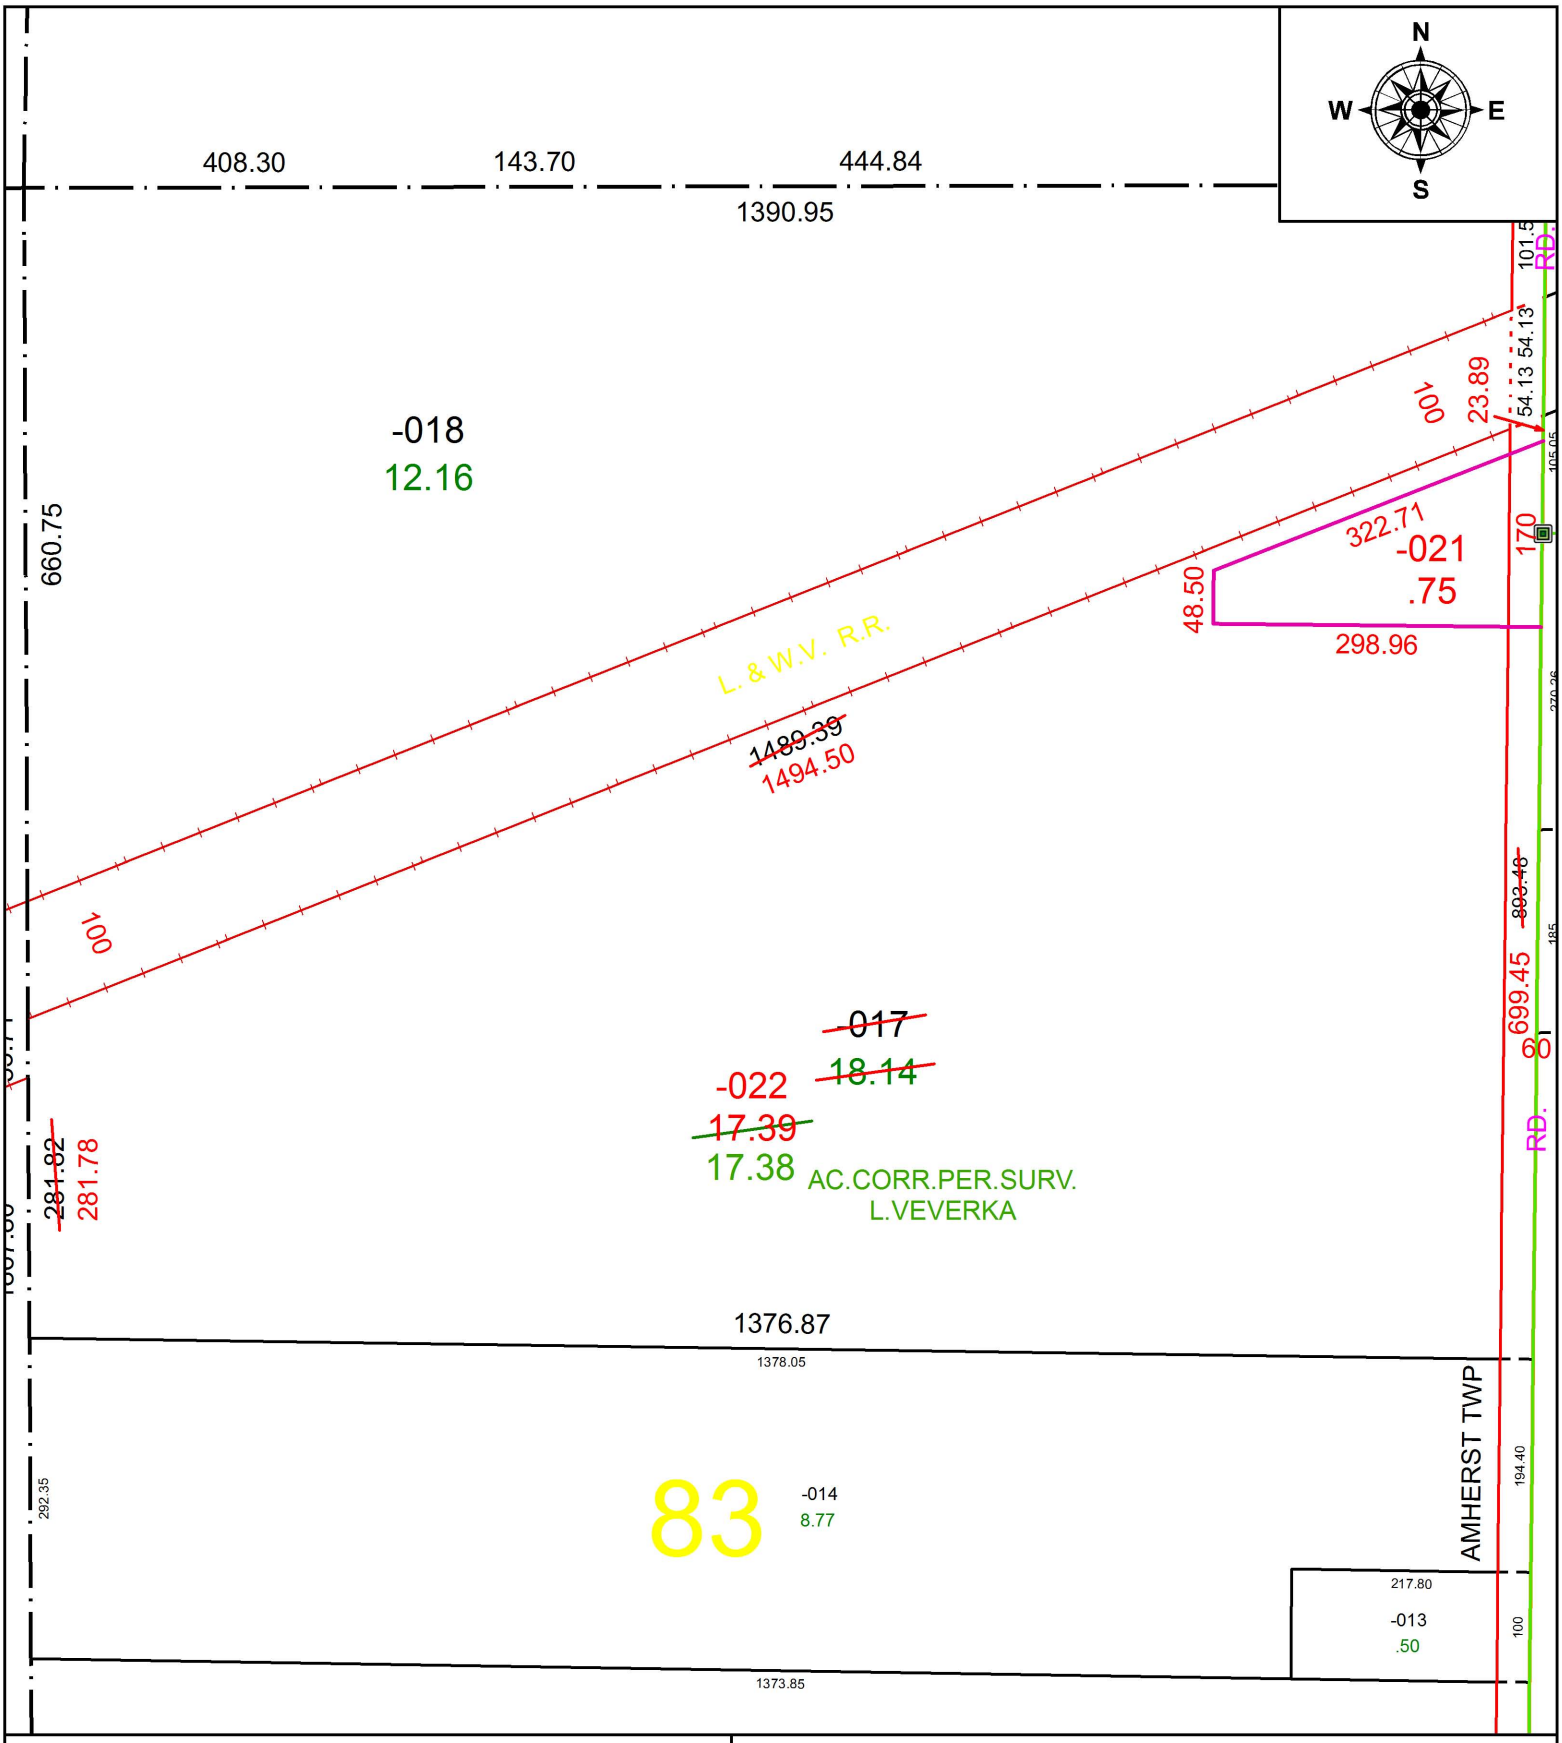

SPLITS/DEEDS PROCESSED
LORAIN COUNTY TAX MAP DEPARTMENT
226 MIDDLE AVE. ELYRIA, OH

SURVEYED BY: LOUISE A. VEVERKA
CLOSURE: 1: 211,548
MAP PAGE(S): 5-00-083
APPOVED BY: RRM **DATE:** 1-29-18
SCALE: 1" = 175 **PRIOR INSTRUMENT:** 20010747935