PARENT PARCEL: 09-00-099-000-061
CHILD PARCEL: 09-00-099-630-001
STARTING POINT:

17-03778-G

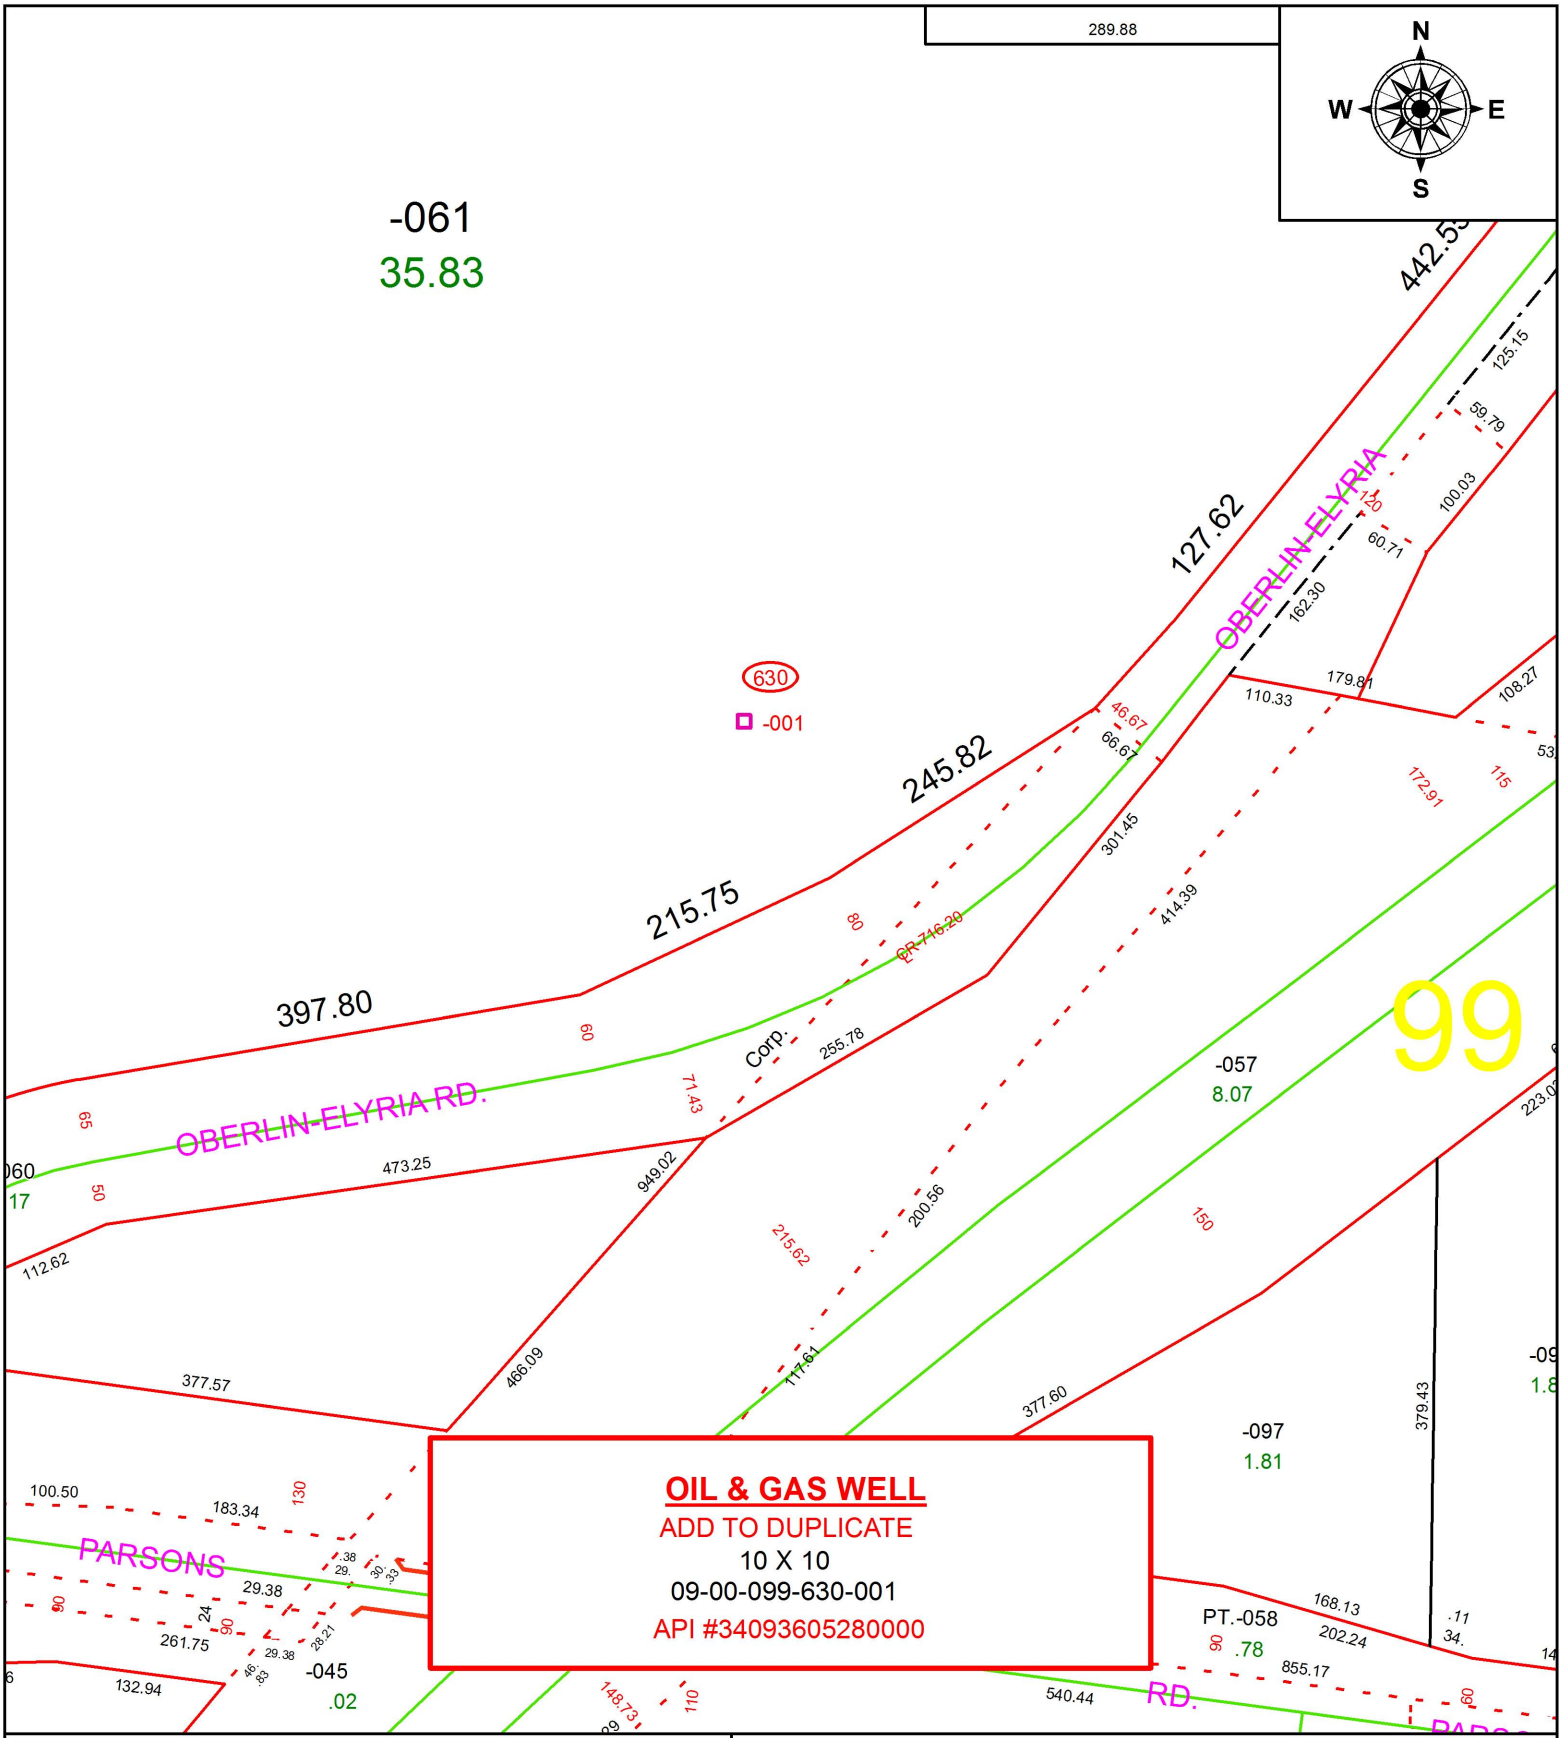

SPLITS/DEEDS PROCESSED

LORAIN COUNTY TAX MAP DEPARTMENT
226 MIDDLE AVE. ELYRIA, OH

SURVEYED BY: N/A
CLOSURE: N/A
MAP PAGE(S): 9-00-099
APPOVED BY: RRM **DATE:** 9-26-17
SCALE: 1" = 150 **PRIOR INSTRUMENT:** N/A