PARENT PARCEL: 07-00-025-101-035
CHILD PARCEL: XX-XX-XXX-XXX-XXX
STARTING POINT: SOUTHWEST CORNER OF LAND CONVEYED TO ALBIN F. & DONNA J. SCHMITT (DV 722/307)

17-03784-A

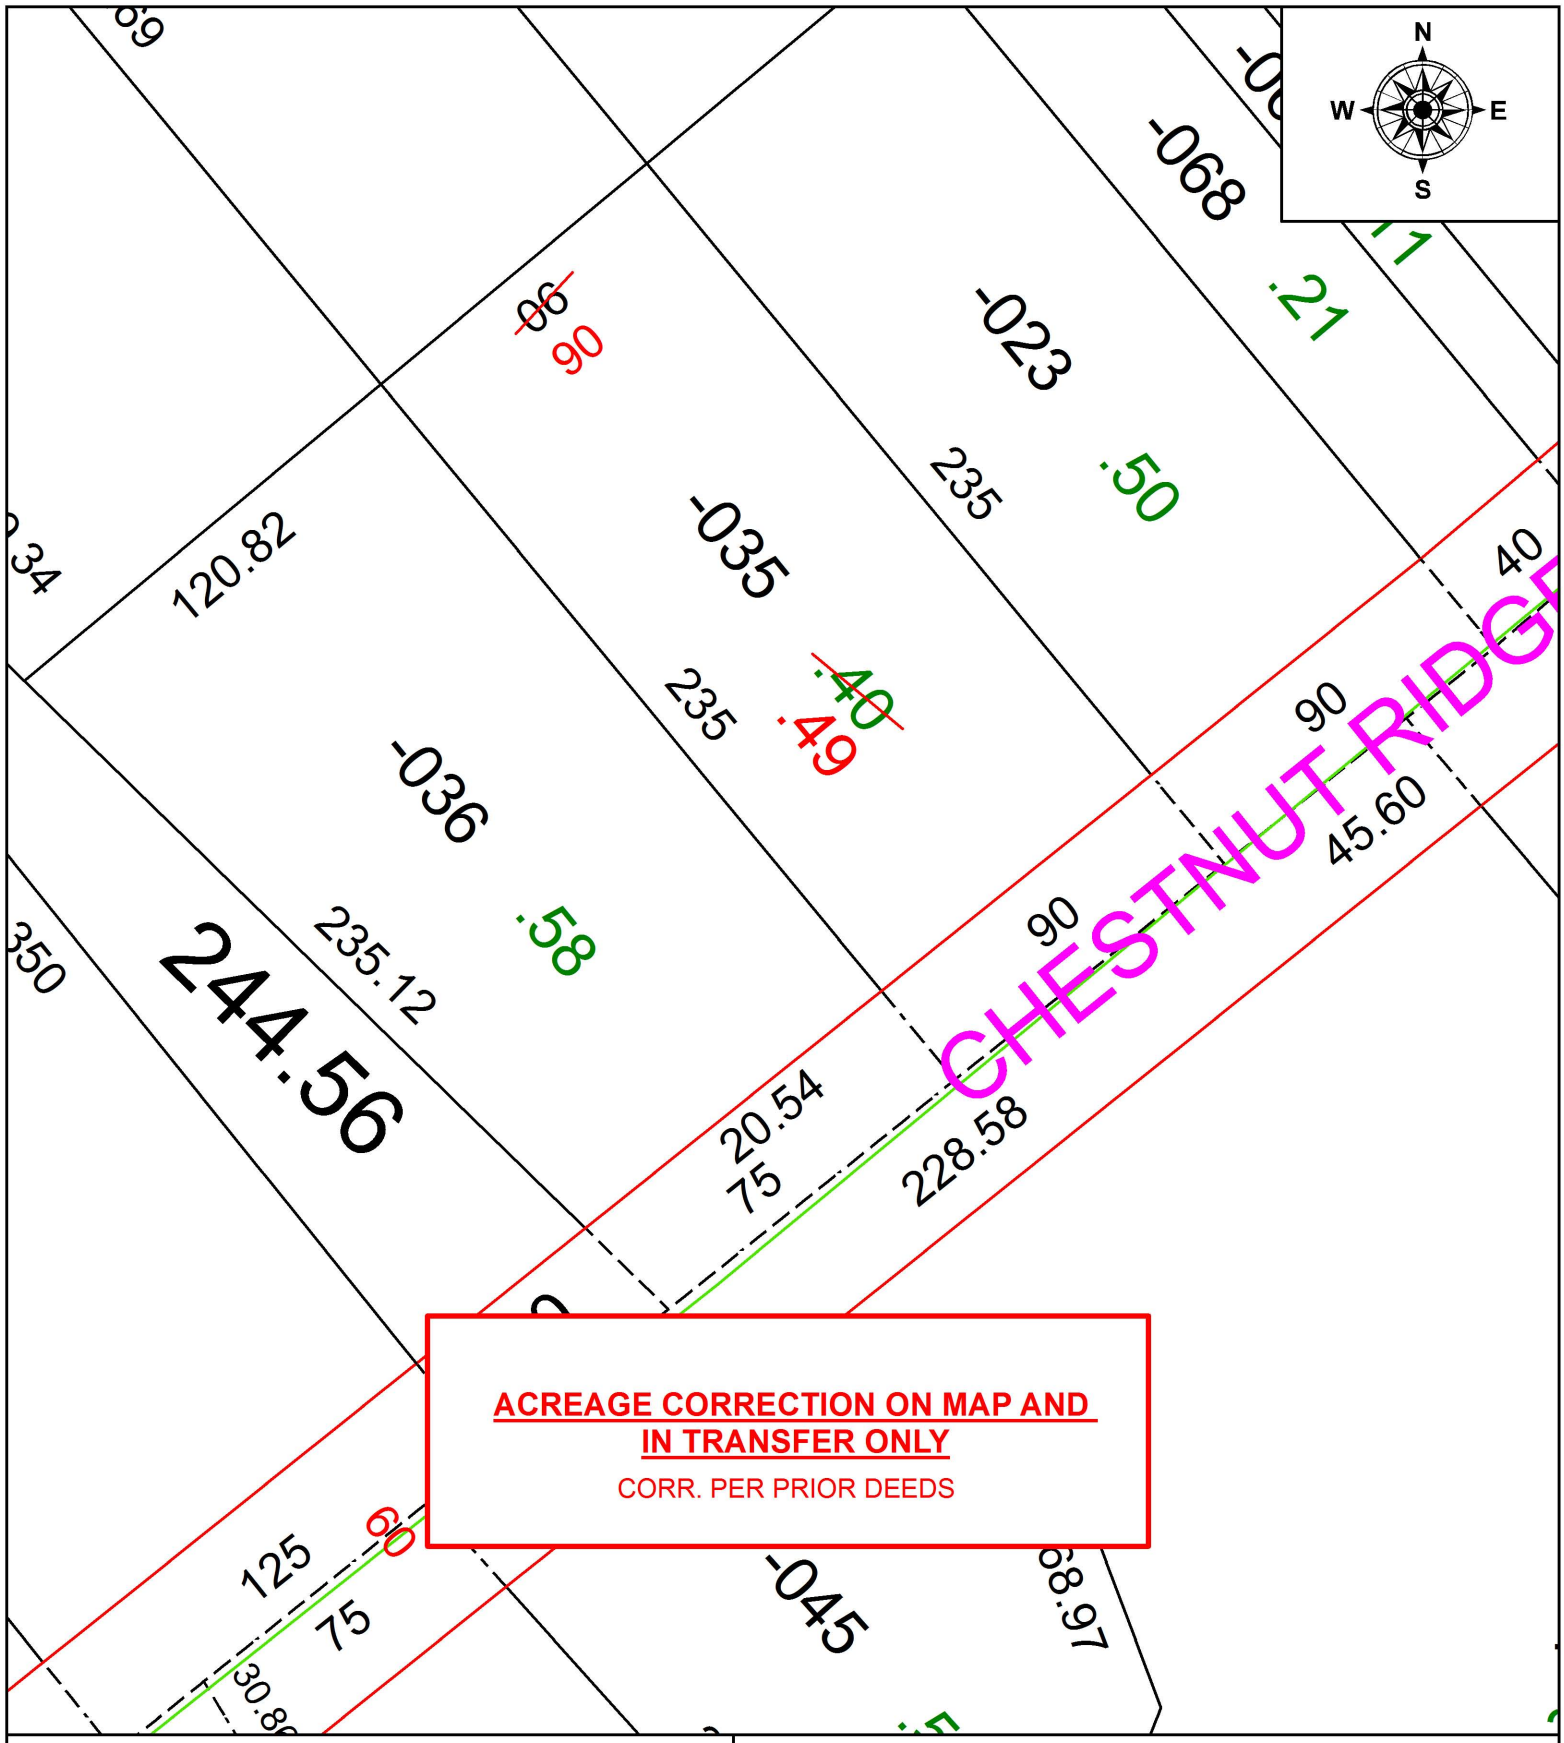

SPLITS/DEEDS PROCESSED

LORAIN COUNTY TAX MAP DEPARTMENT
226 MIDDLE AVE. ELYRIA, OH

SURVEYED BY: N/A
CLOSURE: 1: 2147483648
MAP PAGE(S): 7-00-025
APPOVED BY: RRM **DATE:** 10-12-17
SCALE: 1" = 50 **PRIOR INSTRUMENT:** 20140507760