PARENT PARCEL: 18-00-026-103-001, -022

CHILD PARCEL: 18-00-026-103-023 THRU -026

STARTING POINT: INTERSECTION OF C/L OF 4TH ST. AND C/L OF PROSPECT ST.

18-03787

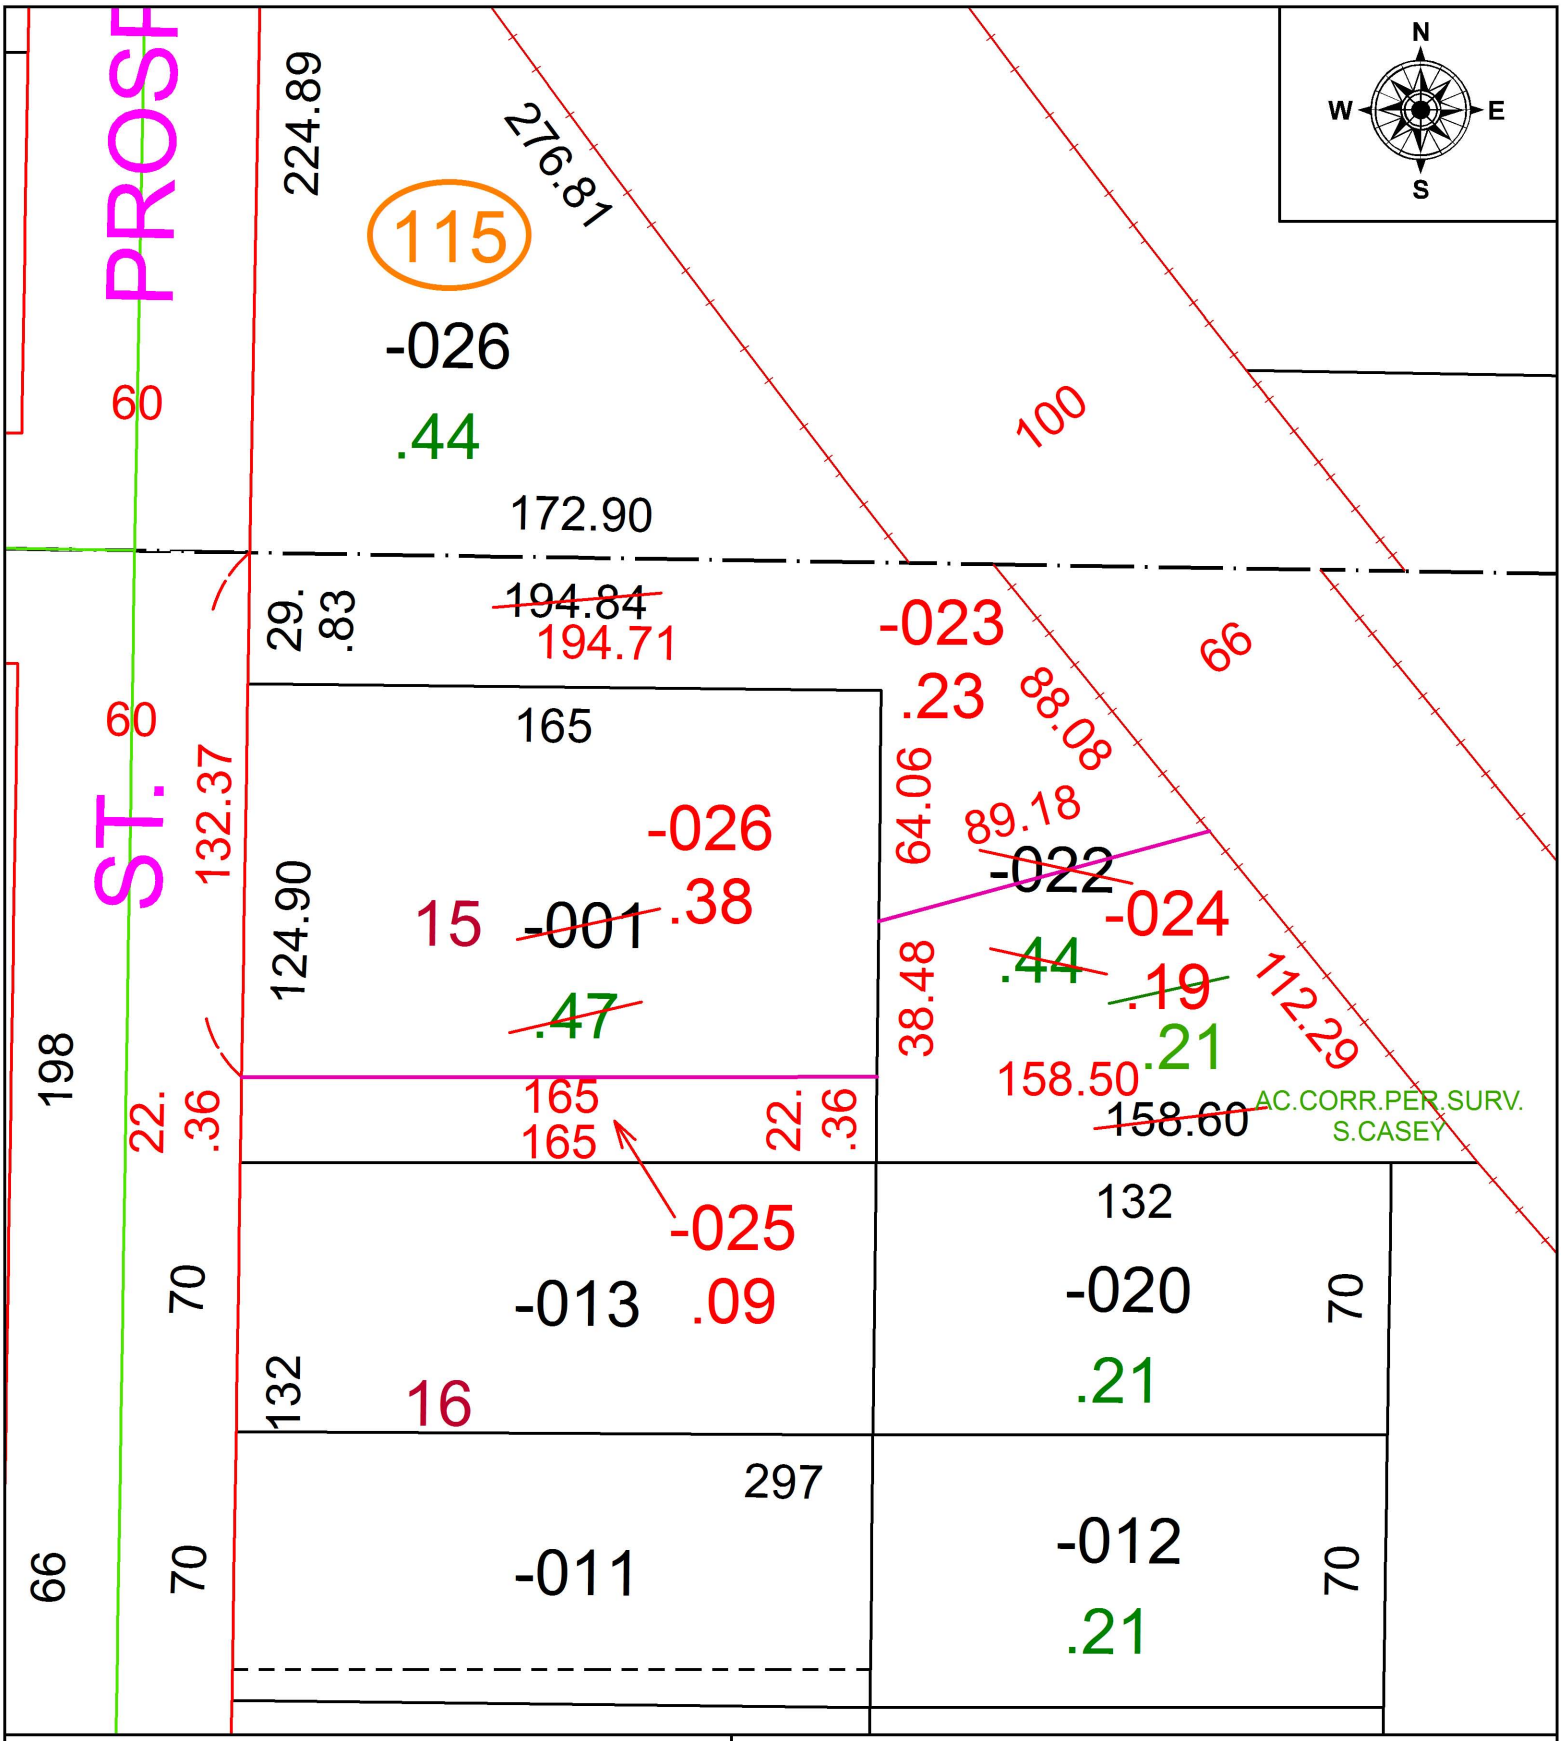

SPLITS/DEEDS PROCESSED

LORAIN COUNTY TAX MAP DEPARTMENT
226 MIDDLE AVE. ELYRIA, OH

SURVEYED BY: SCOTT J. CASEY
CLOSURE: 1: 347,992
MAP PAGE(S): 18-00-026
APPOVED BY: RRM **DATE:** 2-26-18
SCALE: 1" = 50 **PRIOR INSTRUMENT:** 20140511779