PARENT PARCEL: 19-06-111-000-030, 19-06-112-000-006,-010,-012

CHILD PARCEL: 19-06-111-000-030, 19-06-112-000-013

STARTING POINT: INTERSECTION OF C/L OF PECK WADSWORTH RD. AND C/L OF WHITEHEAD RD.

18-03790

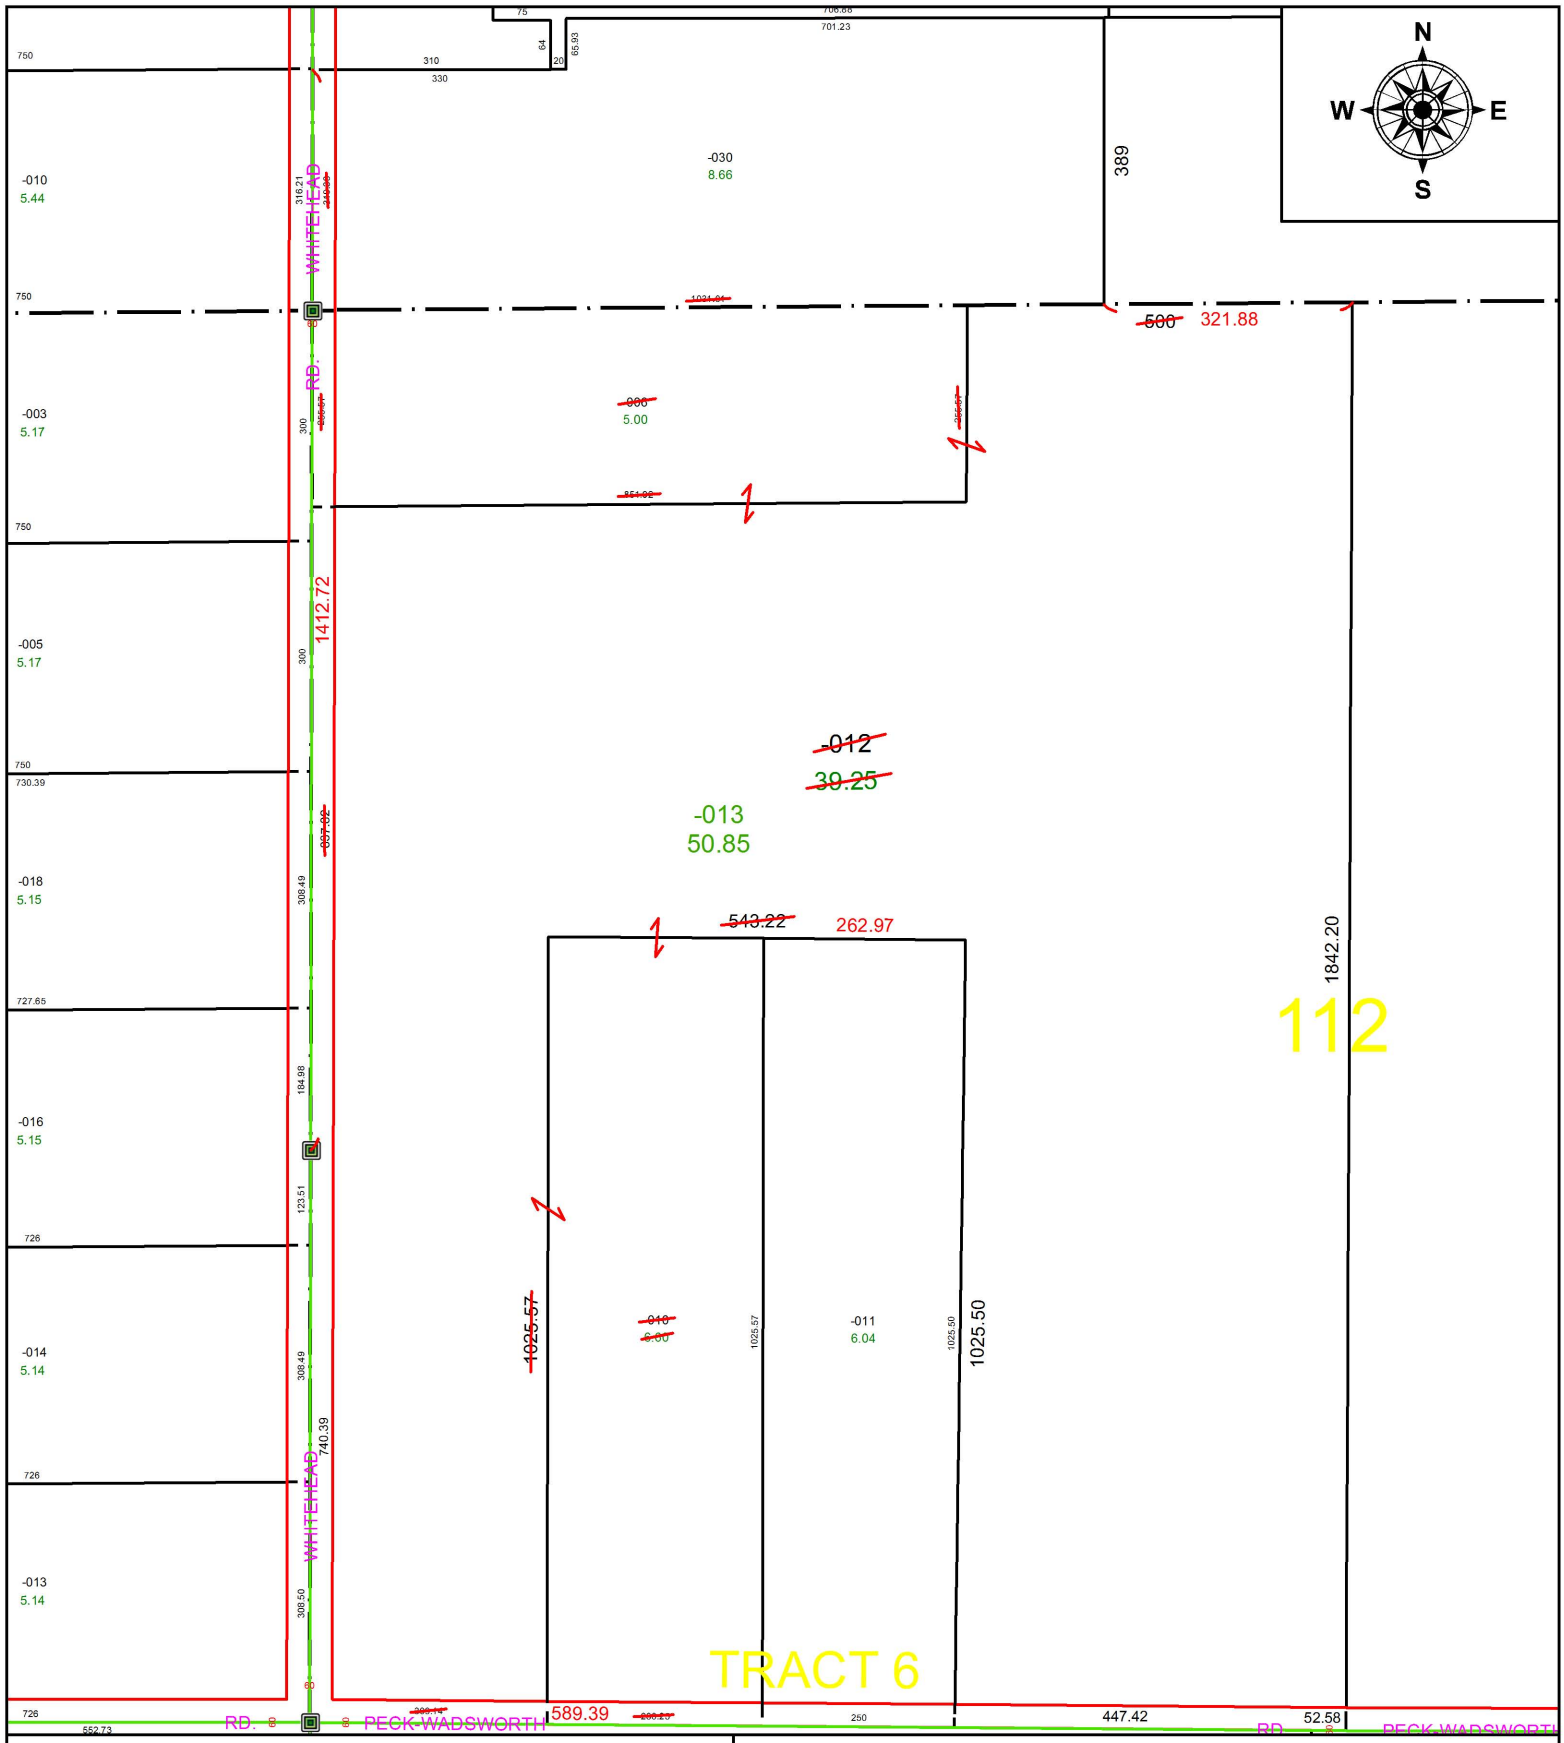

SPLITS/DEEDS PROCESSED

LORAIN COUNTY TAX MAP DEPARTMENT
226 MIDDLE AVE. ELYRIA, OH

SURVEYED BY: JOSEPH A. BURGOON
CLOSURE: 1: 782,441
MAP PAGE(S): 19-B
APPOVED BY: RRM **DATE:** 3-1-18
SCALE: 1" = 250 **PRIOR INSTRUMENT:** 20180660113