PARENT PARCEL: 10-00-006-119-030, -031

CHILD PARCEL: 10-00-006-119-048

STARTING POINT: NORTHEAST CORNER OF LAND CONVEYED TO LARRY H. & ARLENE R. ARCHER (DV 979/683)

17-03791-C

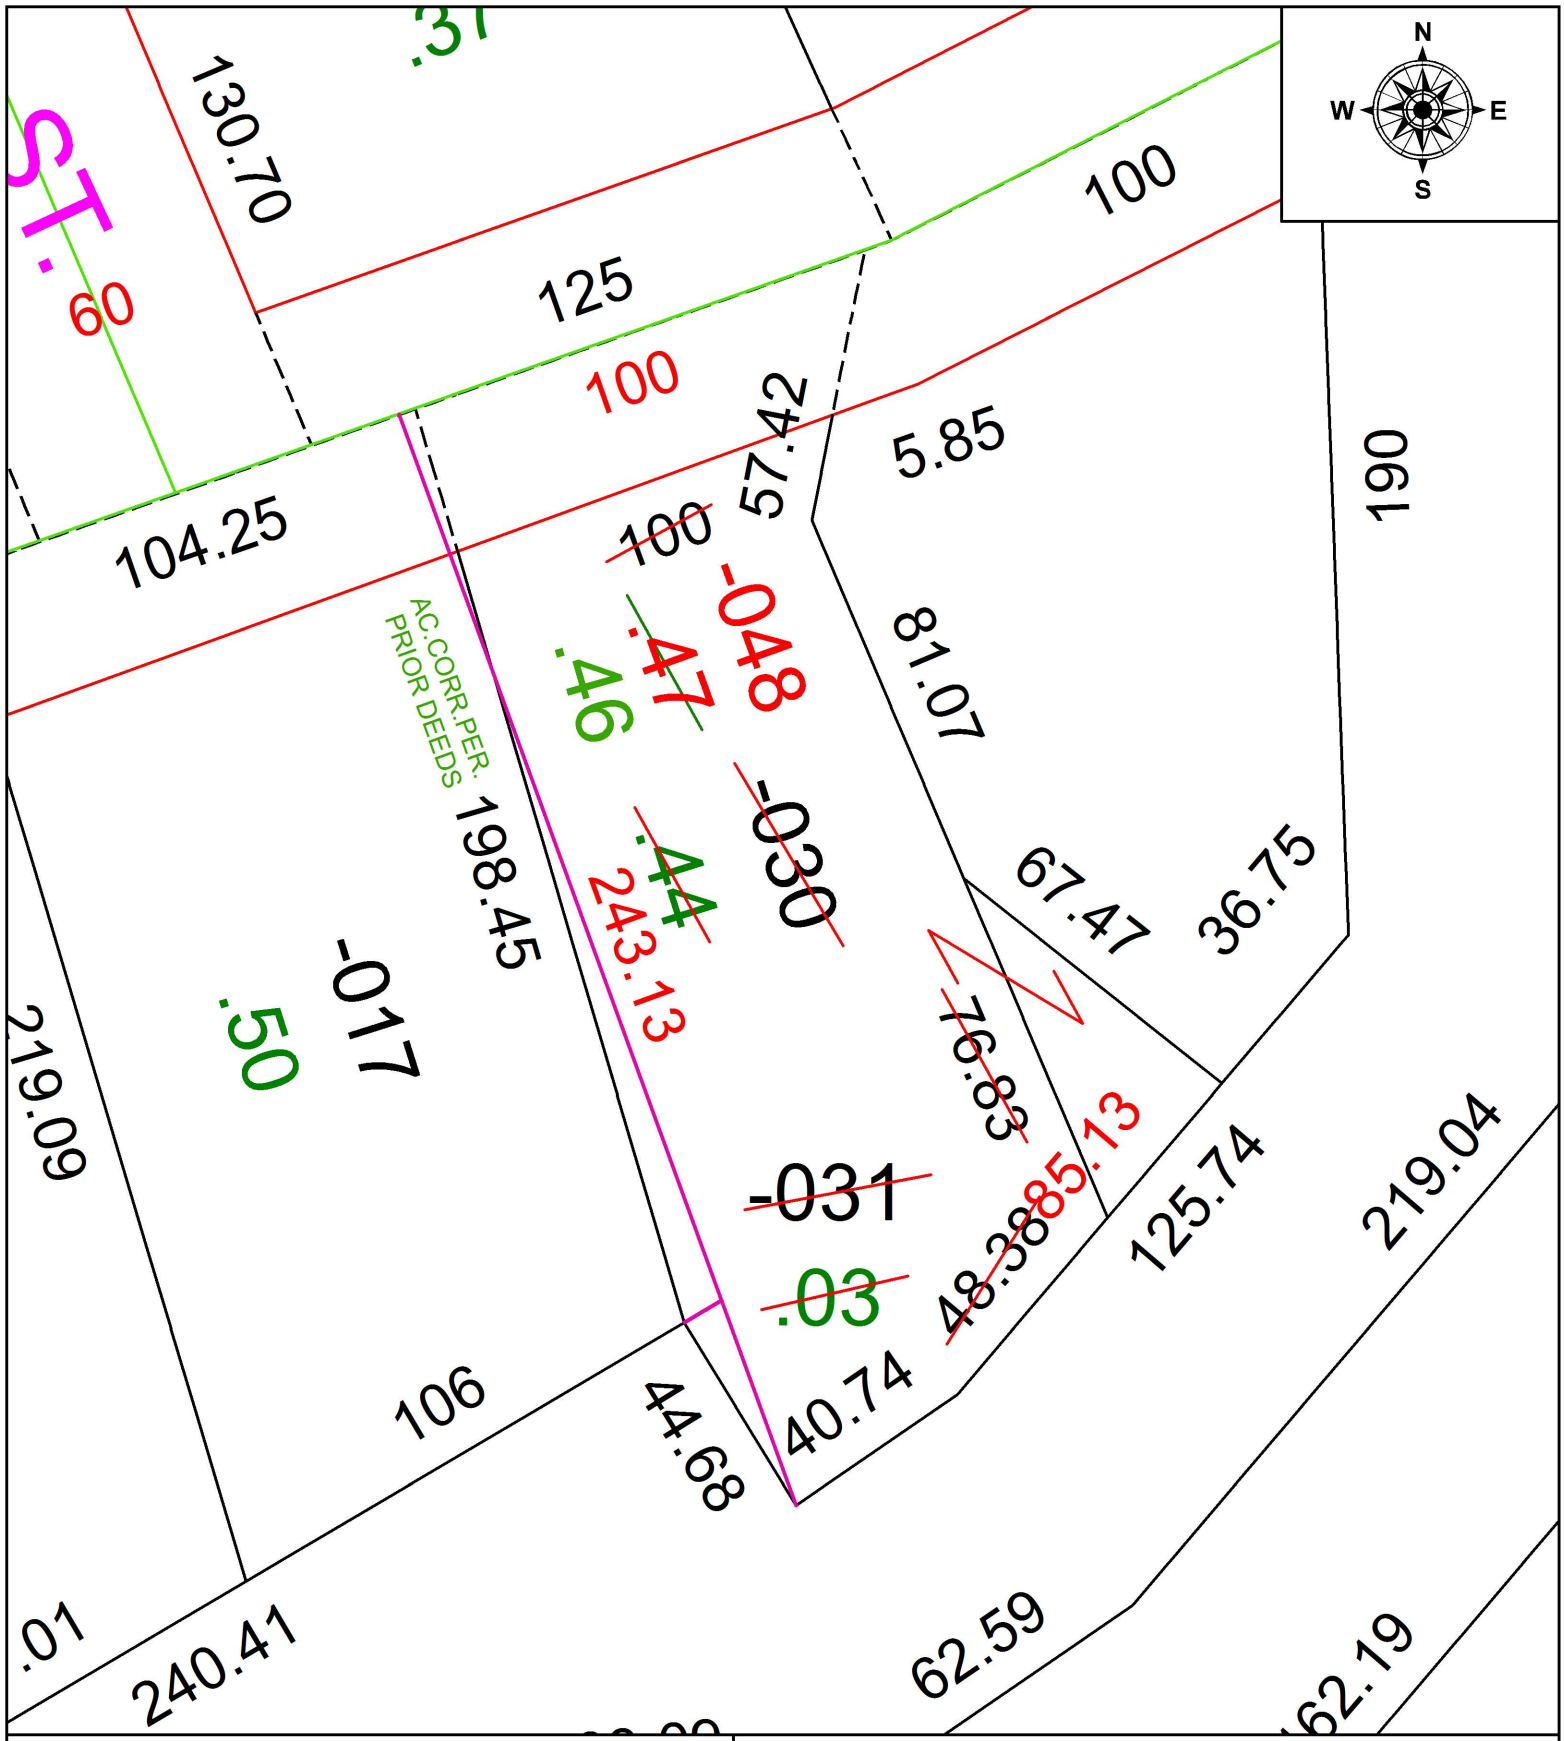

SPLITS/DEEDS PROCESSED

LORAIN COUNTY TAX MAP DEPARTMENT
226 MIDDLE AVE. ELYRIA, OH

SURVEYED BY: N/A
CLOSURE: 1: 251,468
MAP PAGE(S): 10-00-006
APPOVED BY: RRM **DATE:** 10-25-17
SCALE: 1" = 40 **PRIOR INSTRUMENT:** DV 1245/251