PARENT PARCEL: 01-00-039-000-058, 01-00-042-000-001

CHILD PARCEL: 01-00-039-000-067 THRU -069, 01-00-042-000-089

STARTING POINT: INTERSECTION OF C/L OF NORTH RIDGE RD. AND C/L OF BAUMHART RD.

18-03791

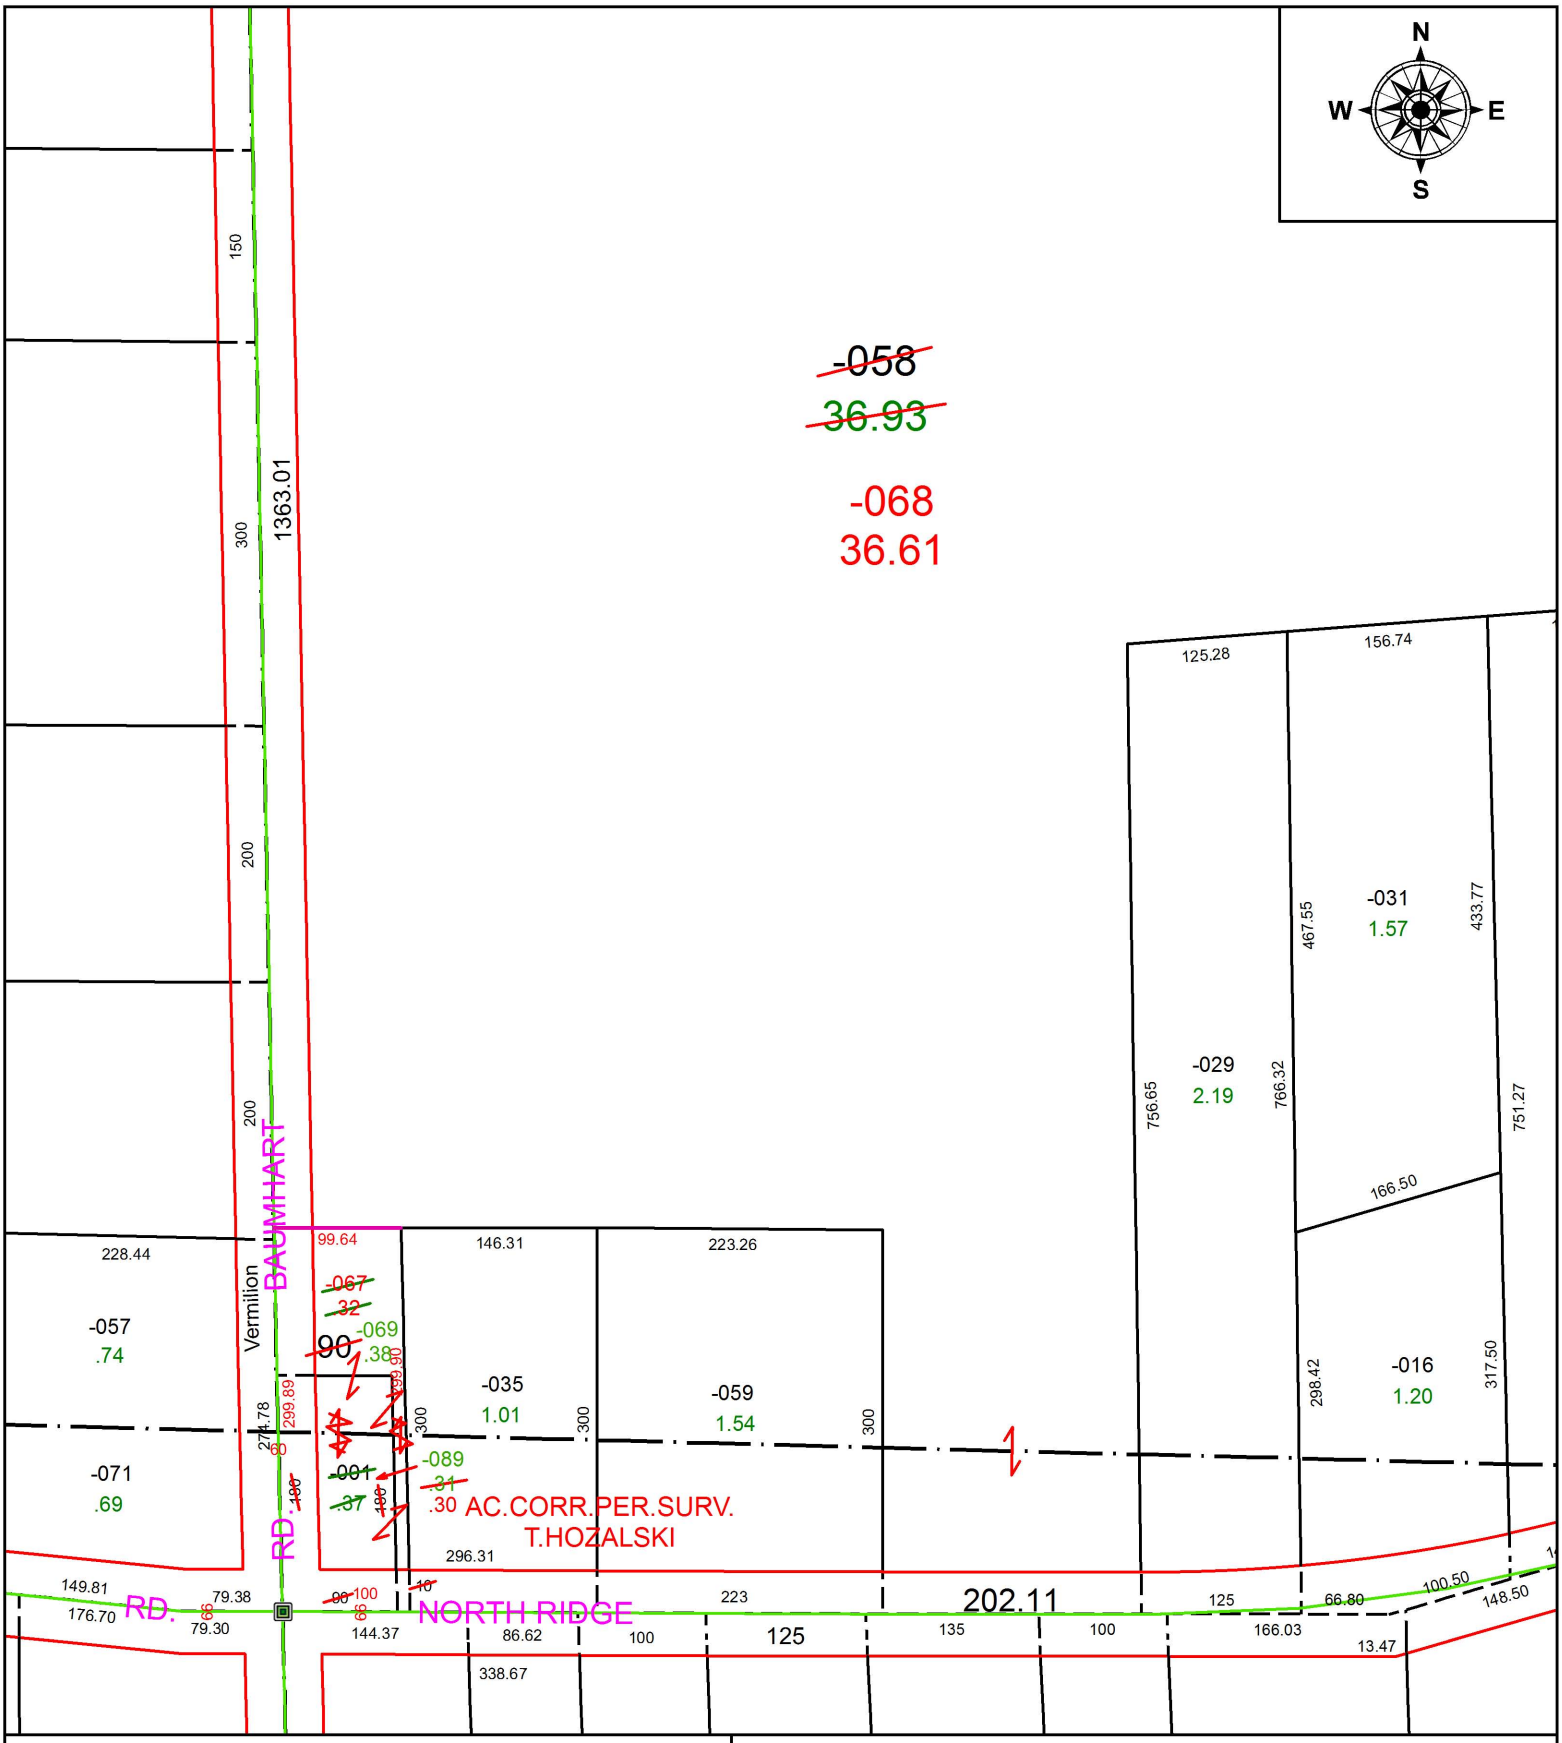

SPLITS/DEEDS PROCESSED

LORAIN COUNTY TAX MAP DEPARTMENT
226 MIDDLE AVE. ELYRIA, OH

SURVEYED BY: TIMOTHY D. HOZALSKI
CLOSURE: 1: 106,310
MAP PAGE(S): 1-00-039
APPOVED BY: RRM **DATE:** 2-28-18
SCALE: 1" = 150 **PRIOR INSTRUMENT:** 20170628005