PARENT PARCEL: 03-00-075-107-009
CHILD PARCEL: XX-XX-XXX-XXX-XXX
STARTING POINT:

17-03792-C

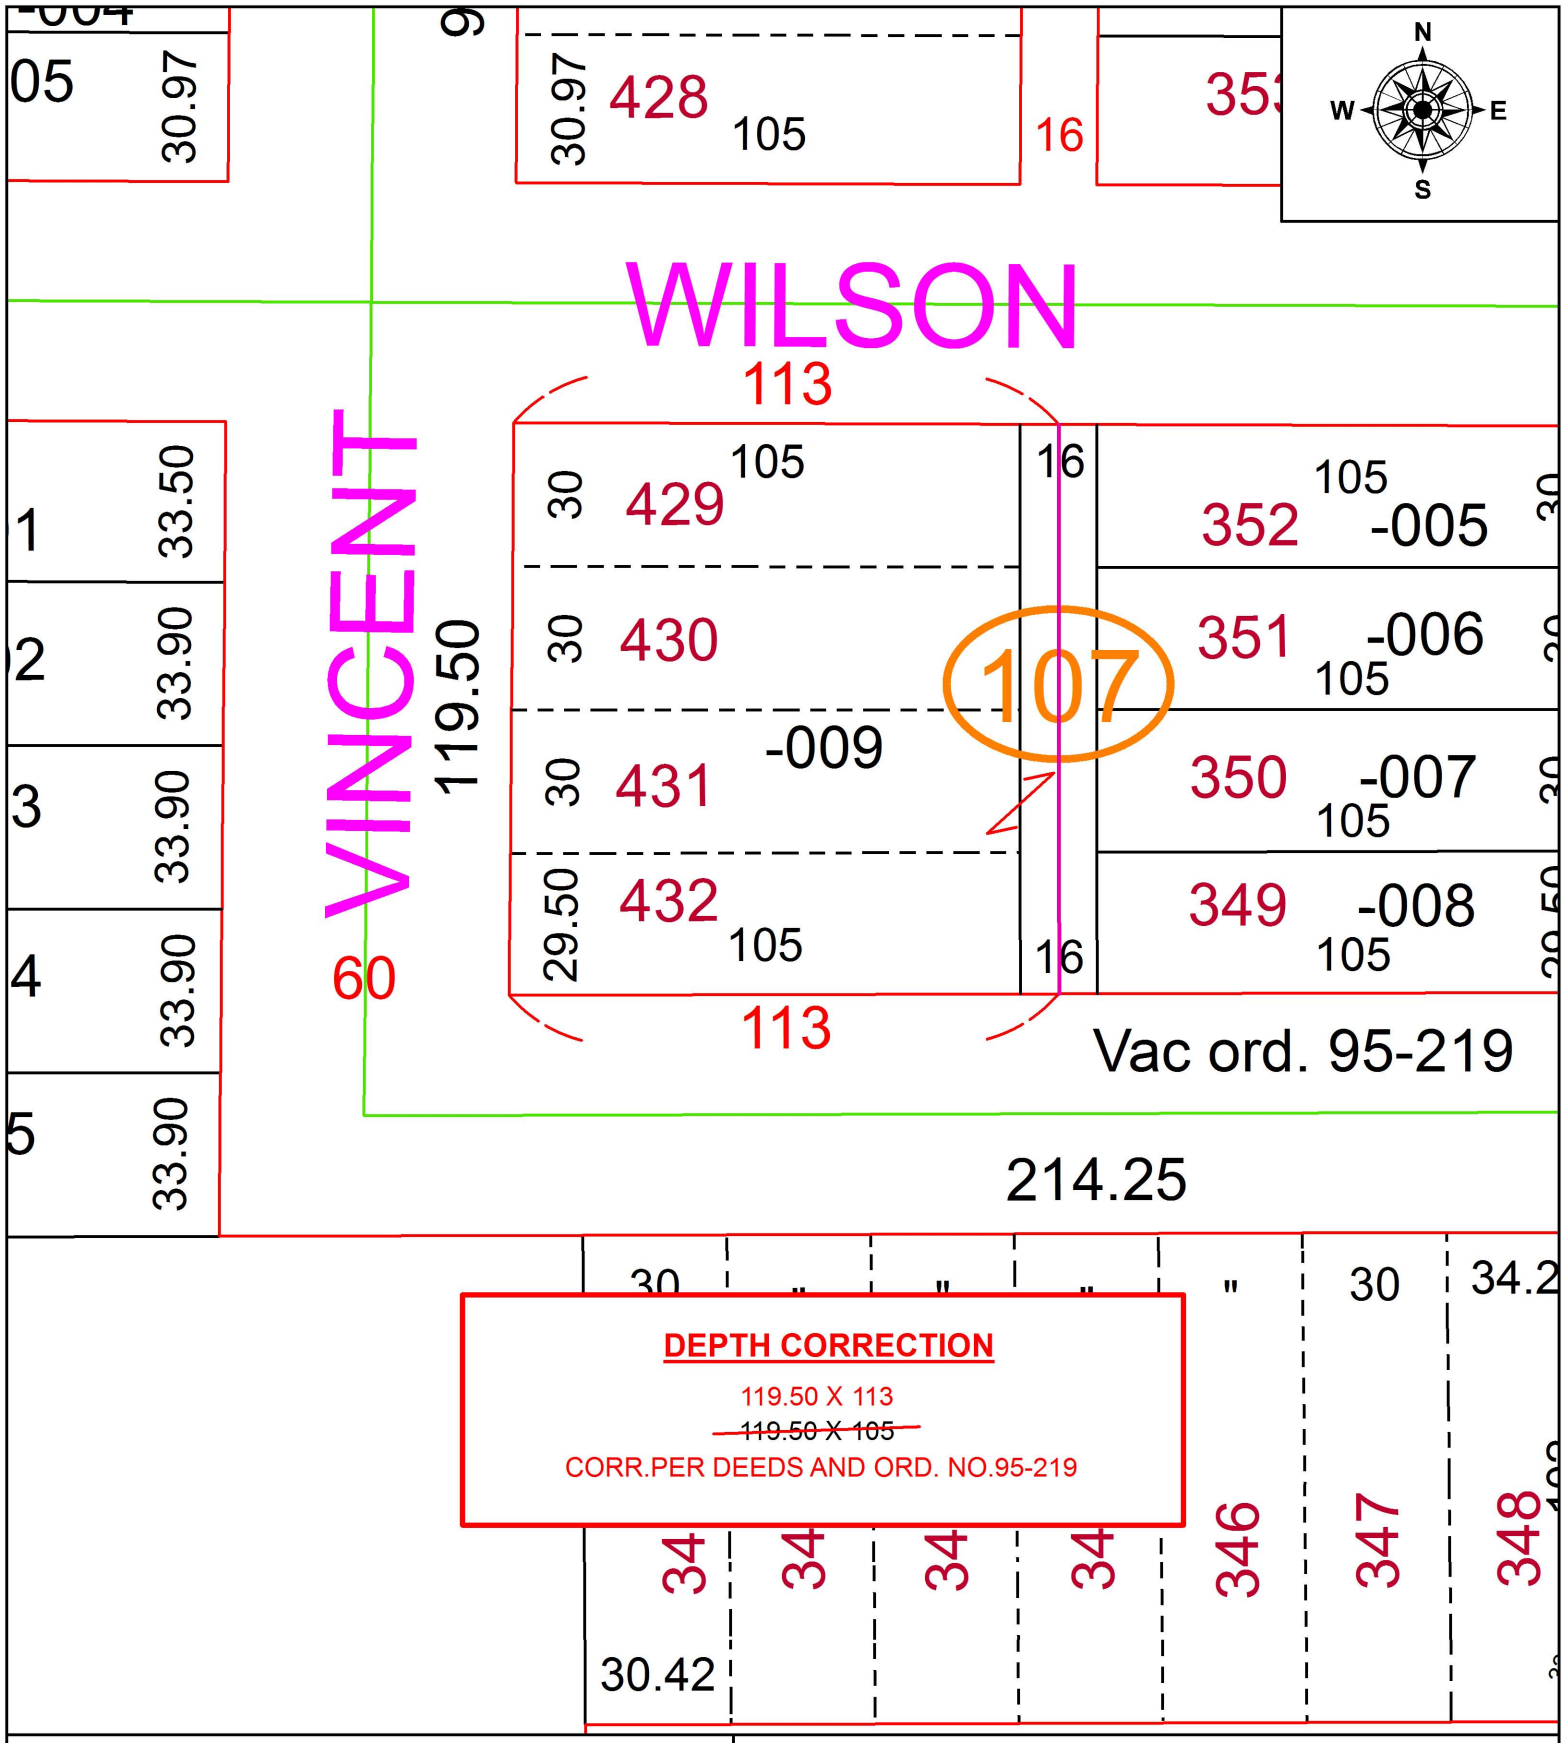

SPLITS/DEEDS PROCESSED
LORAIN COUNTY TAX MAP DEPARTMENT
226 MIDDLE AVE. ELYRIA, OH

SURVEYED BY: N/A
CLOSURE: N/A
MAP PAGE(S): 3-00-075
APPOVED BY: RRM DATE: 10-25-17
SCALE: 1" = 40 PRIOR INSTRUMENT: 20100343218