PARENT PARCEL: 04-00-019-143-049, -303
CHILD PARCEL: 04-00-019-143-496 THRU -500
STARTING POINT: INTERSECTION OF C/L OF JAYCOX RD. AND C/L OF WALKER RD.

18-03792

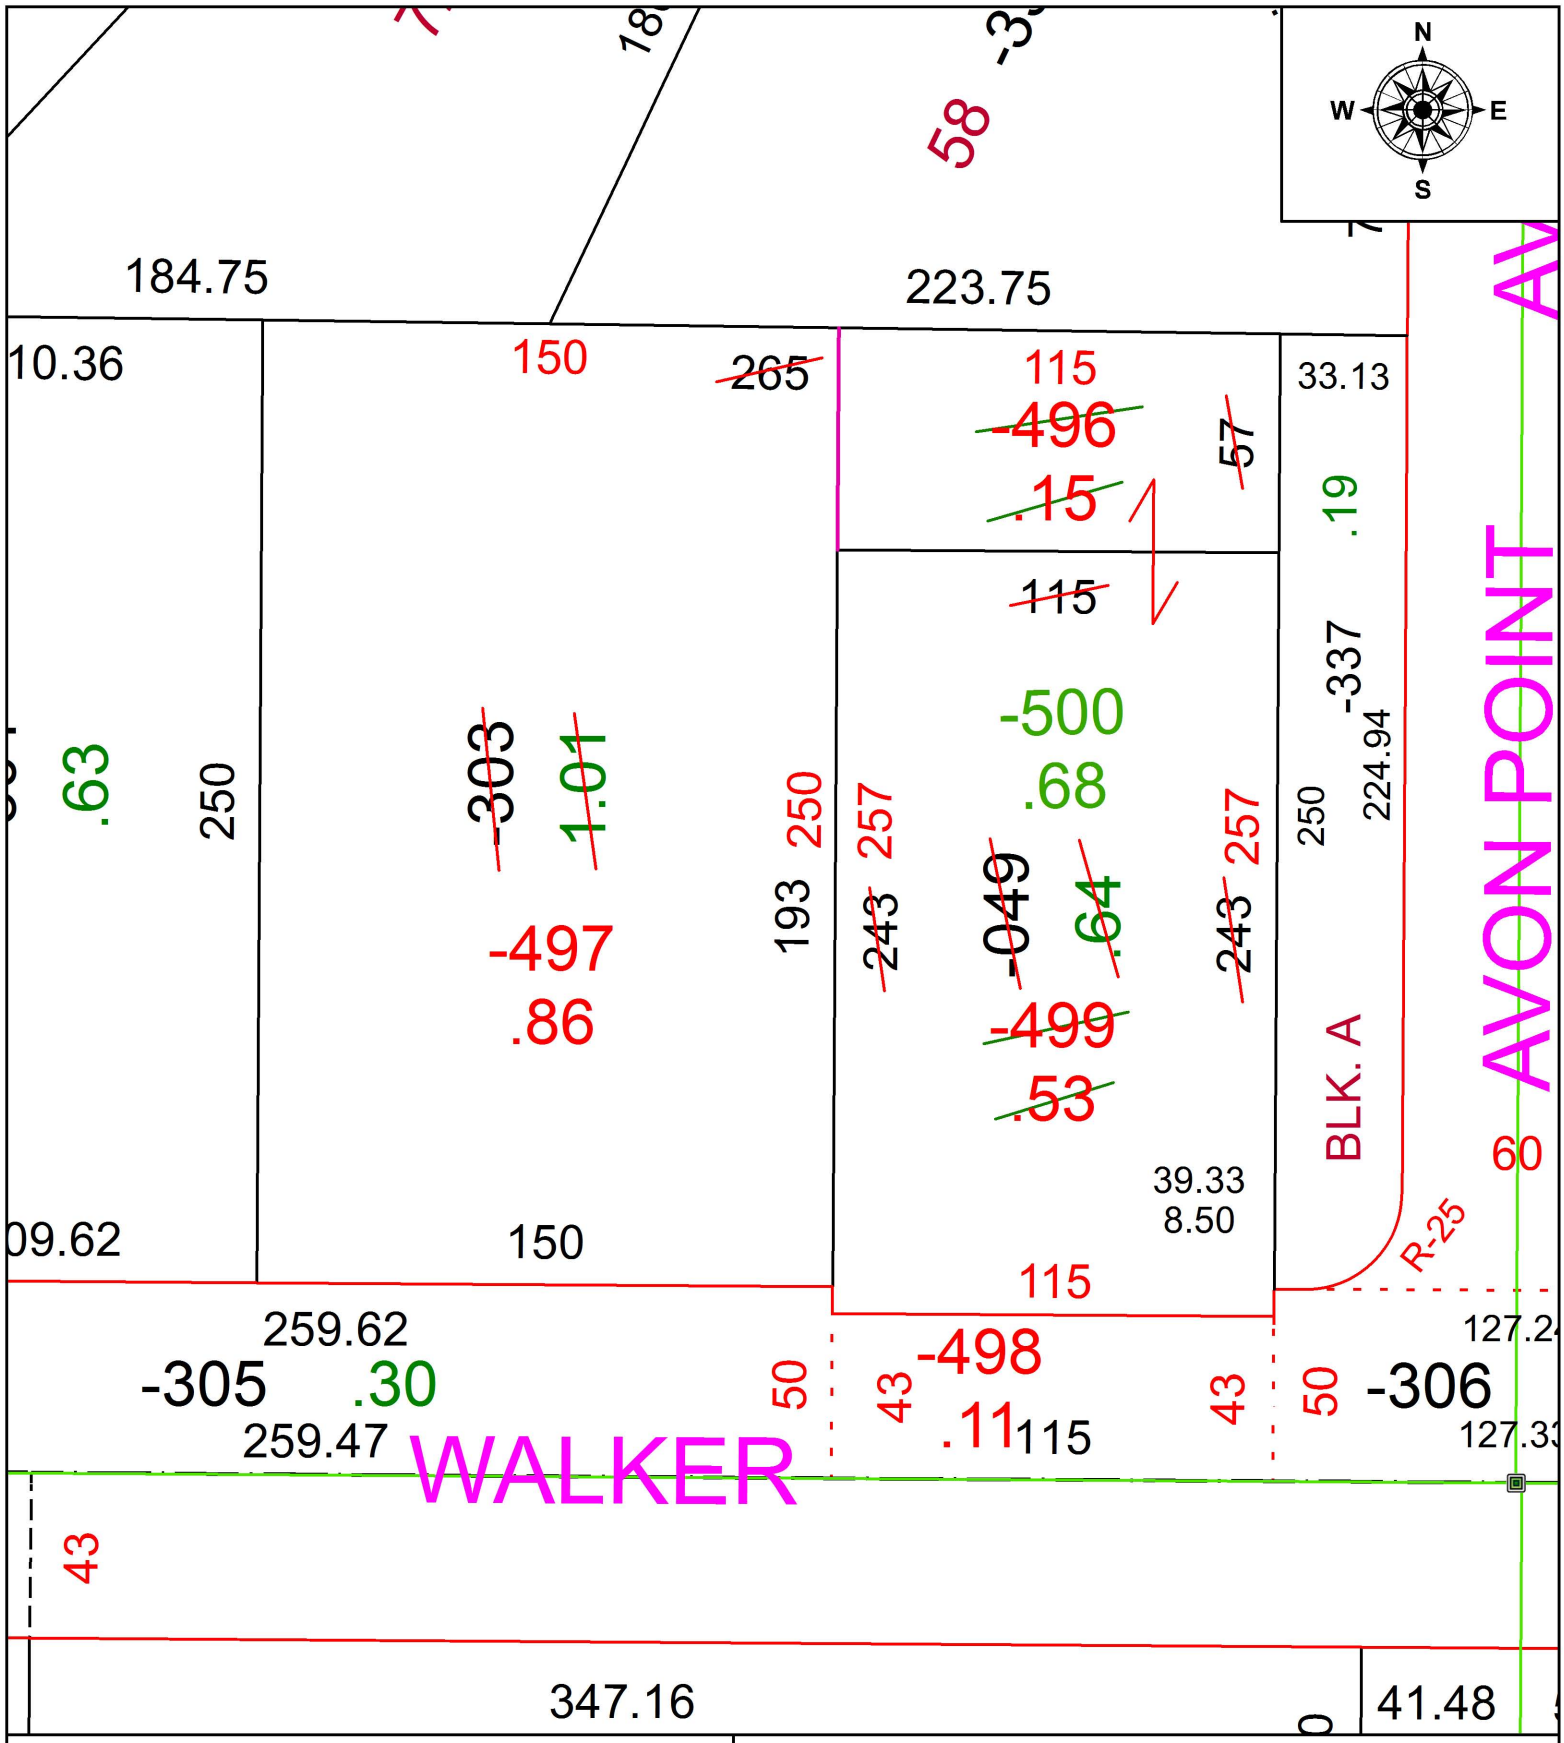

SPLITS/DEEDS PROCESSED
LORAIN COUNTY TAX MAP DEPARTMENT
226 MIDDLE AVE. ELYRIA, OH

SURVEYED BY: WILLIAM R. WALLACE
CLOSURE: 1: 2147483648
MAP PAGE(S): 4-00-019
APPOVED BY: RRM **DATE:** 3-14-18
SCALE: 1" = 50 **PRIOR INSTRUMENT:** OR 236/487