PARENT PARCEL: 06-25-064-000-003, -004

CHILD PARCEL: XX-XX-XXX-XXX-XXX

STARTING POINT: INTERSECTION OF WEST LINE OF O.L.64 AND NORTH LINE OF EAST BRIDGE ST.

17-03794-C

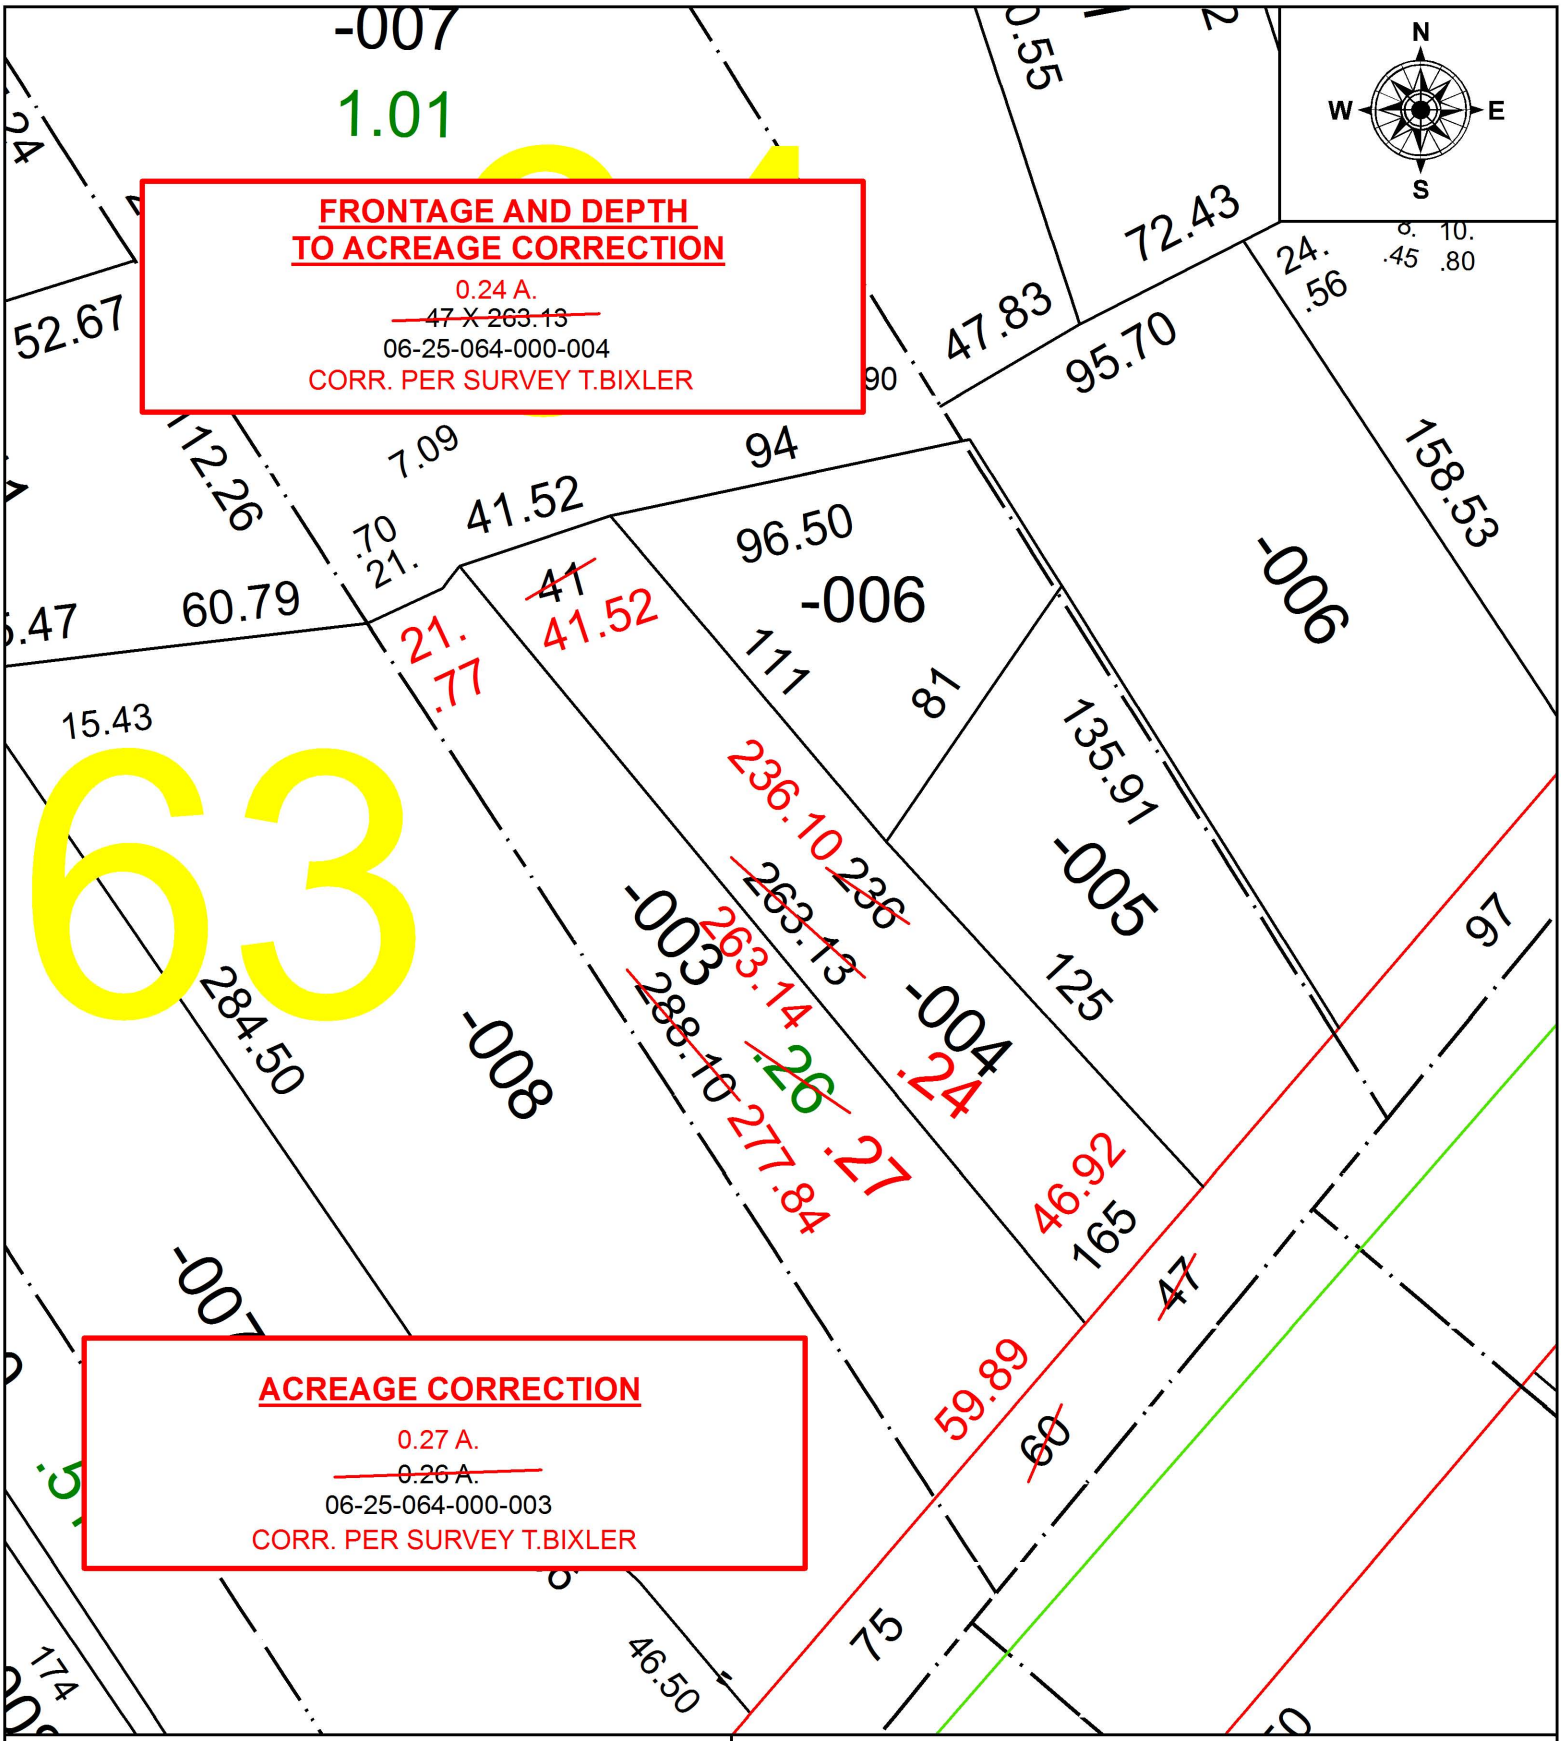

SPLITS/DEEDS PROCESSED

LORAIN COUNTY TAX MAP DEPARTMENT
226 MIDDLE AVE. ELYRIA, OH

SURVEYED BY: TREVOR A. BIXLER
CLOSURE: 1: 213,828
MAP PAGE(S): 6-103
APPOVED BY: RRM **DATE:** 10-31-17
SCALE: 1" = 50 **PRIOR INSTRUMENT:** 20170622596