PARENT PARCEL: 03-00-110-105-059

CHILD PARCEL: XX-XX-XXX-XXX-XXX

STARTING POINT: SOUTHEAST CORNER OF O.L.110

17-03795-C

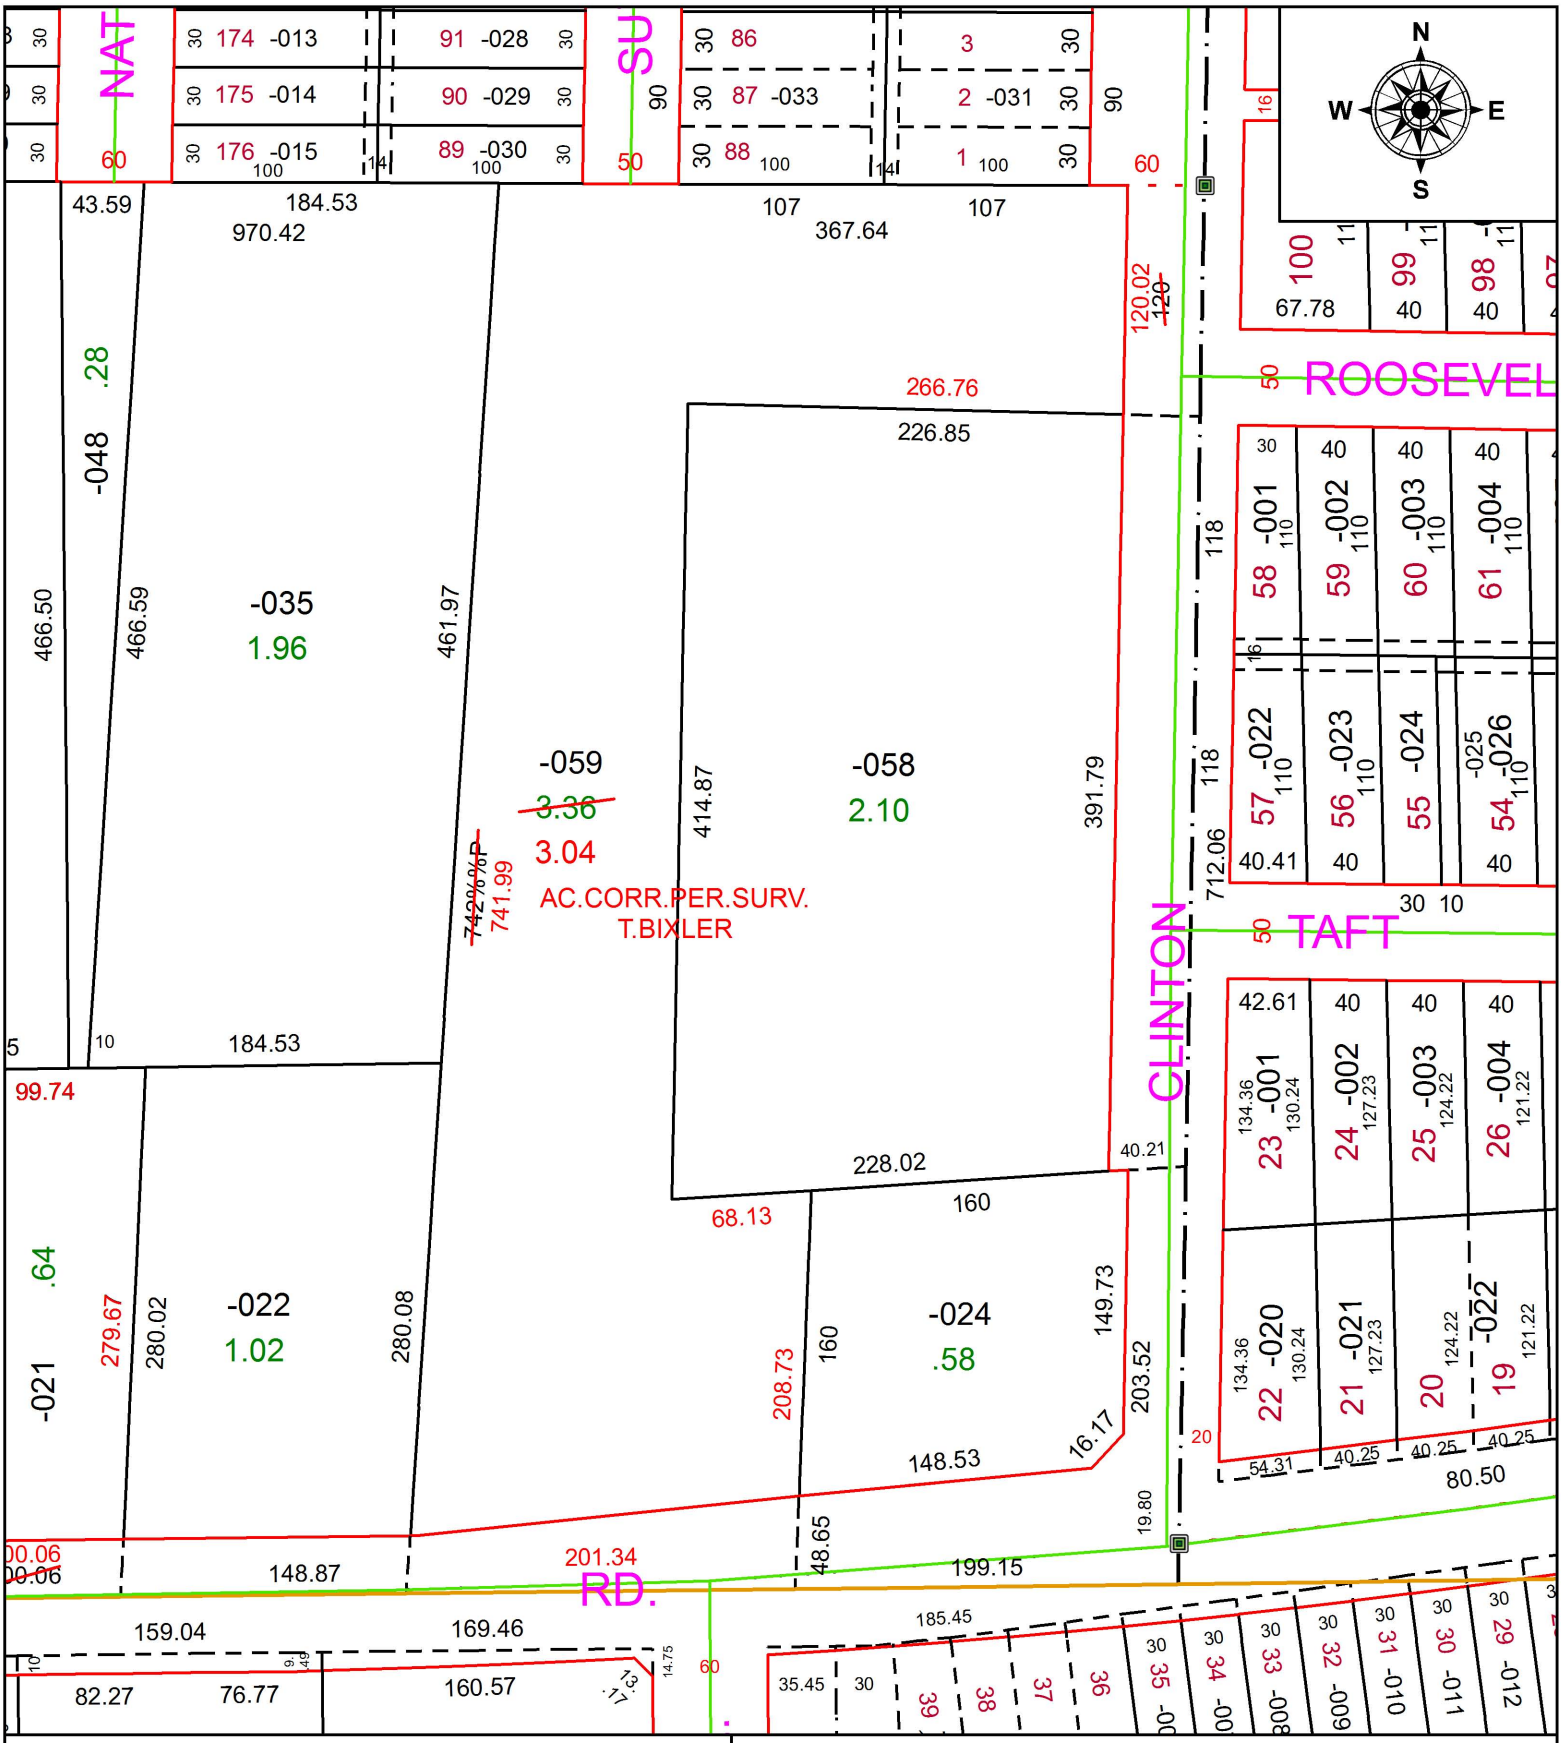
NAT
SU
ROOSEVEL
TAFT
CLINTON
RD.
N
S
E
W
-035
1.96
-059
3.36
3.04
AC.CORR.PER.SURV.
T.BIXLER
-058
2.10
-022
1.02
-024
.58
-021
.64
-048
.28
-013
-014
-015
-028
-029
-030
-033
-031
-001
-002
-003
-004
-022
-023
-024
-025
-026
-020
-021
-022
-001
-002
-003
-004
-010
-011
-012
-008
-009
-00
-00
-00