PARENT PARCEL: SEE SHEET ATTACHED

CHILD PARCEL: SEE SHEET ATTACHED

STARTING POINT: 1" I.P. MON. BOX, CL OF ISLAND RD. & S.E. CORNER OF O.L. 37

18-03797

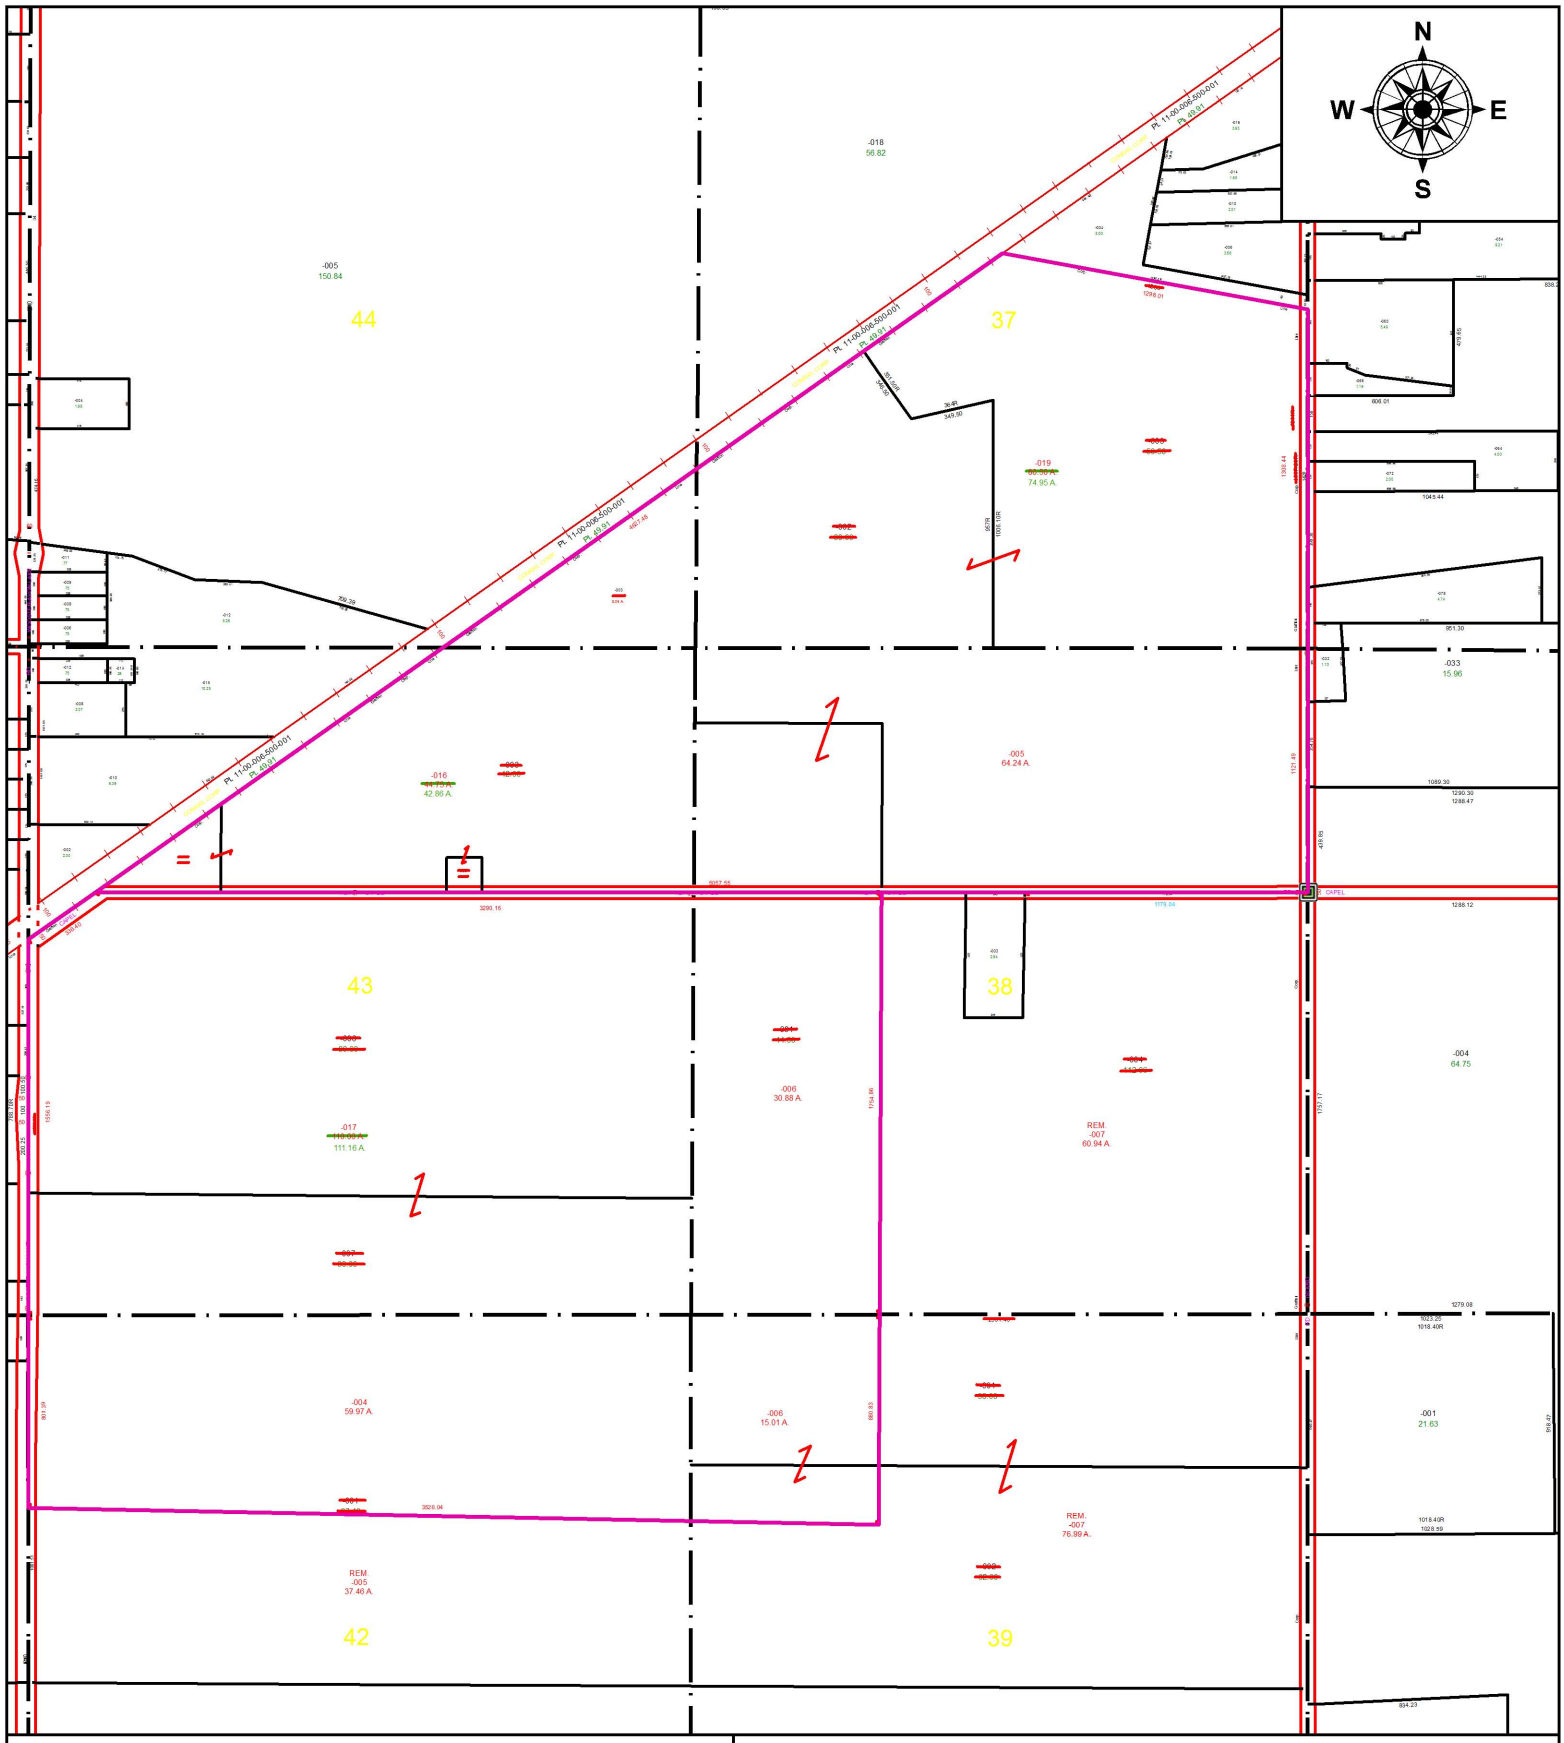

SPLITS/DEEDS PROCESSED

LORAIN COUNTY TAX MAP DEPARTMENT
226 MIDDLE AVE. ELYRIA, OH

SURVEYED BY: KEVIN CANAVAN
CLOSURE: 1: 33,000
MAP PAGE(S): 11-00-037 , -038, -039, -042, -043, -044
APPOVED BY: TJS **DATE:** 5/22/18
SCALE: 1" = 800 **PRIOR INSTRUMENT:** DV 186/372