PARENT PARCEL: 09-00-004-101-030
CHILD PARCEL: 09-00-004-101-060, -061
STARTING POINT: SOUTHEAST CORNER OF LAND CONVEYED TO FRANK A. & ANGNES MANARY (DV 269/65)

17-03798-U

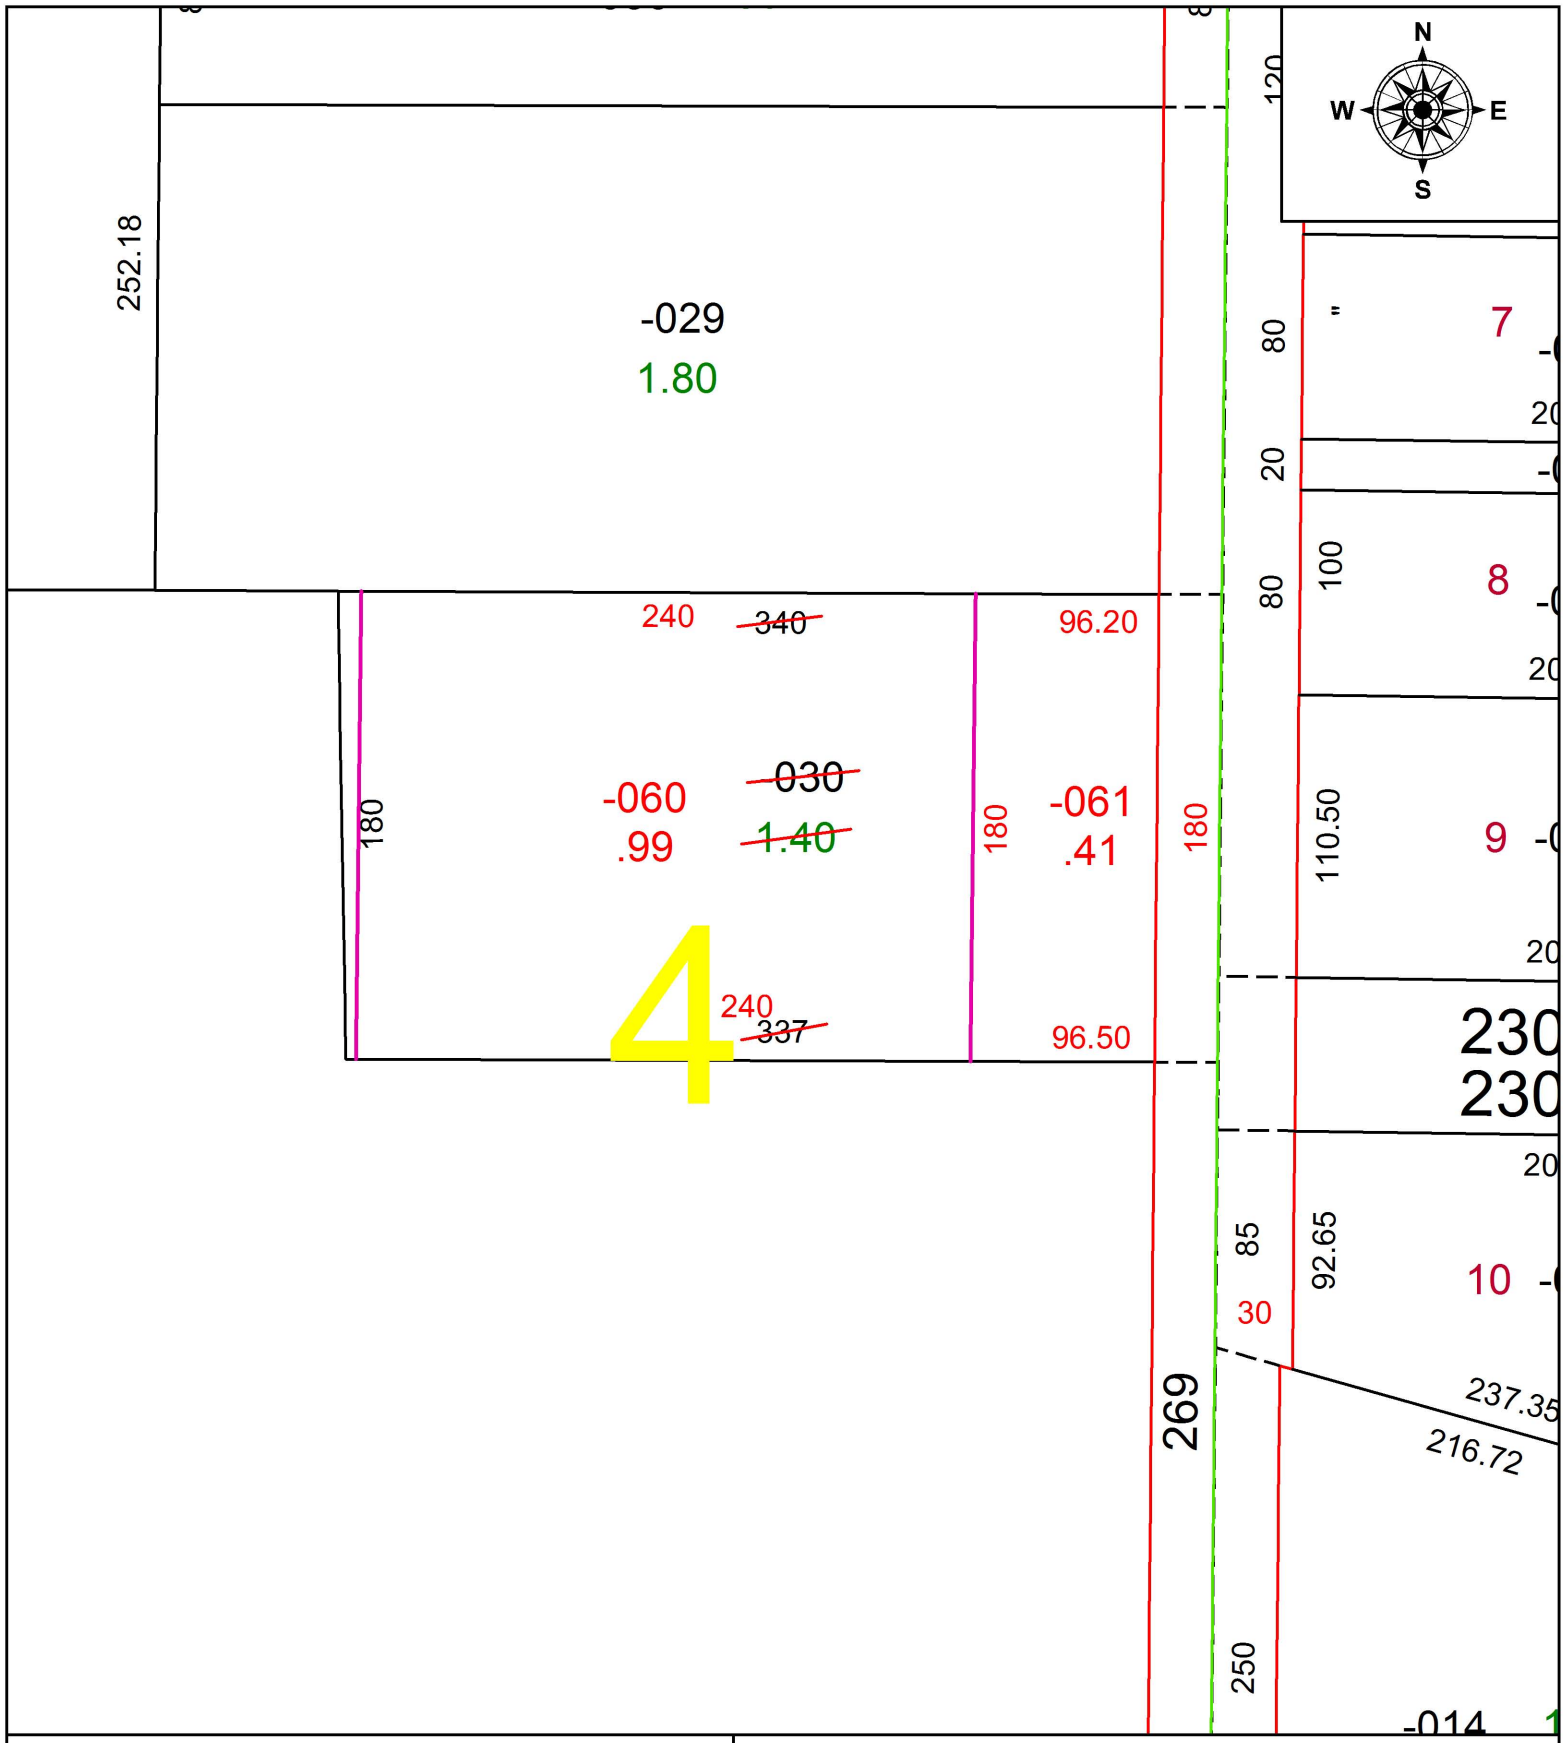

SPLITS/DEEDS PROCESSED
LORAIN COUNTY TAX MAP DEPARTMENT
226 MIDDLE AVE. ELYRIA, OH

SURVEYED BY: N/A
CLOSURE: 1: 2147483648
MAP PAGE(S): 9-00-004
APPOVED BY: RRM **DATE:** 11-2-17
SCALE: 1" = 75 **PRIOR INSTRUMENT:** OR 1242/780