PARENT PARCEL: 07-00-011-103-080, -087

CHILD PARCEL: 07-00-011-103-185

STARTING POINT: INTERSECTION OF C/L OF WOODBRIDGE CT. AND C/L OF BAGLEY RD.

18-03798

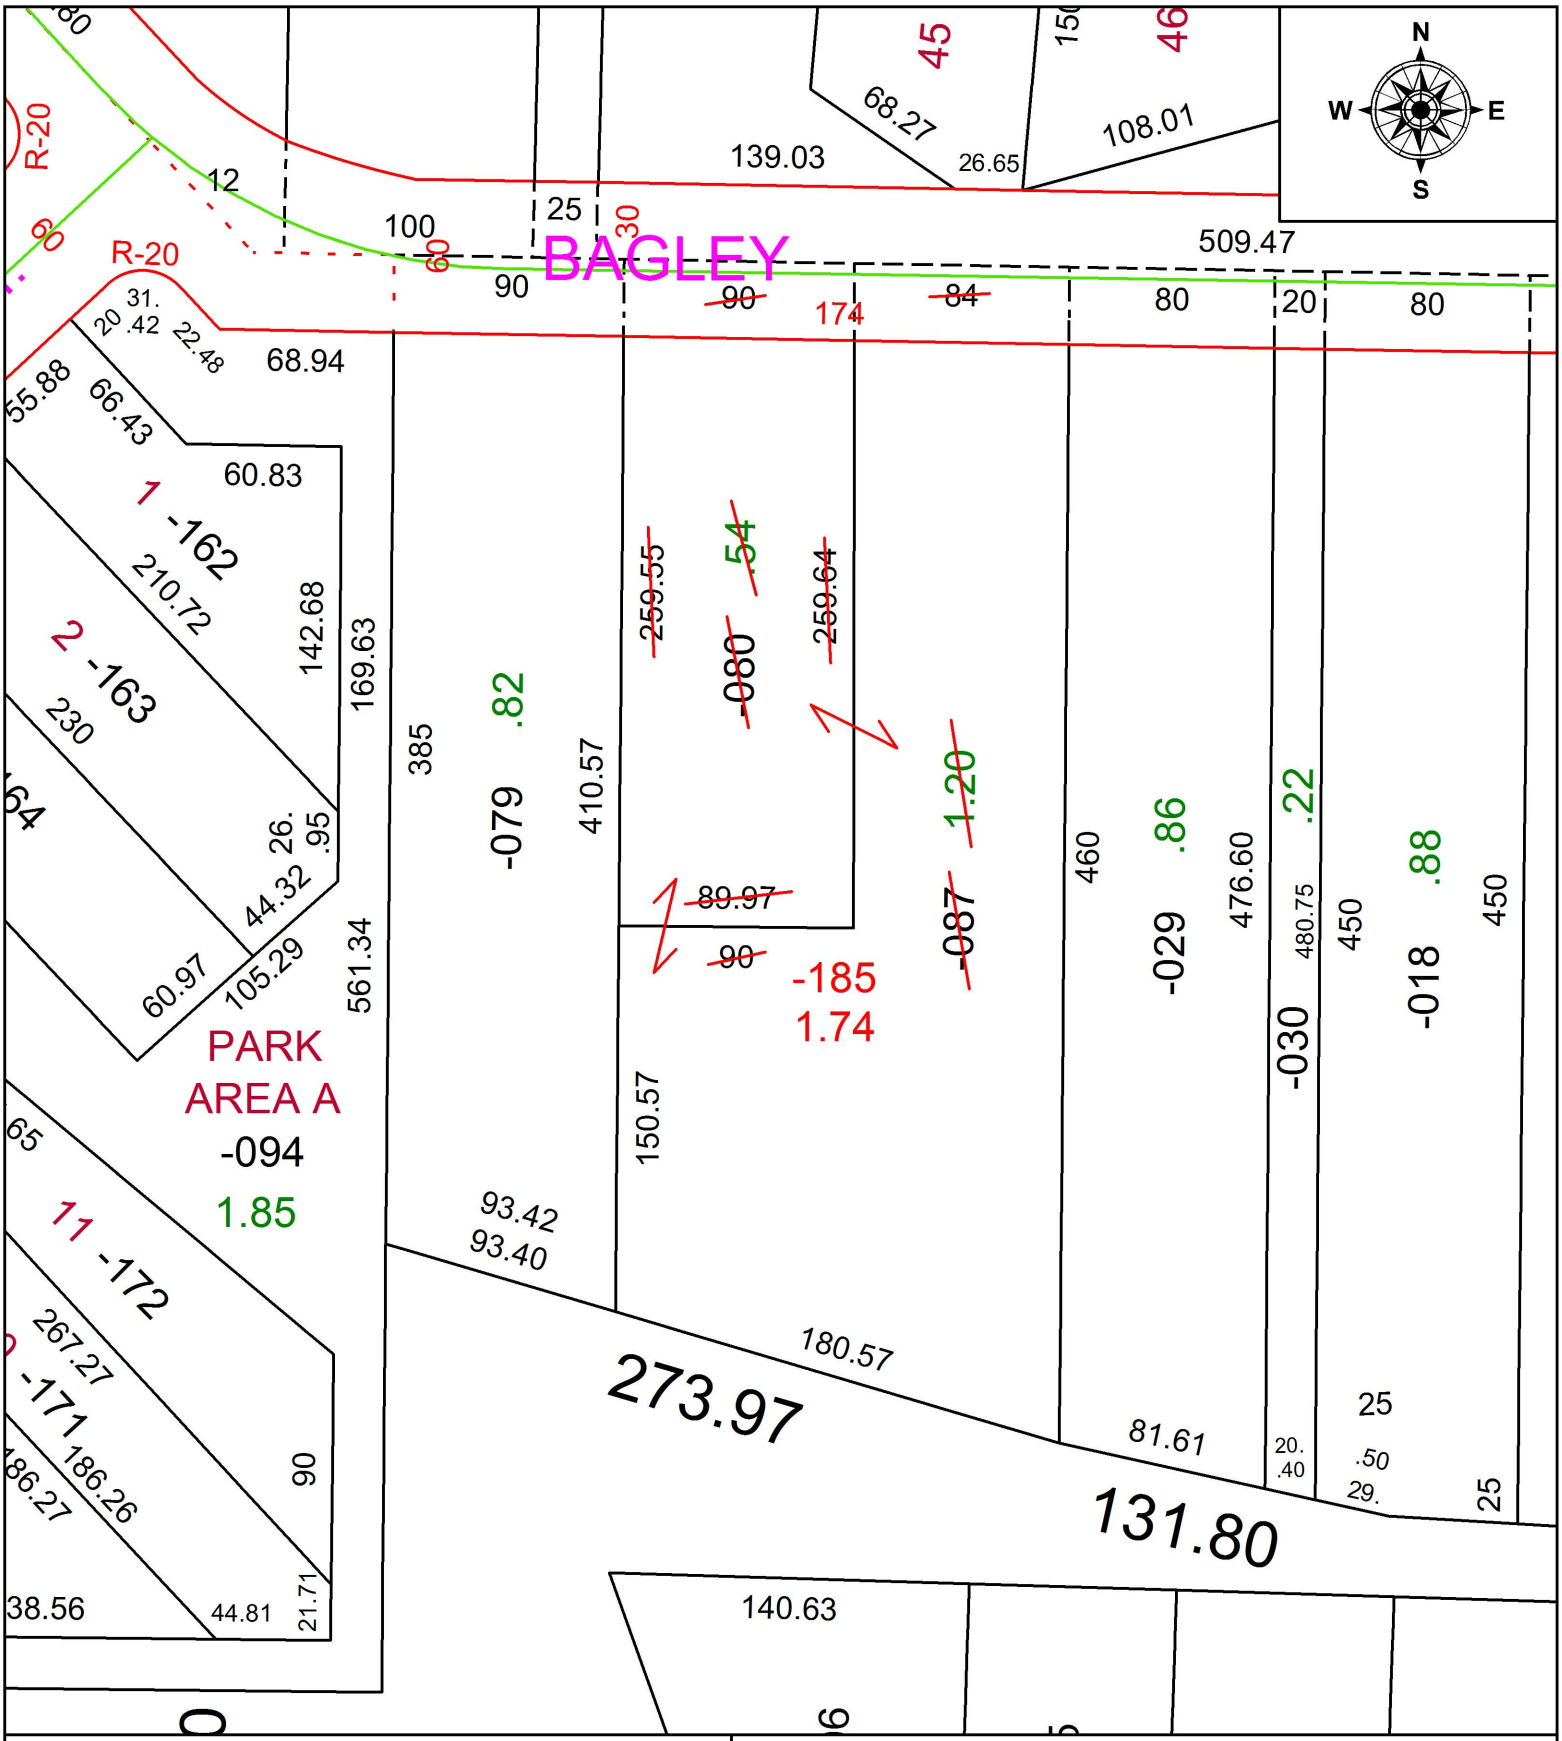

SPLITS/DEEDS PROCESSED

LORAIN COUNTY TAX MAP DEPARTMENT
226 MIDDLE AVE. ELYRIA, OH

SURVEYED BY: WILFREDO BARBOSA
CLOSURE: 1: 147,355
MAP PAGE(S): 7-00-011
APPOVED BY: RRM **DATE:** 3-30-18
SCALE: 1" = 75 **PRIOR INSTRUMENT:** 20170640061