PARENT PARCEL: 01-00-068-000-009, 01-00-076-000-001, 01-00-077-000-002

CHILD PARCEL: XX-XX-XXX-XXX-XXX

STARTING POINT: INTERSECTION OF C/L OF PEASLEY RD. AND SOUTH LINE OF O.L.68

17-03800-C

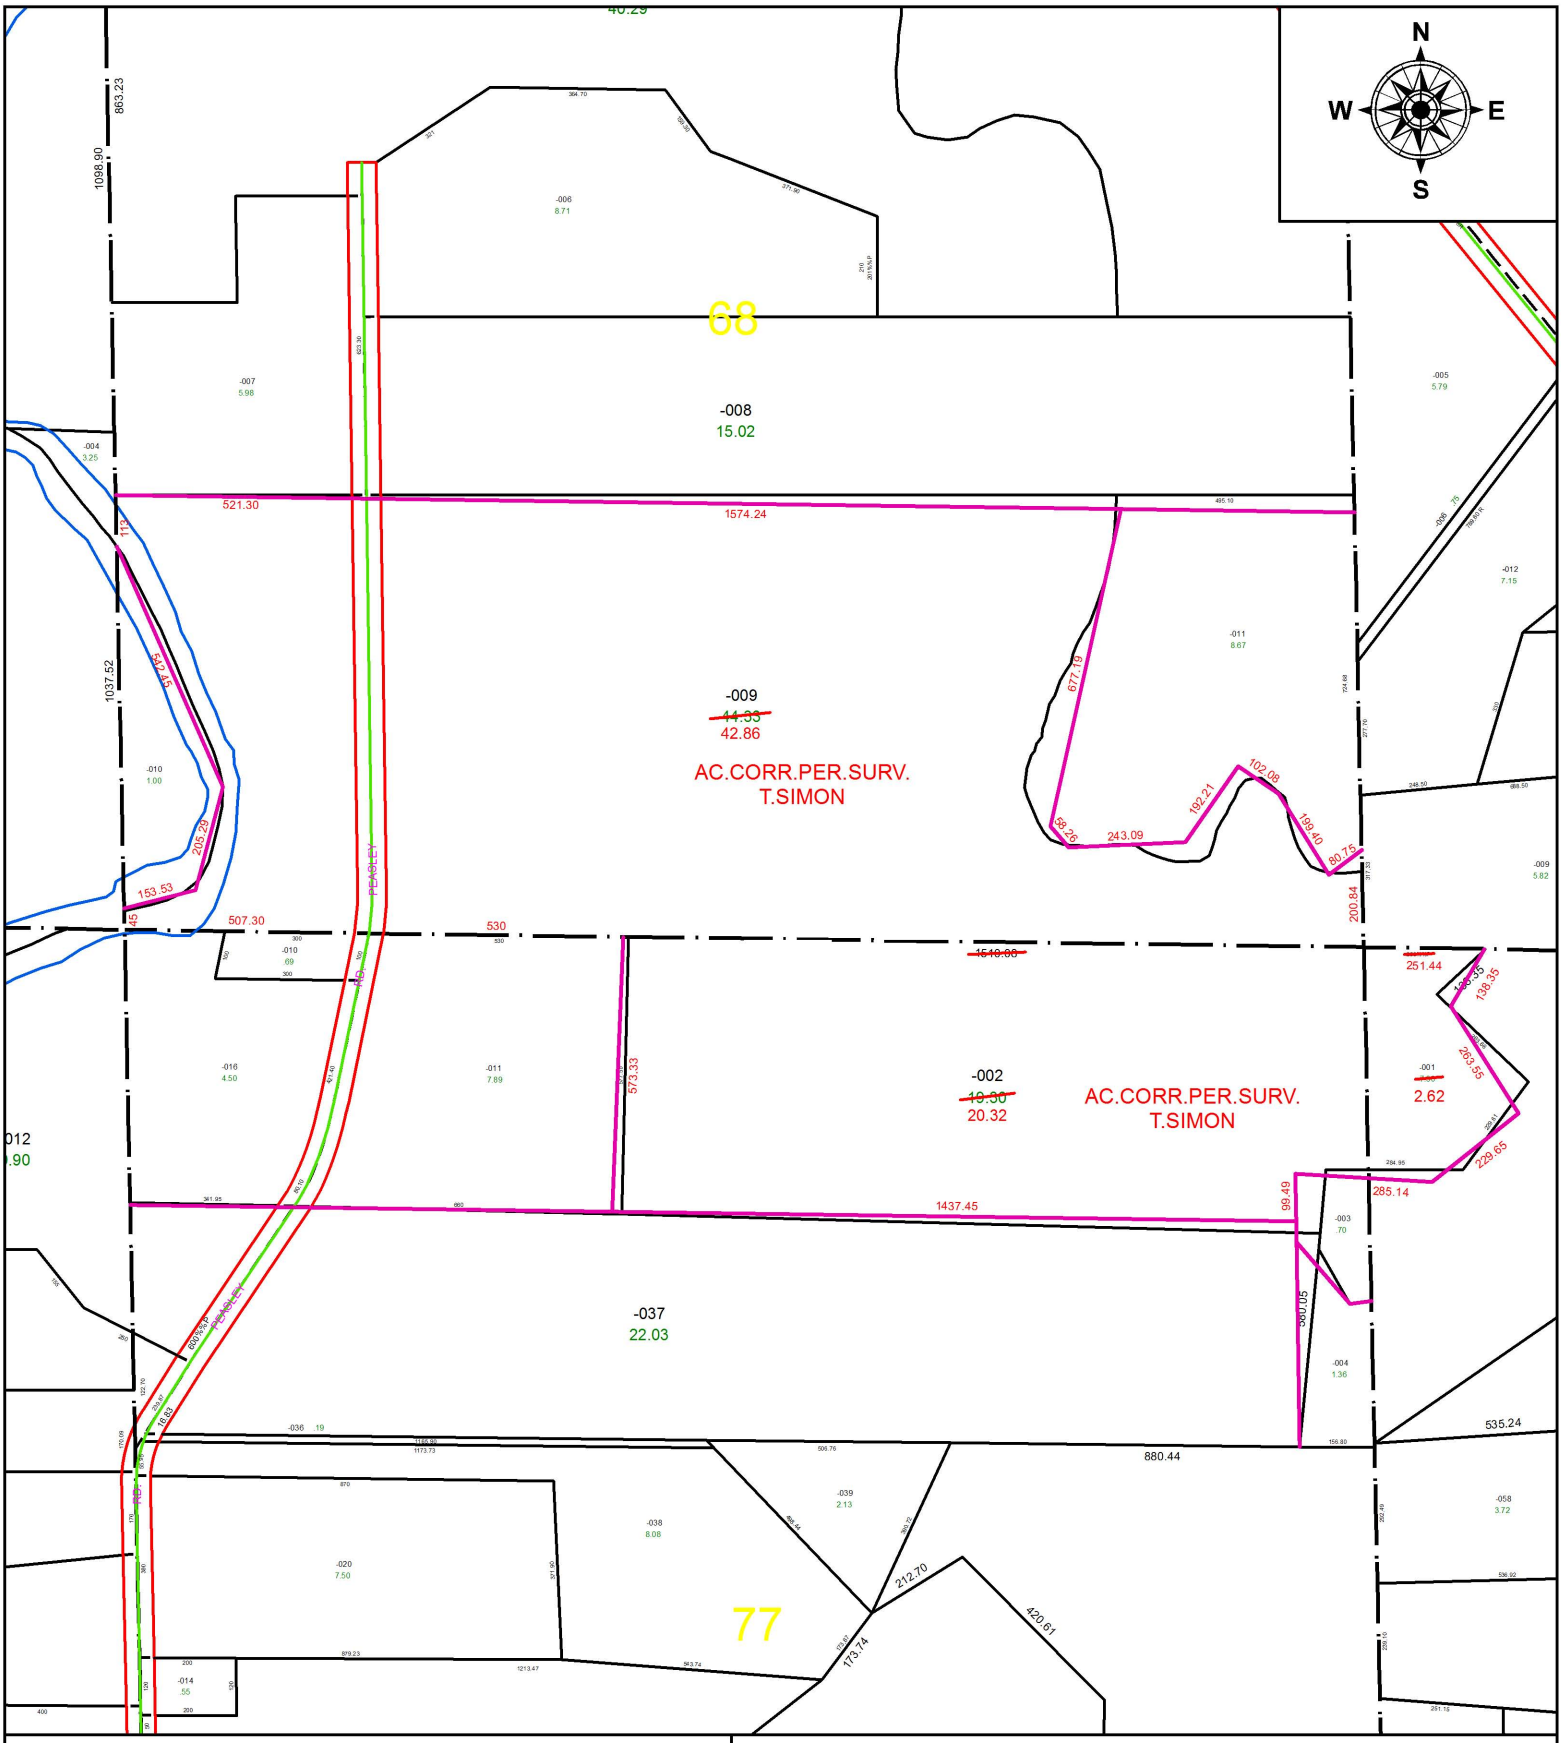

SPLITS/DEEDS PROCESSED

LORAIN COUNTY TAX MAP DEPARTMENT
226 MIDDLE AVE. ELYRIA, OH

SURVEYED BY: THOMAS A. SIMON
CLOSURE: 1: 667,071
MAP PAGE(S): 1-J
APPOVED BY: RRM **DATE:** 11-2-17
SCALE: 1" = 400 **PRIOR INSTRUMENT:** 20150558806