PARENT PARCEL: 01-00-038-000-008, -025

CHILD PARCEL: 01-00-038-000-059

STARTING POINT: INTERSECTION OF C/L OF CLAUS RD. AND C/L OF NORTH RIDGE RD,

18-03801

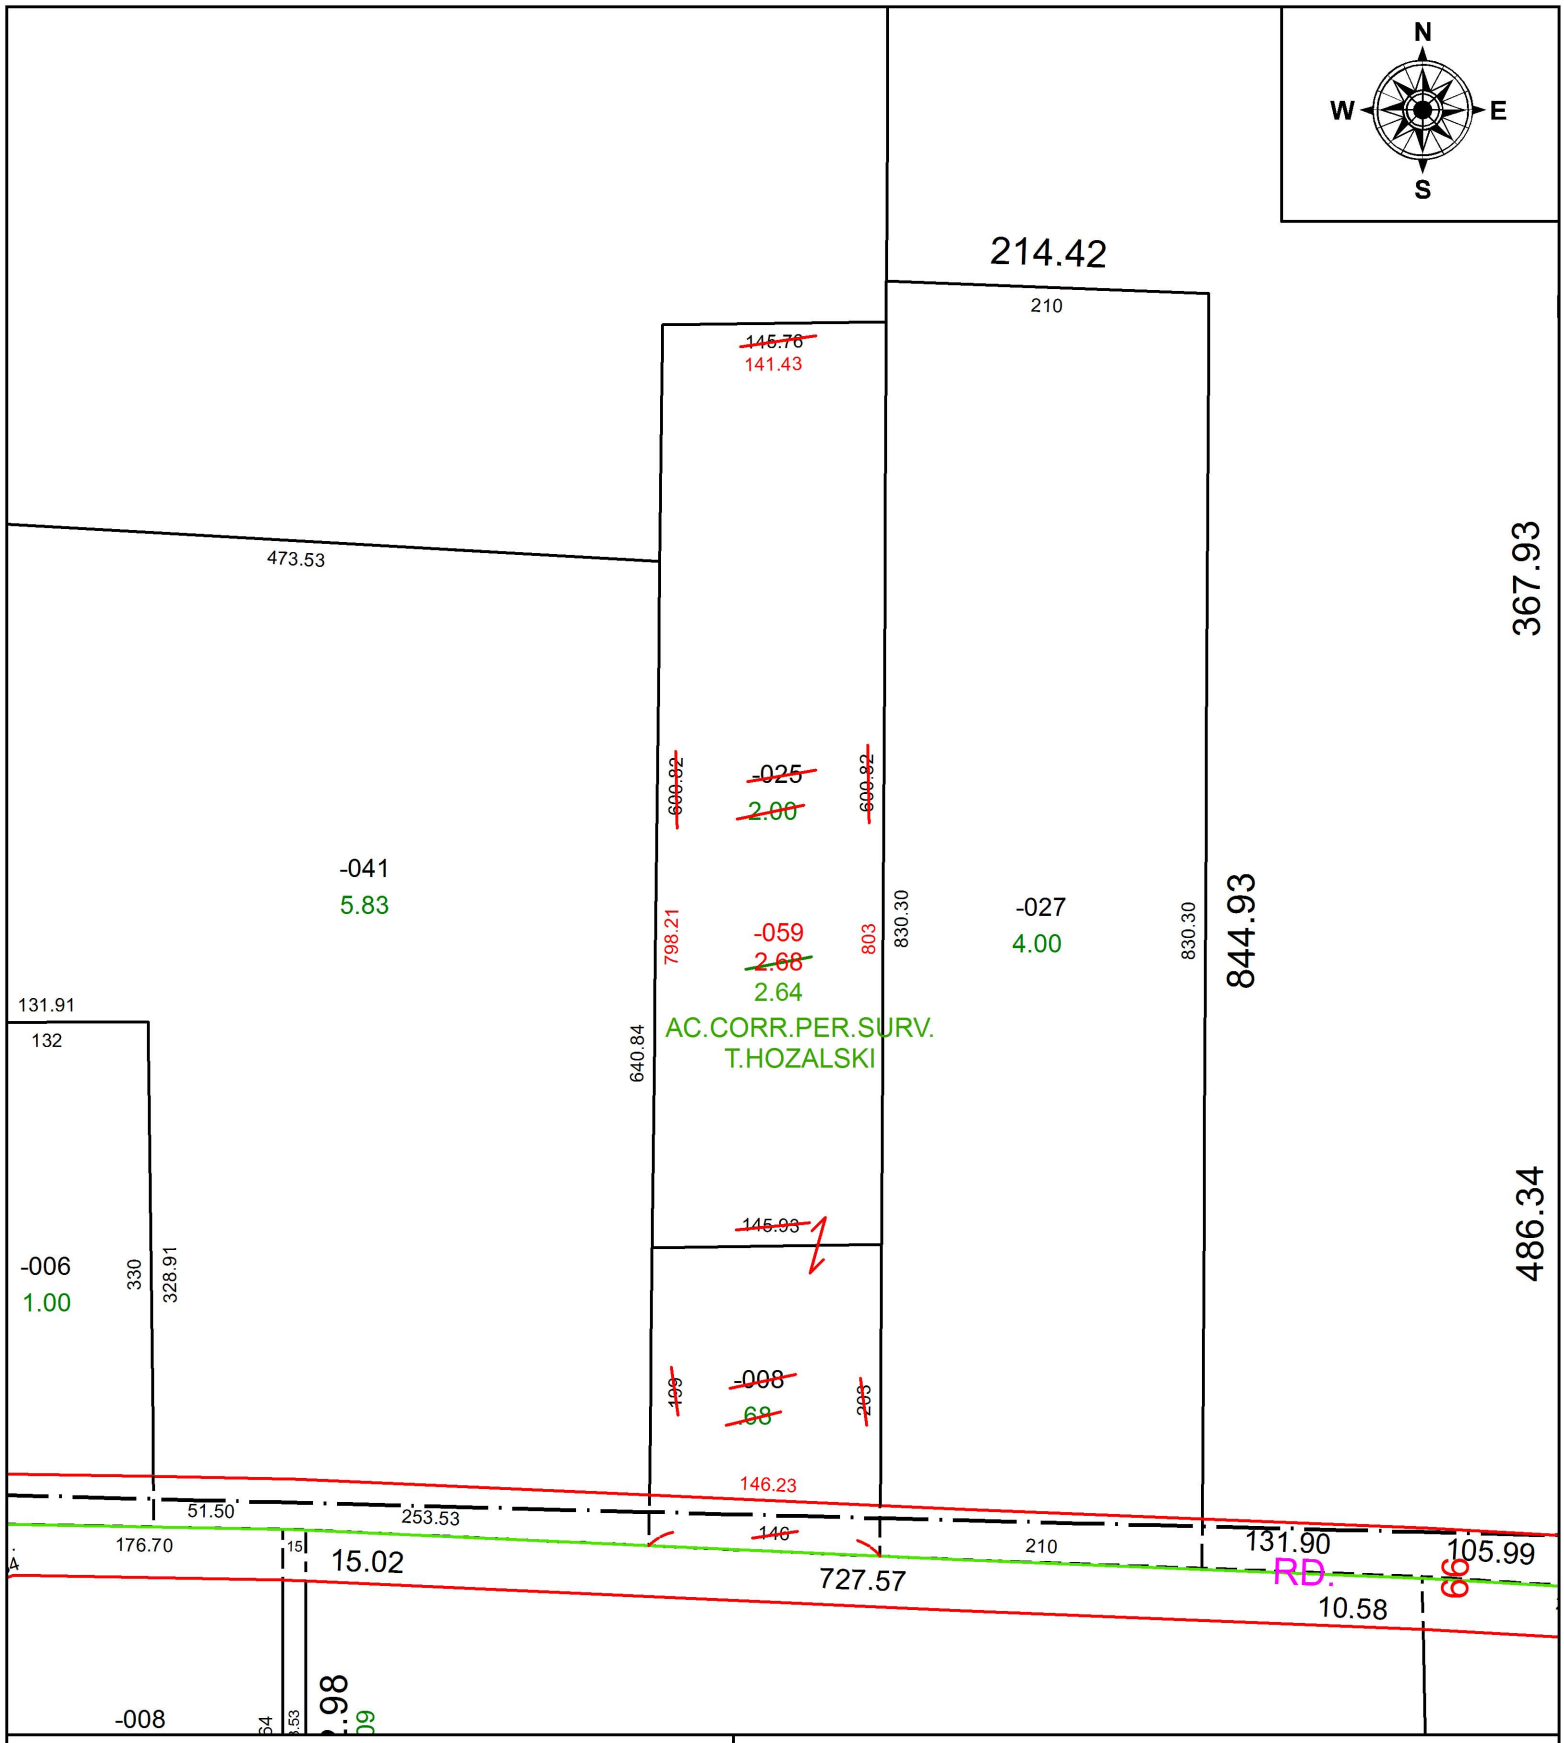

SPLITS/DEEDS PROCESSED

LORAIN COUNTY TAX MAP DEPARTMENT
226 MIDDLE AVE. ELYRIA, OH

SURVEYED BY: TIMOTHY D. HOZALSKI
CLOSURE: 1: 315,692
MAP PAGE(S): 1-00-038
APPOVED BY: RRM **DATE:** 4-4-18
SCALE: 1" = 125 **PRIOR INSTRUMENT:** DV 923/205