PARENT PARCEL: 11-00-092-000-018, -019

CHILD PARCEL: 11-00-091-000-179, 11-00-092-000-094

STARTING POINT: INTERSECTION OF C/L OF CHESTNUT RIDGE RD. AND EAST LINE OF O.L.91

18-03802

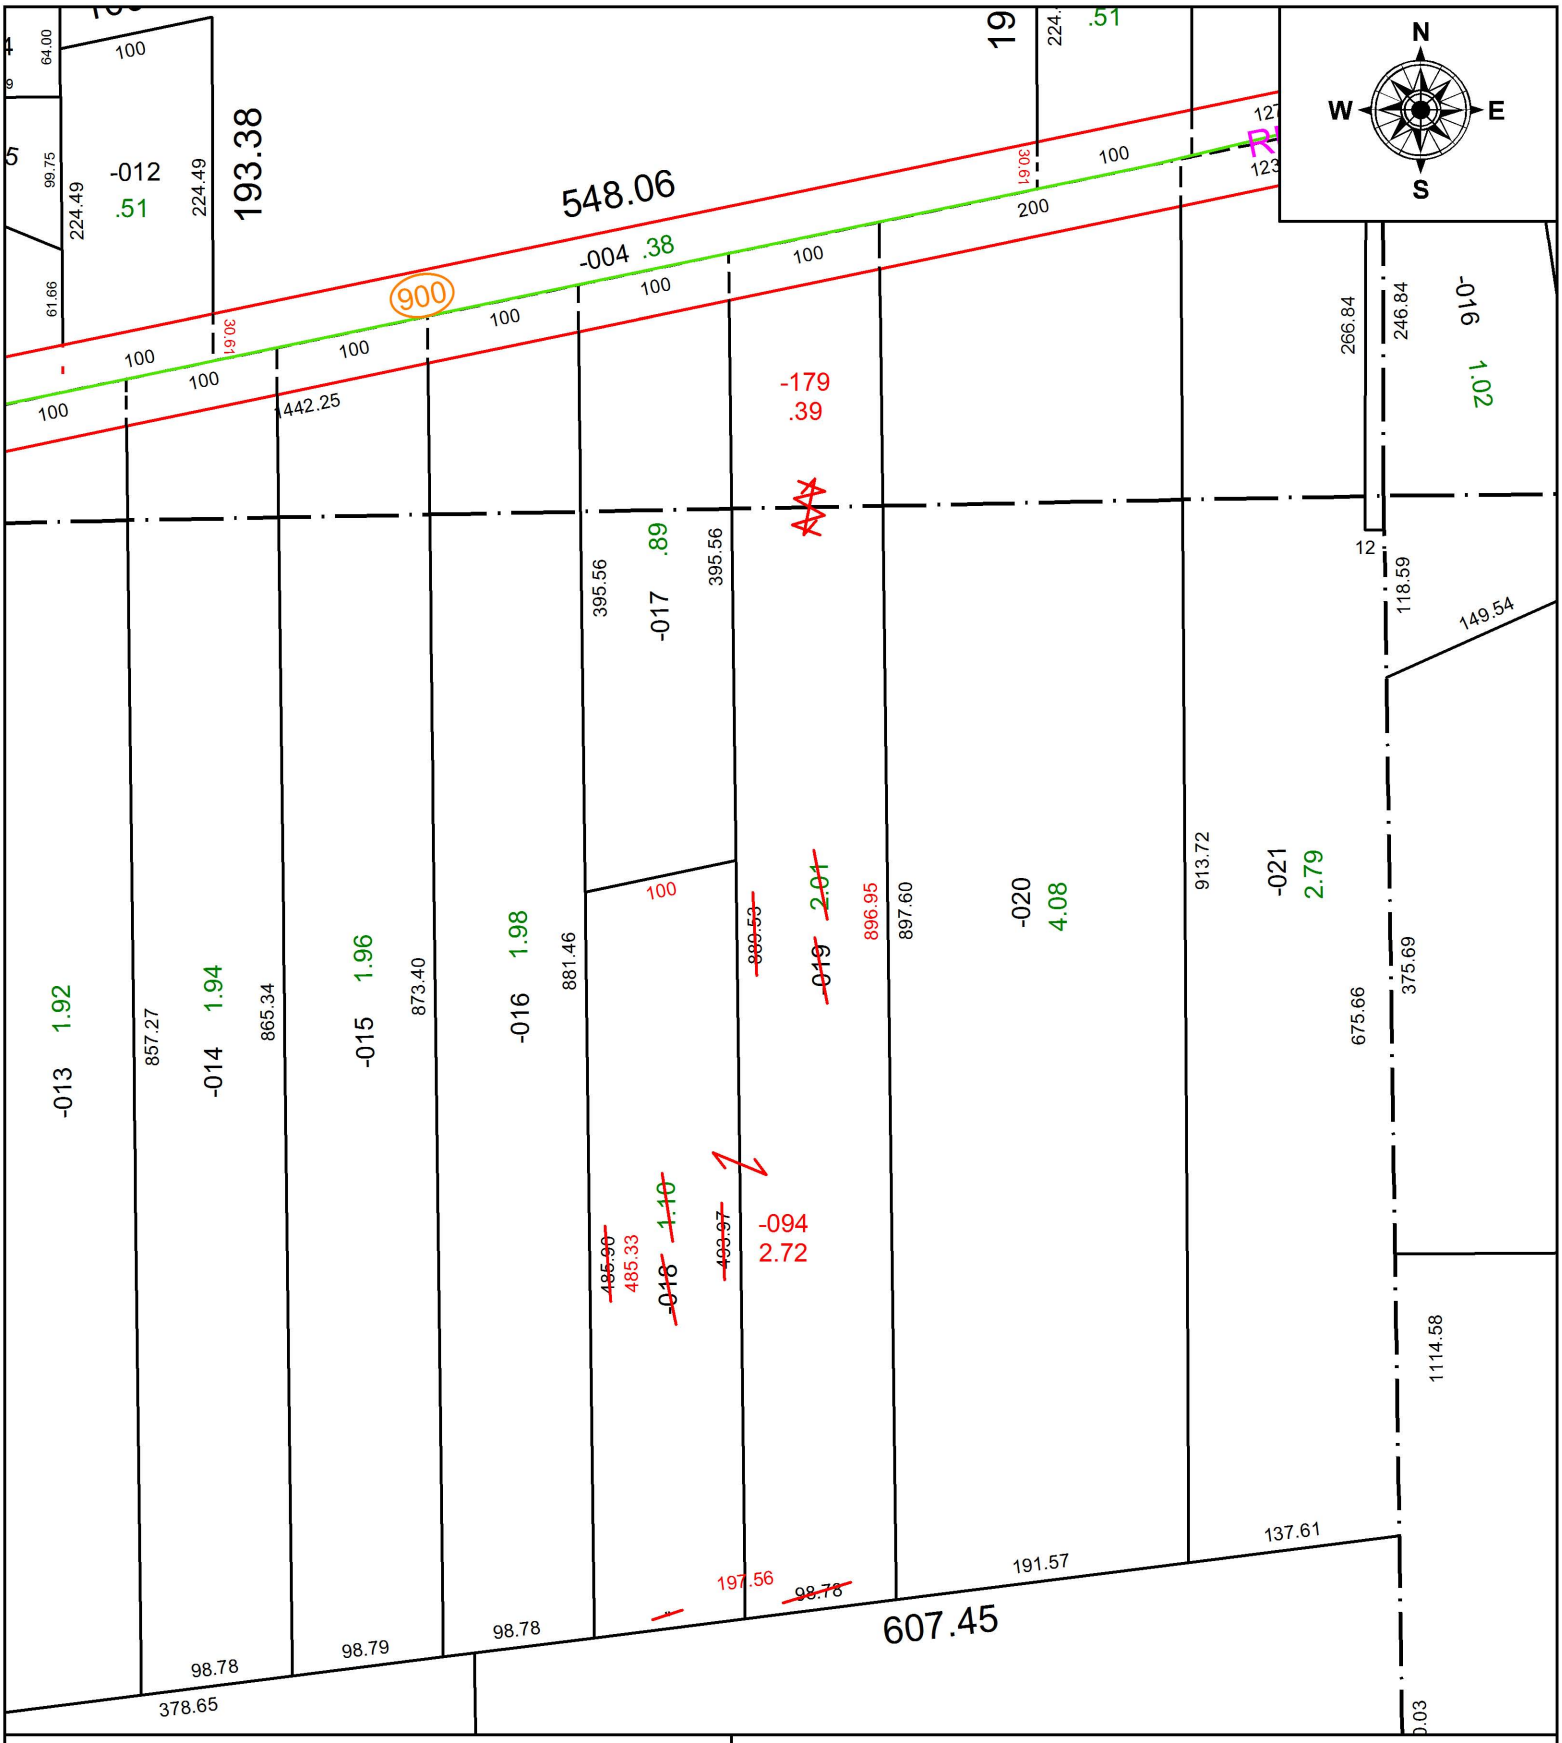

SPLITS/DEEDS PROCESSED

LORAIN COUNTY TAX MAP DEPARTMENT
226 MIDDLE AVE. ELYRIA, OH

SURVEYED BY: WILFREDO BARBOSA
CLOSURE: 1: 342,284
MAP PAGE(S): 11-00-092
APPOVED BY: RRM **DATE:** 4-9-18
SCALE: 1" = 125 **PRIOR INSTRUMENT:** 20000667922