PARENT PARCEL: 11-00-065-000-028

CHILD PARCEL: 11-00-065-000-029, -030

STARTING POINT: NORTHEAST CORNER OF O.L. 65

18-03803

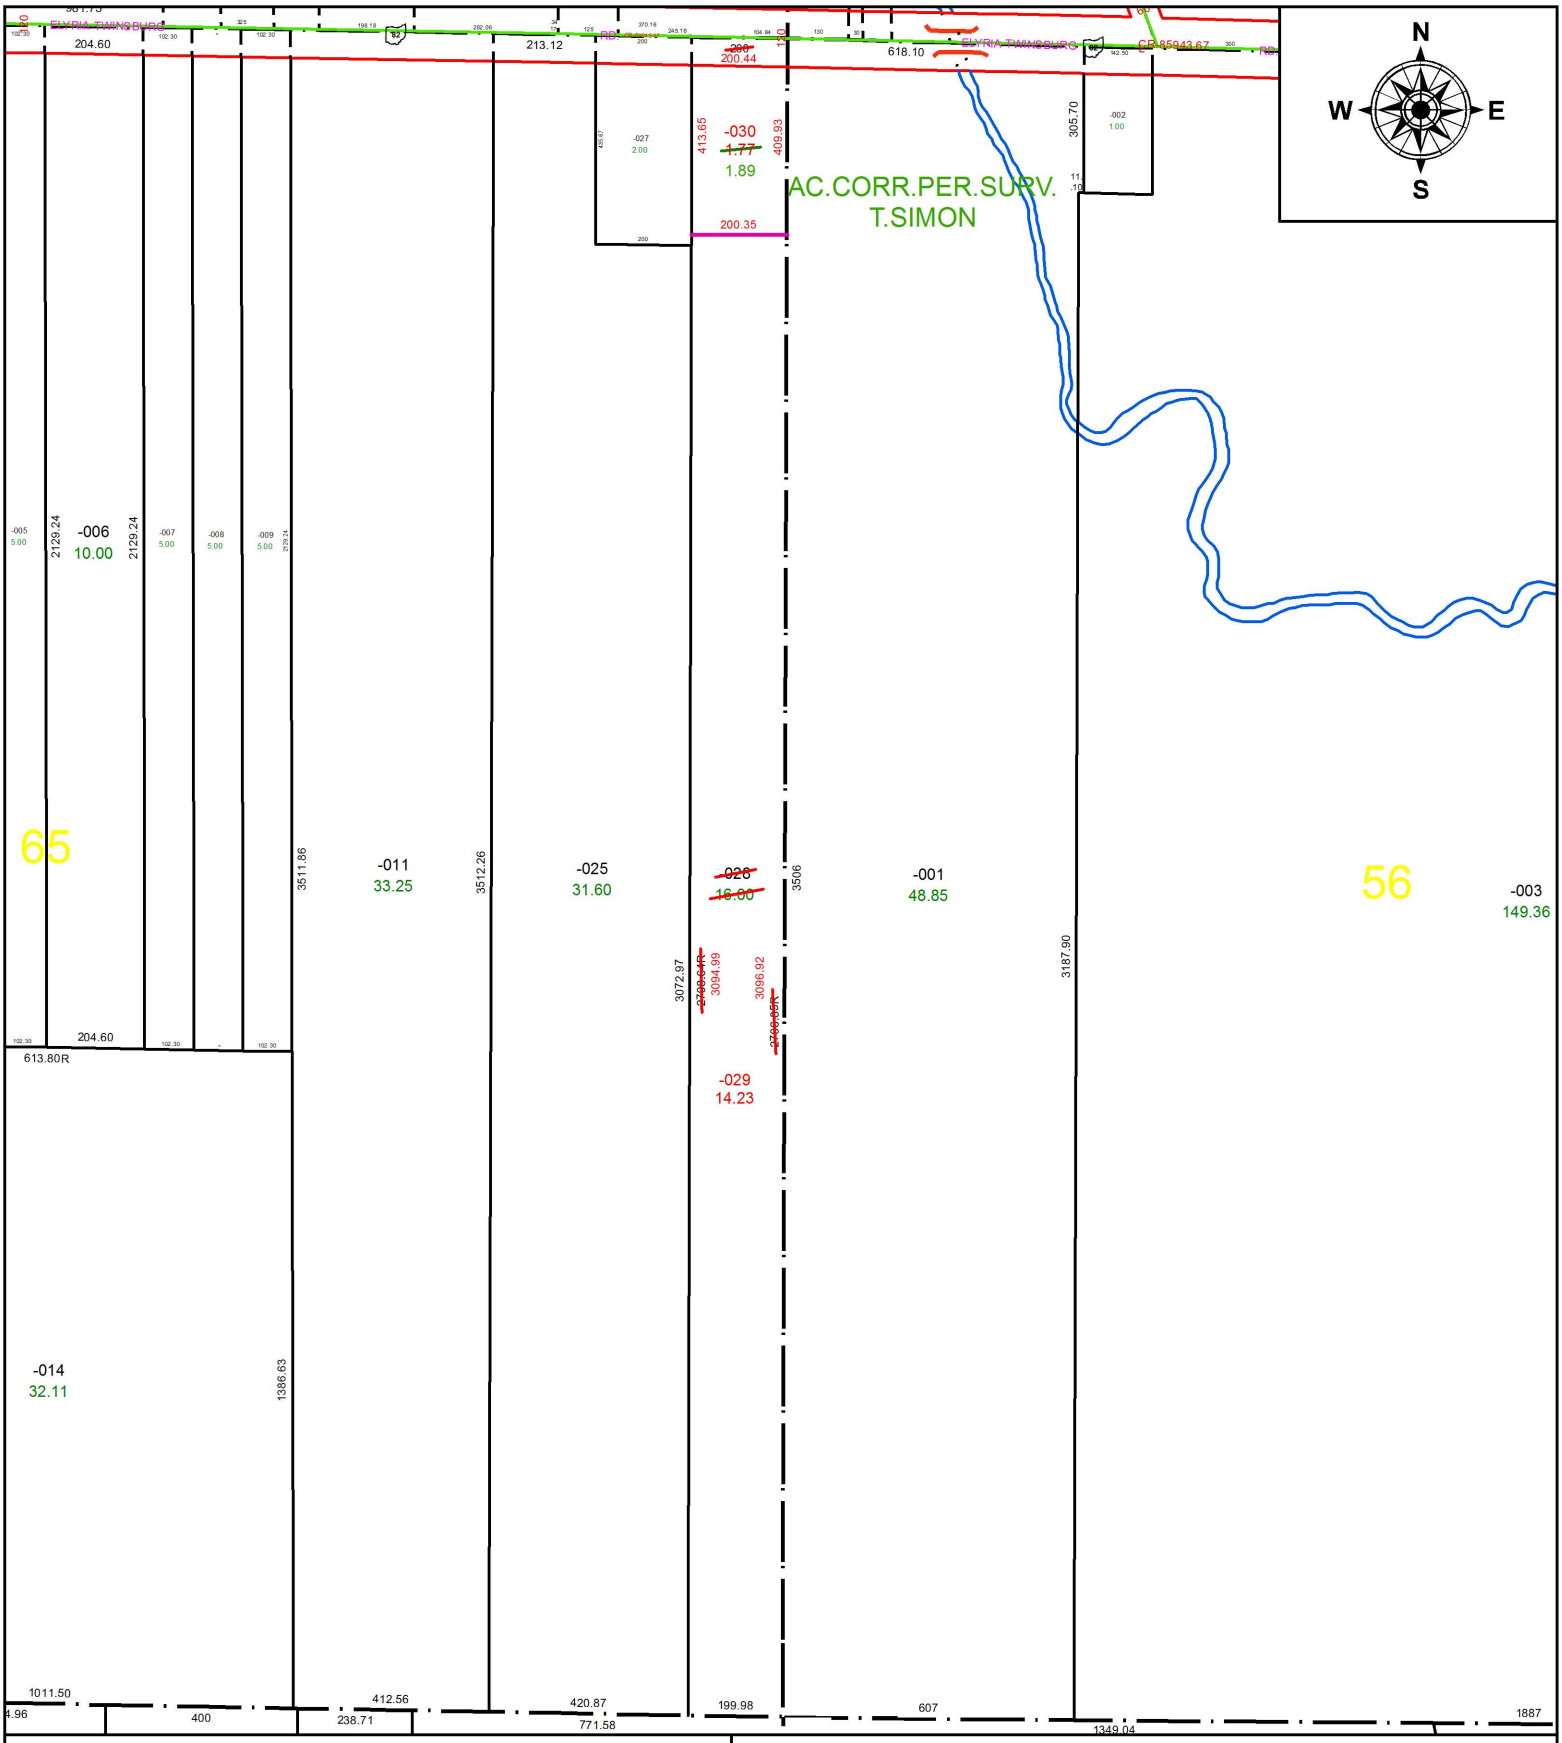

SPLITS/DEEDS PROCESSED

LORAIN COUNTY TAX MAP DEPARTMENT
226 MIDDLE AVE. ELYRIA, OH

SURVEYED BY: THOMAS A. SIMON
CLOSURE: 1: 594,801
MAP PAGE(S): 11-00-065
APPOVED BY: RRM **DATE:** 4-11-18
SCALE: 1" = 400 **PRIOR INSTRUMENT:** 20160582737