PARENT PARCEL: 09-00-017-000-005

CHILD PARCEL: 09-00-017-000-006, -007

STARTING POINT: INTERSECTION OF C/L OF OBERLIN RD. AND C/L OF RUSSIA RD.

18-03804

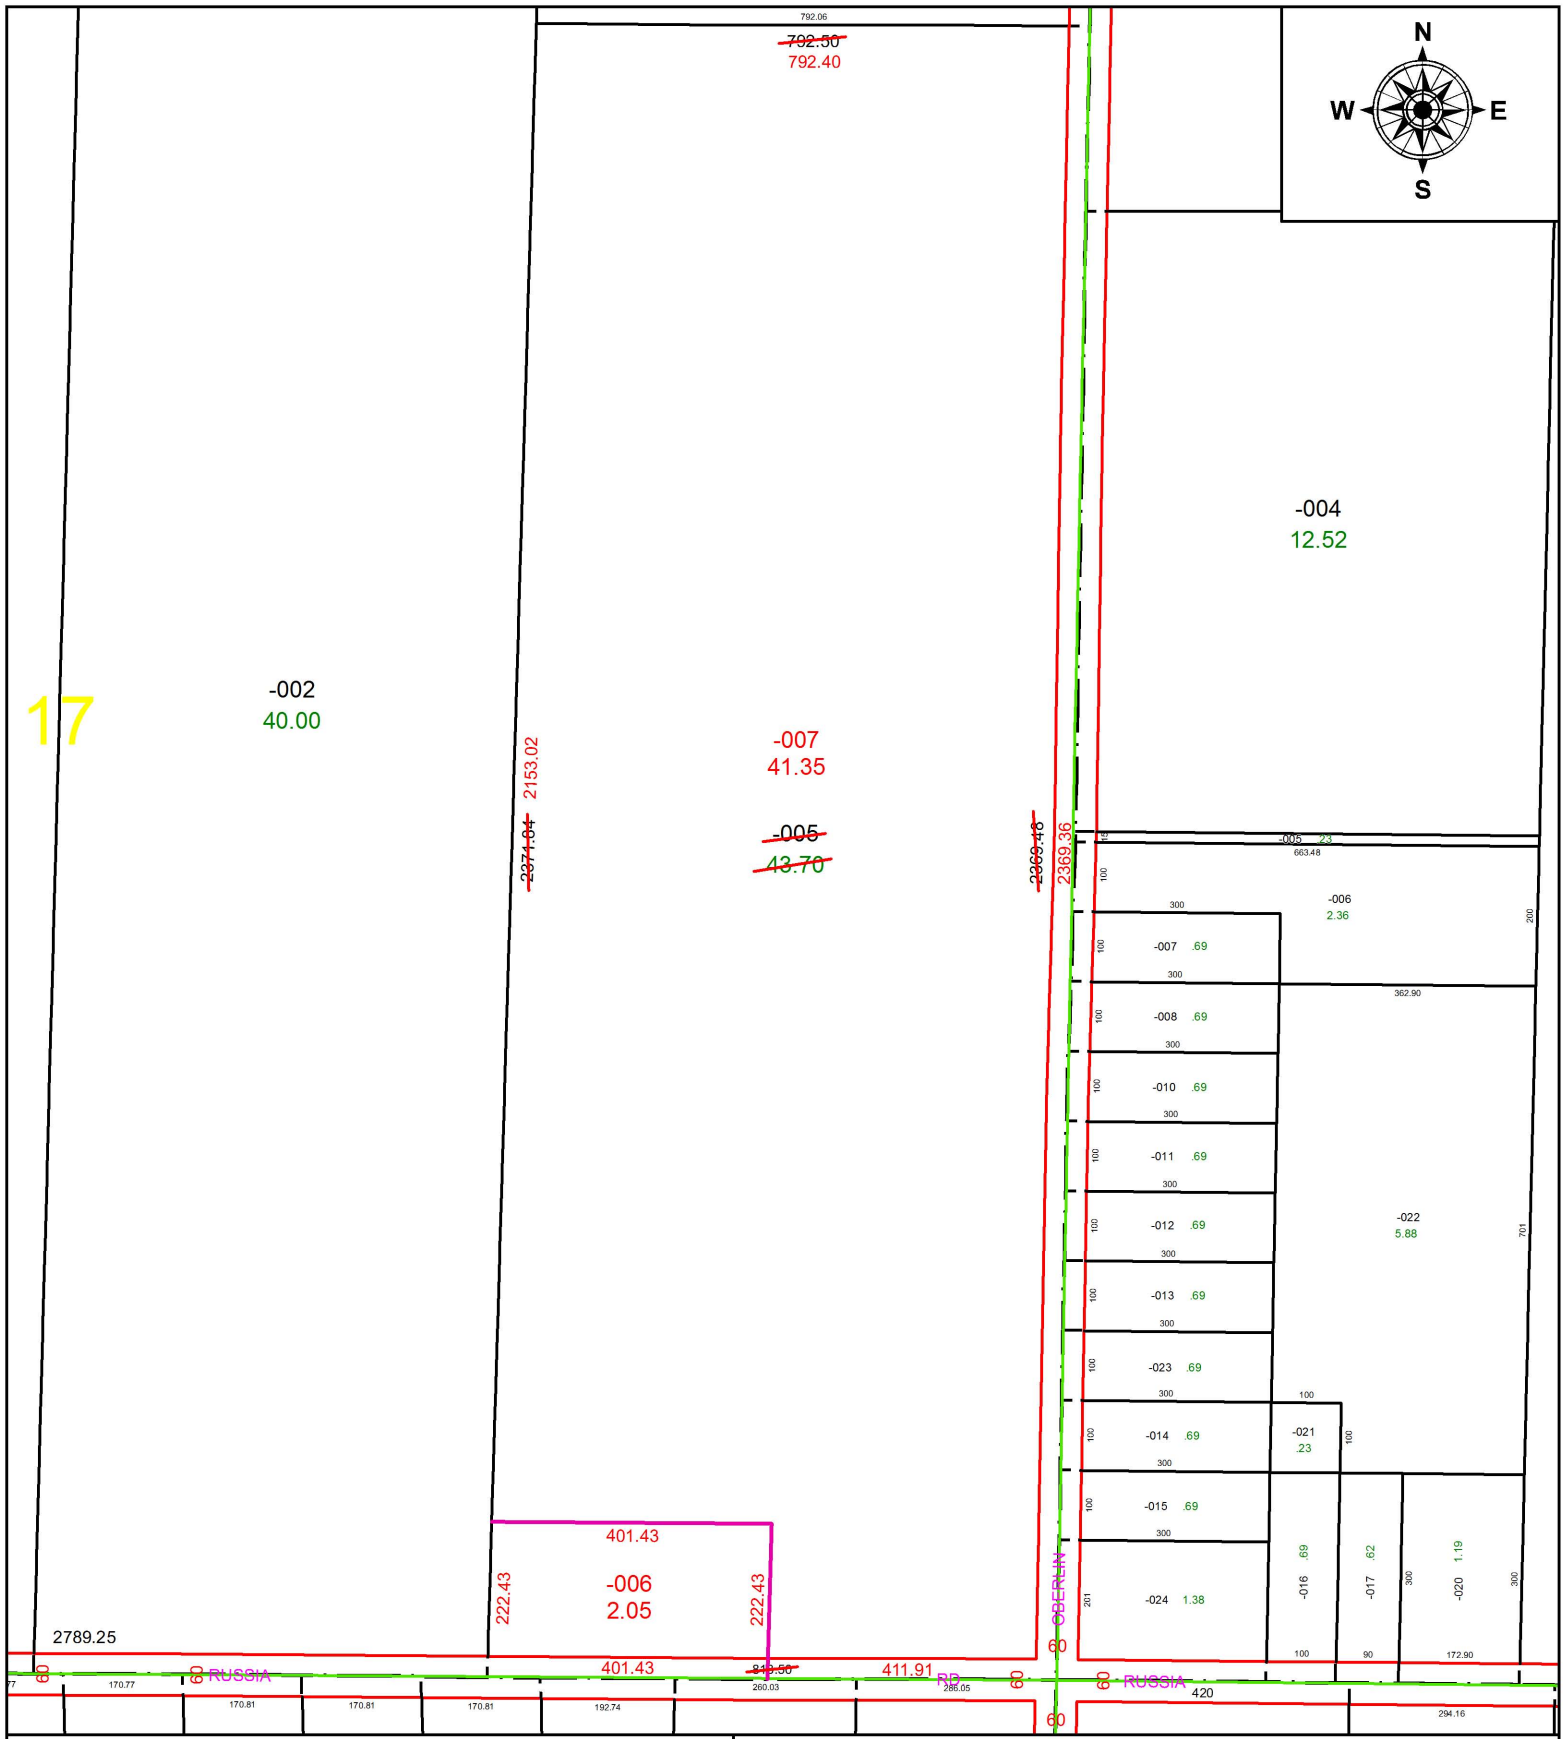

SPLITS/DEEDS PROCESSED

LORAIN COUNTY TAX MAP DEPARTMENT
226 MIDDLE AVE. ELYRIA, OH

SURVEYED BY: TIMOTHY D. HOZALSKI
CLOSURE: 1: 2147483648
MAP PAGE(S): 9-00-017
APPOVED BY: RRM **DATE:** 4-13-18
SCALE: 1" = 275 **PRIOR INSTRUMENT:** 20120439990