PARENT PARCEL: 02-01-005-106-008
CHILD PARCEL: 02-01-005-106-023, -024
STARTING POINT: INTERSECTION OF C/L WASHINGTON AVE. AND C/L OF W. 5TH ST.

18-03805

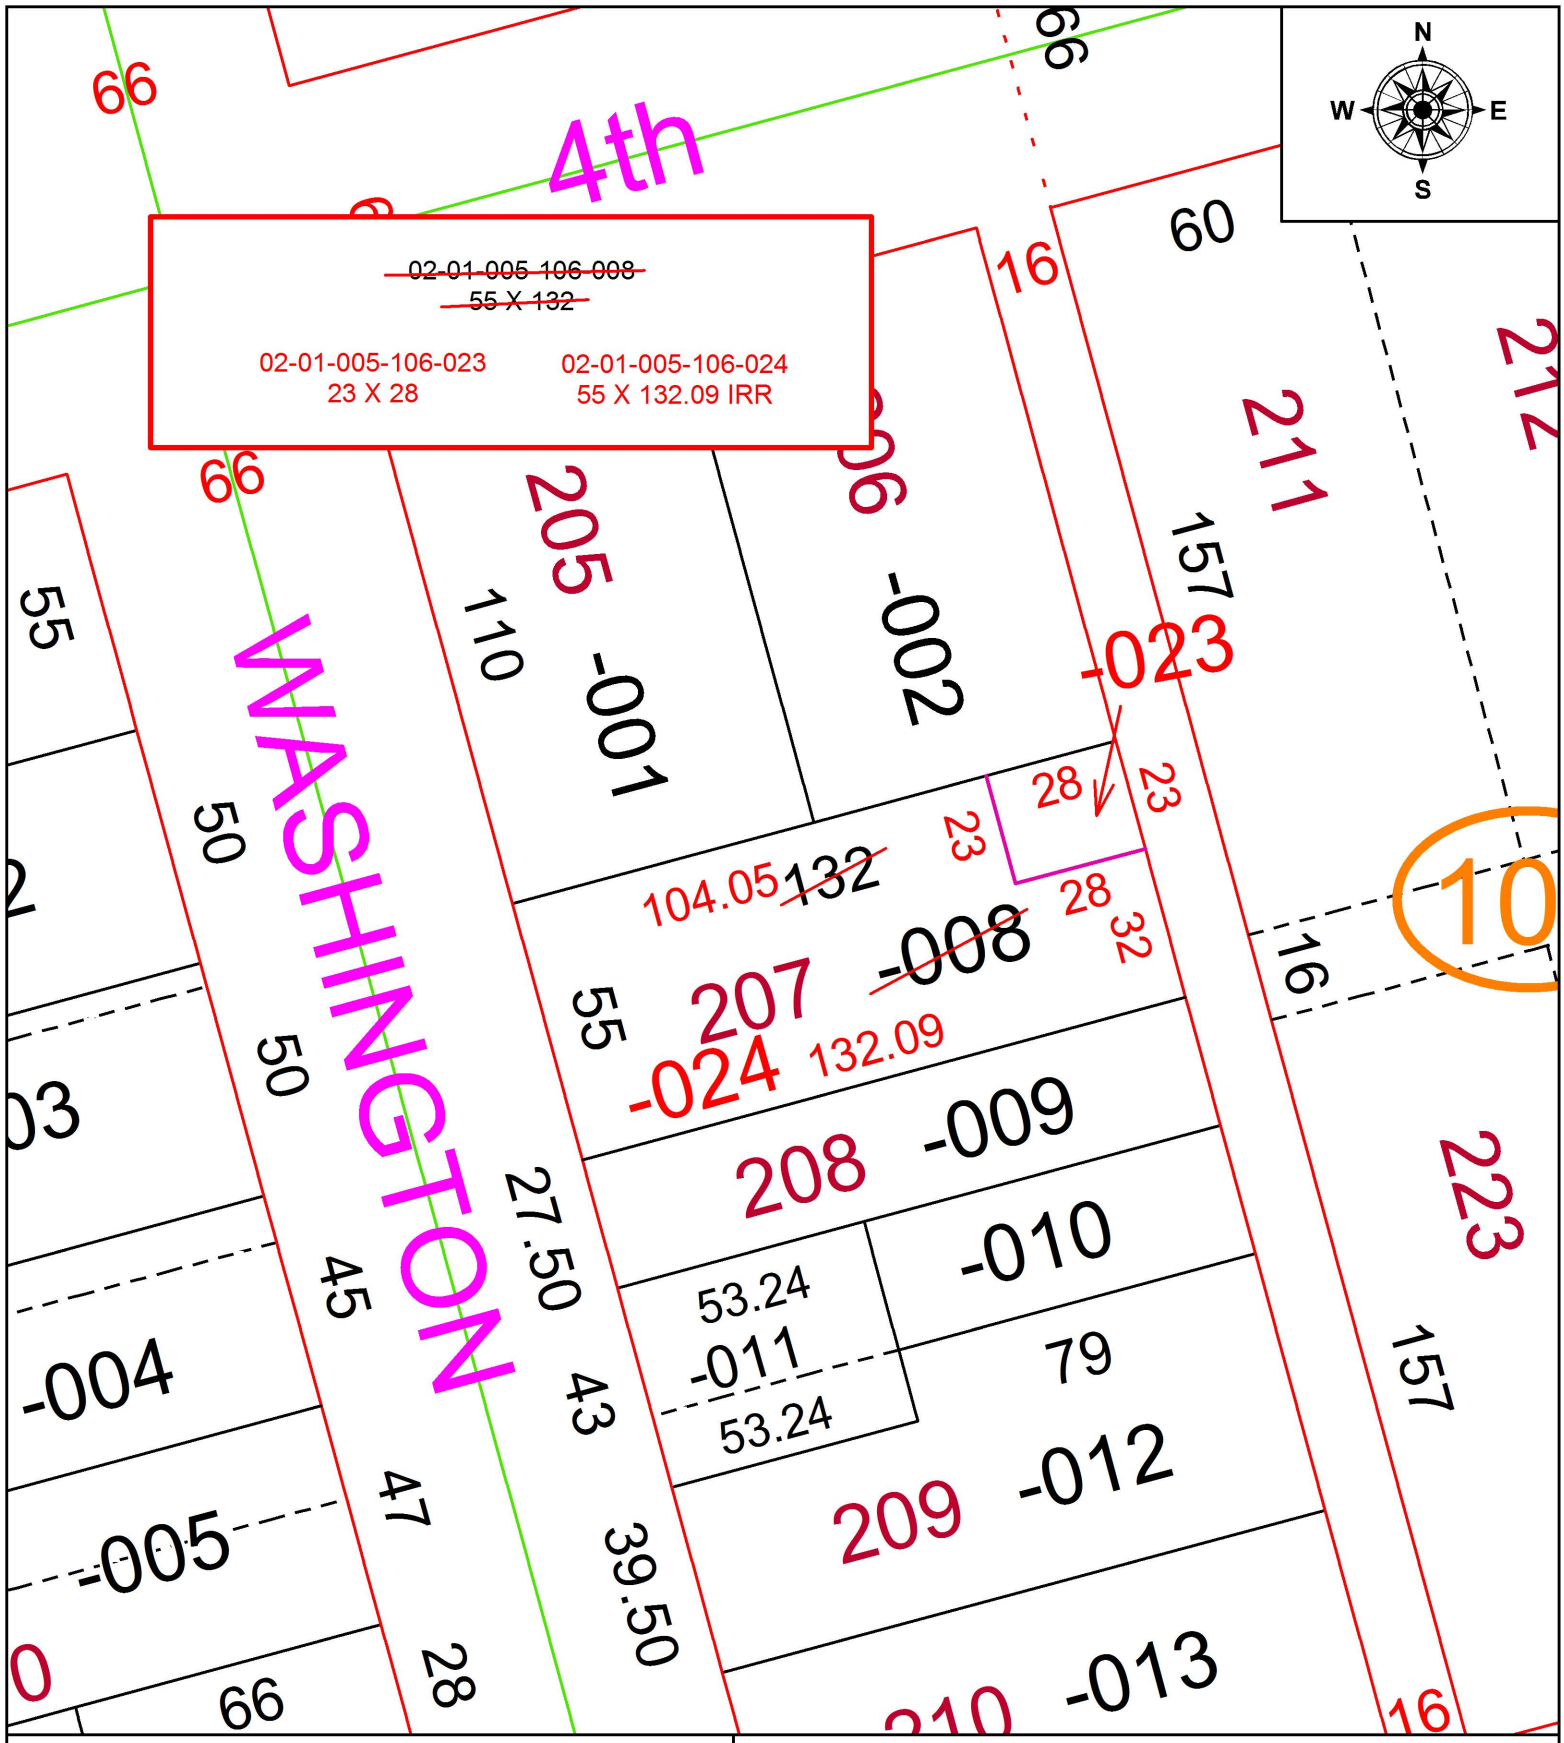

SPLITS/DEEDS PROCESSED
LORAIN COUNTY TAX MAP DEPARTMENT
226 MIDDLE AVE. ELYRIA, OH

SURVEYED BY: DOUGLAS A. HASEL
CLOSURE: 1: 116,787
MAP PAGE(S): 2-01-005
APPOVED BY: RRM **DATE:** 4-17-18
SCALE: 1" = 40 **PRIOR INSTRUMENT:** 20170644972