PARENT PARCEL: 12-00-025-000-062, -070

CHILD PARCEL: 12-00-025-000-075 THRU -077

STARTING POINT: INTERSECTION OF C/L OF S.R.82 AND C/L OF N. BOONE RD.

18-03806

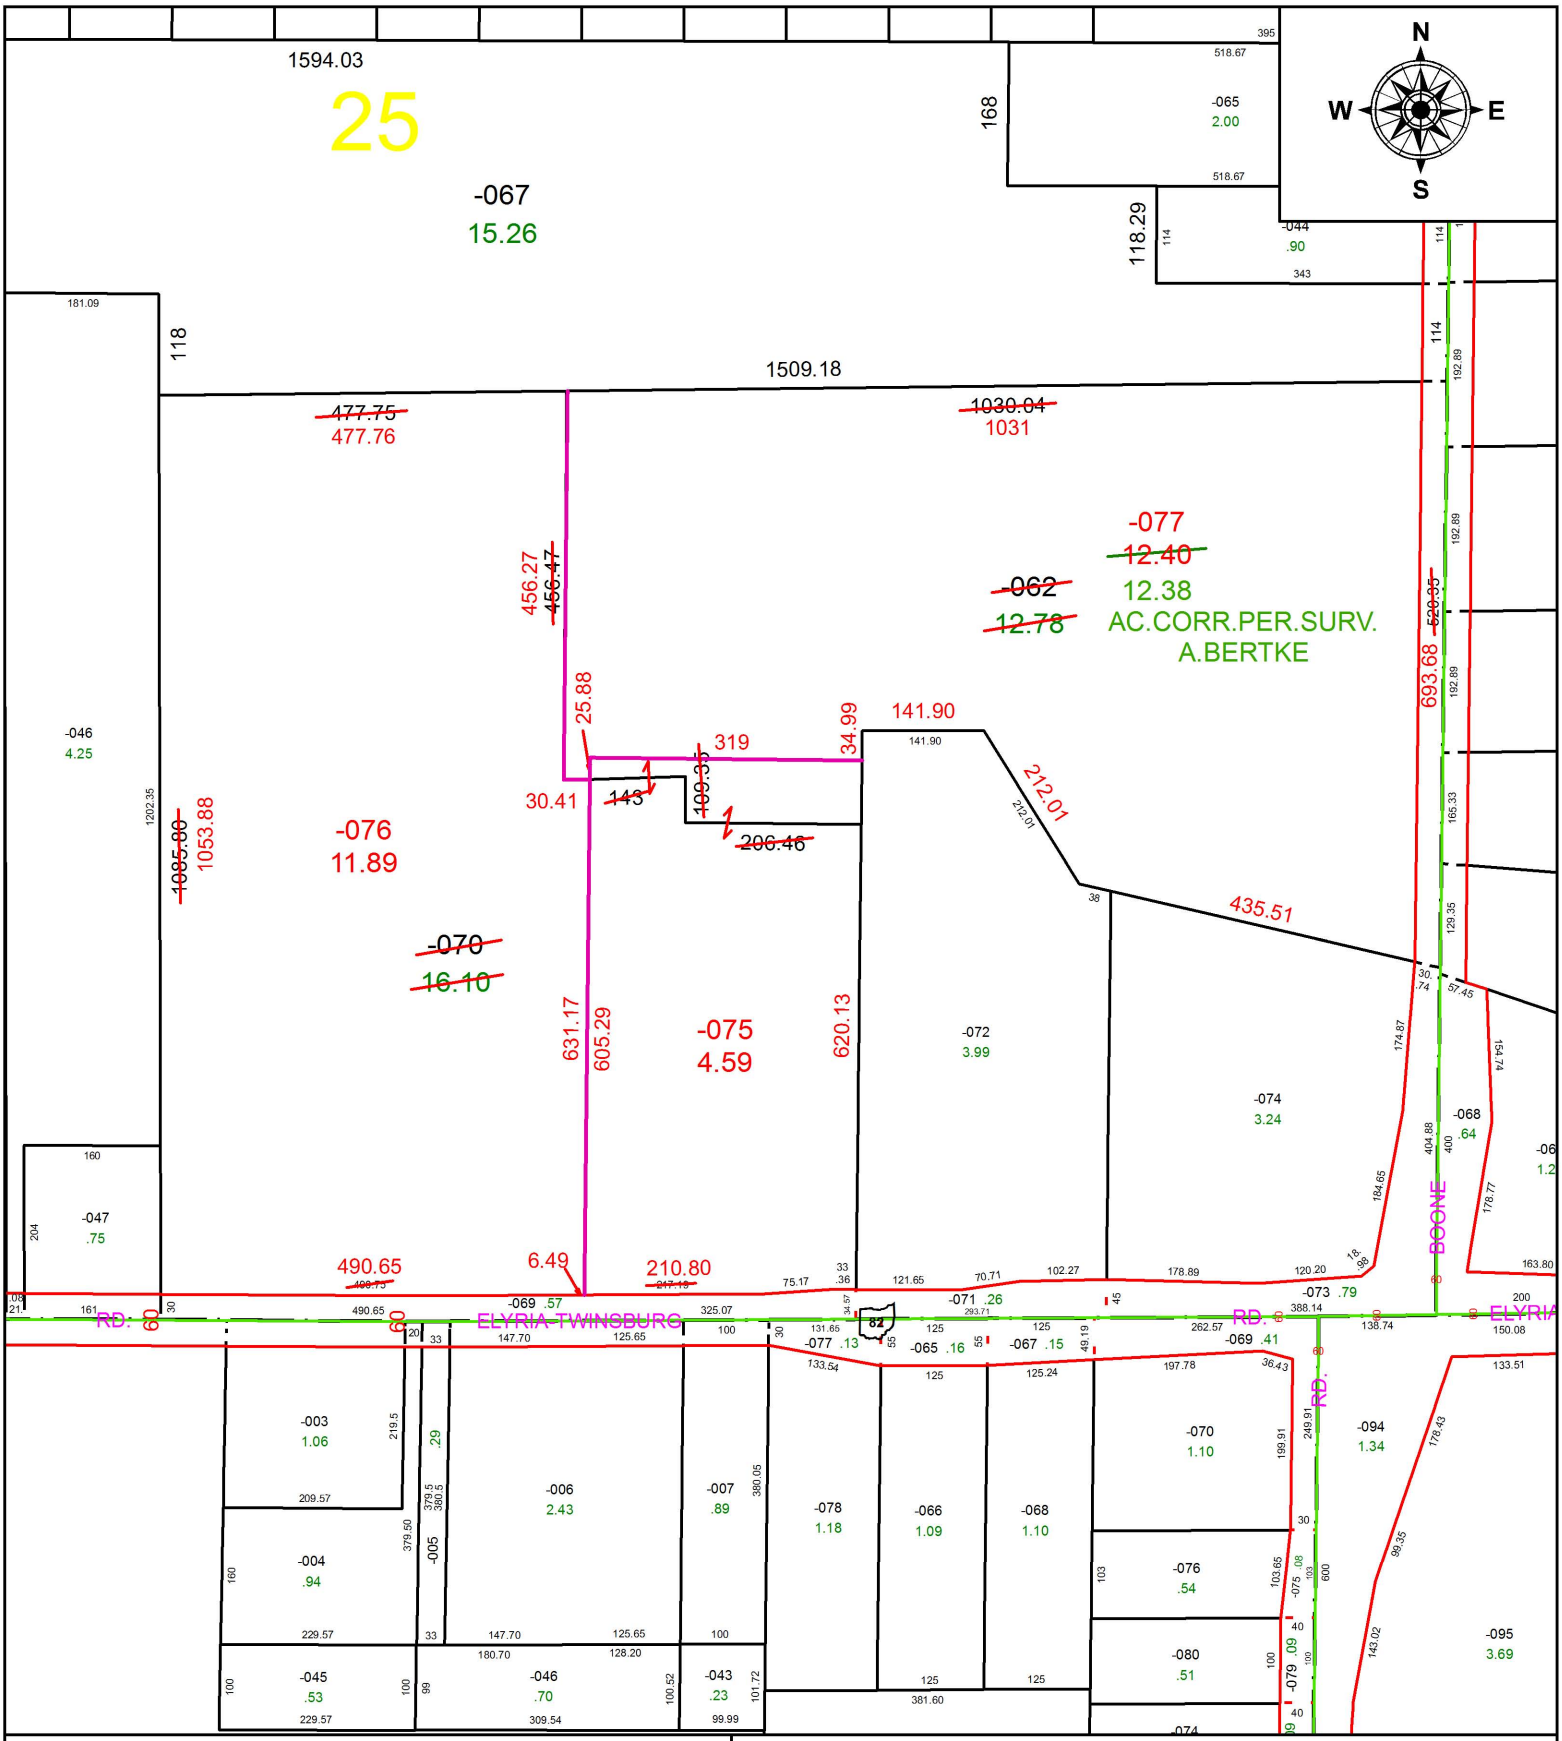

SPLITS/DEEDS PROCESSED

LORAIN COUNTY TAX MAP DEPARTMENT
226 MIDDLE AVE. ELYRIA, OH

SURVEYED BY: ALLEN J. BERTKE

CLOSURE: 1: 327,361

MAP PAGE(S): 12-00-025

APPOVED BY: RRM **DATE:** 4-17-18

SCALE: 1" = 225 **PRIOR INSTRUMENT:** 20000686119