PARENT PARCEL: 09-00-085-101-030
CHILD PARCEL: XX-XX-XXX-XXX-XXX
STARTING POINT: INTERSECTION OF C/L OF W. COLLEGE ST. AND C/L OF N. CEDAR ST.

17-03809-C

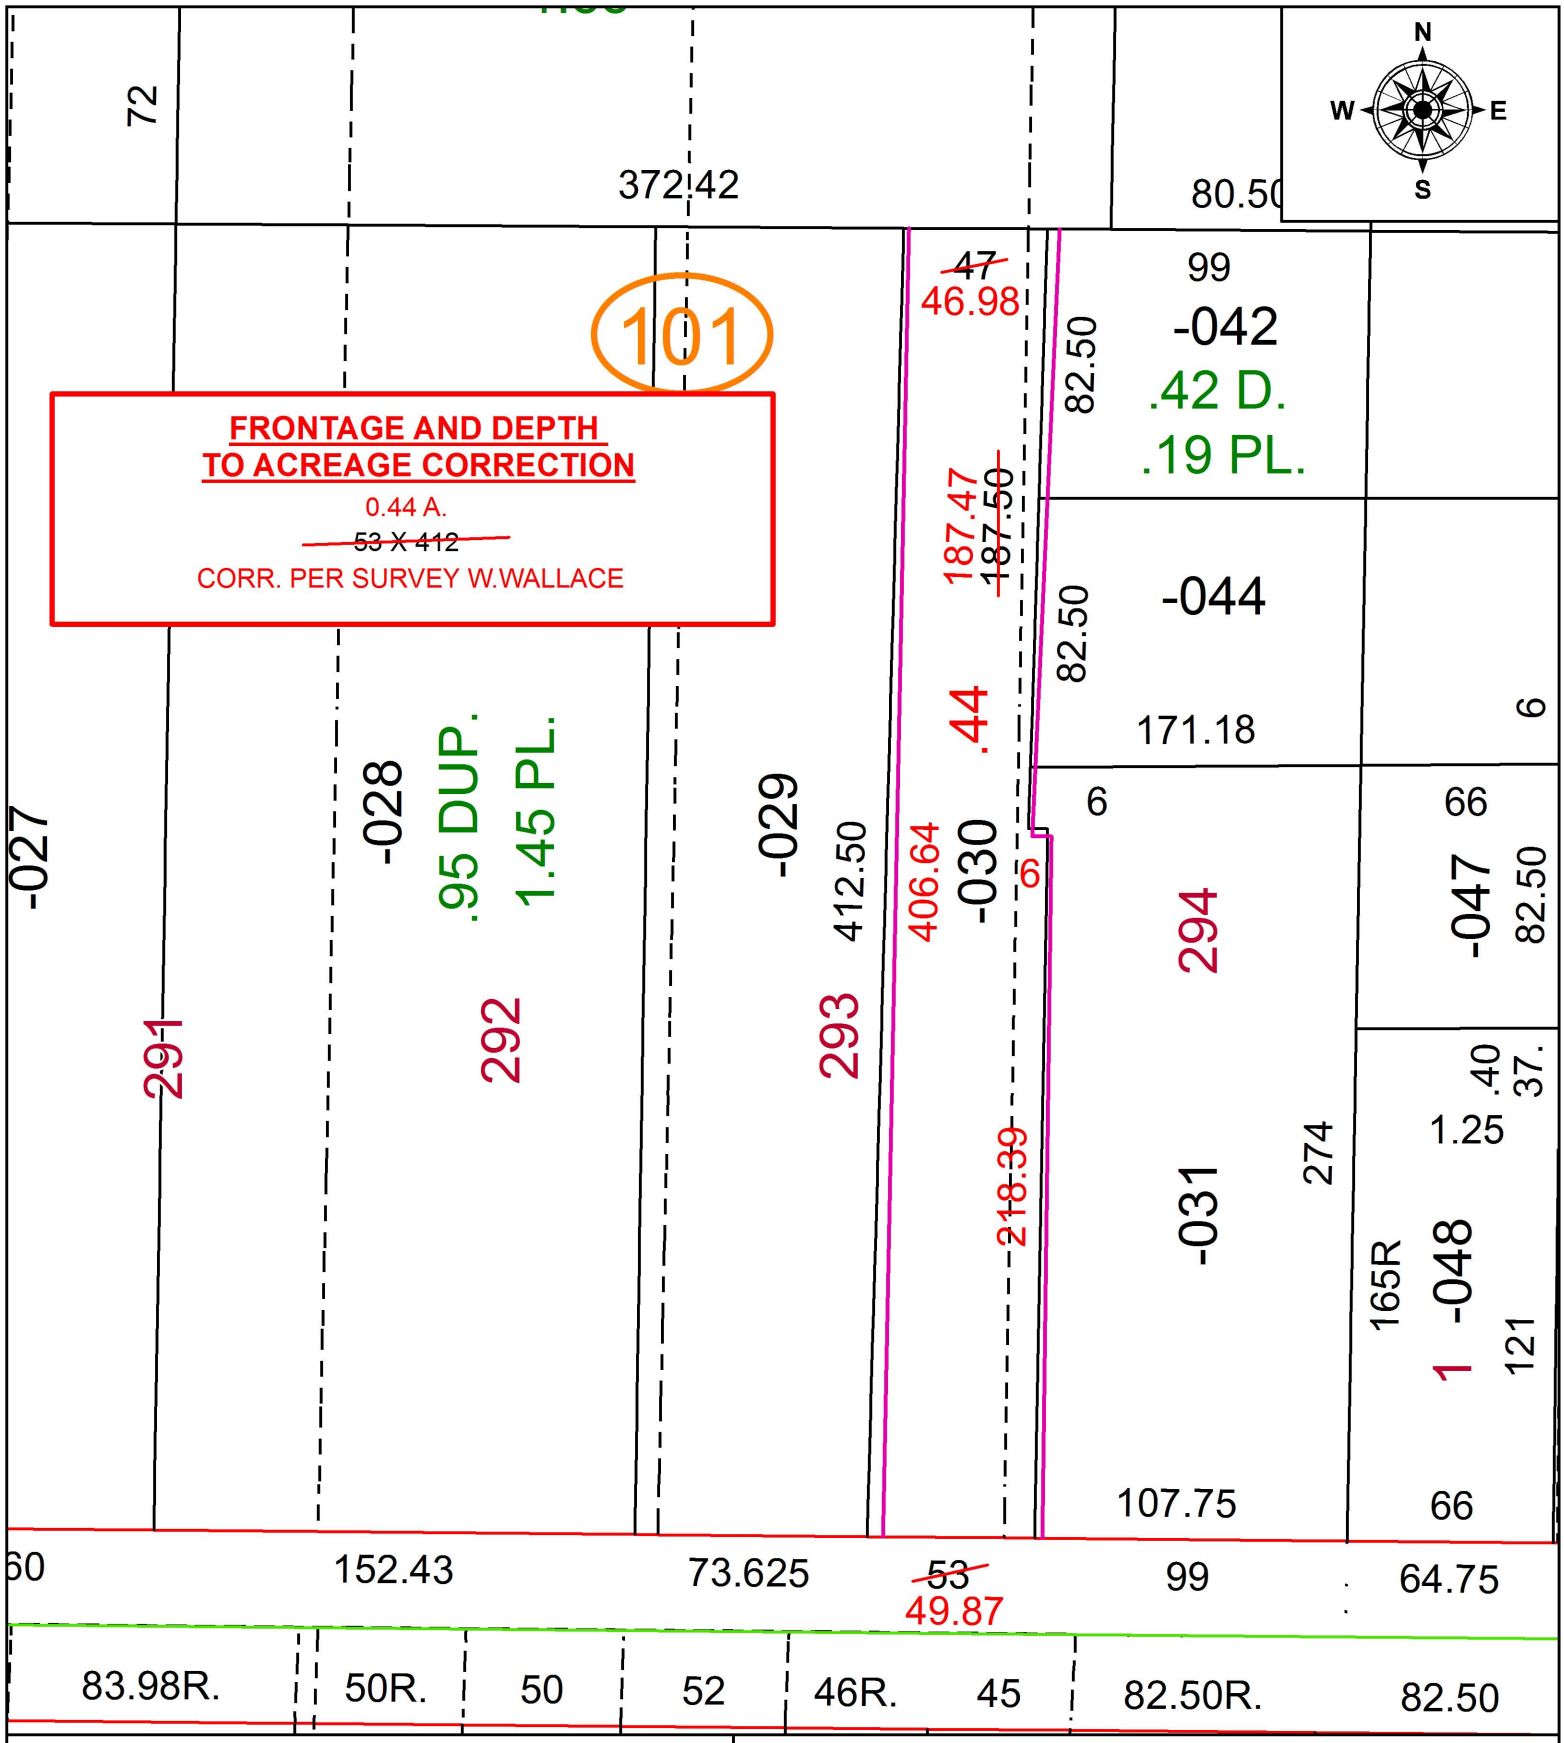

SPLITS/DEEDS PROCESSED
LORAIN COUNTY TAX MAP DEPARTMENT
226 MIDDLE AVE. ELYRIA, OH

SURVEYED BY: WILLIAM R. WALLACE
CLOSURE: 1: 209,736
MAP PAGE(S): 9-00-085
APPOVED BY: RRM **DATE:** 12-7-17
SCALE: 1" = 60 **PRIOR INSTRUMENT:** OR 1053/131