PARENT PARCEL: 01-00-003-119-009, -018, -019, -020, -021, -022, -023

CHILD PARCEL: 01-00-003-119-009, -018, -019, -020, -021, -022, -024 THRU -039

STARTING POINT: SOUTHEAST CORNER OF S/L 561 IN VERMILION ON THE LAKE SUB. NO.1

18-03811

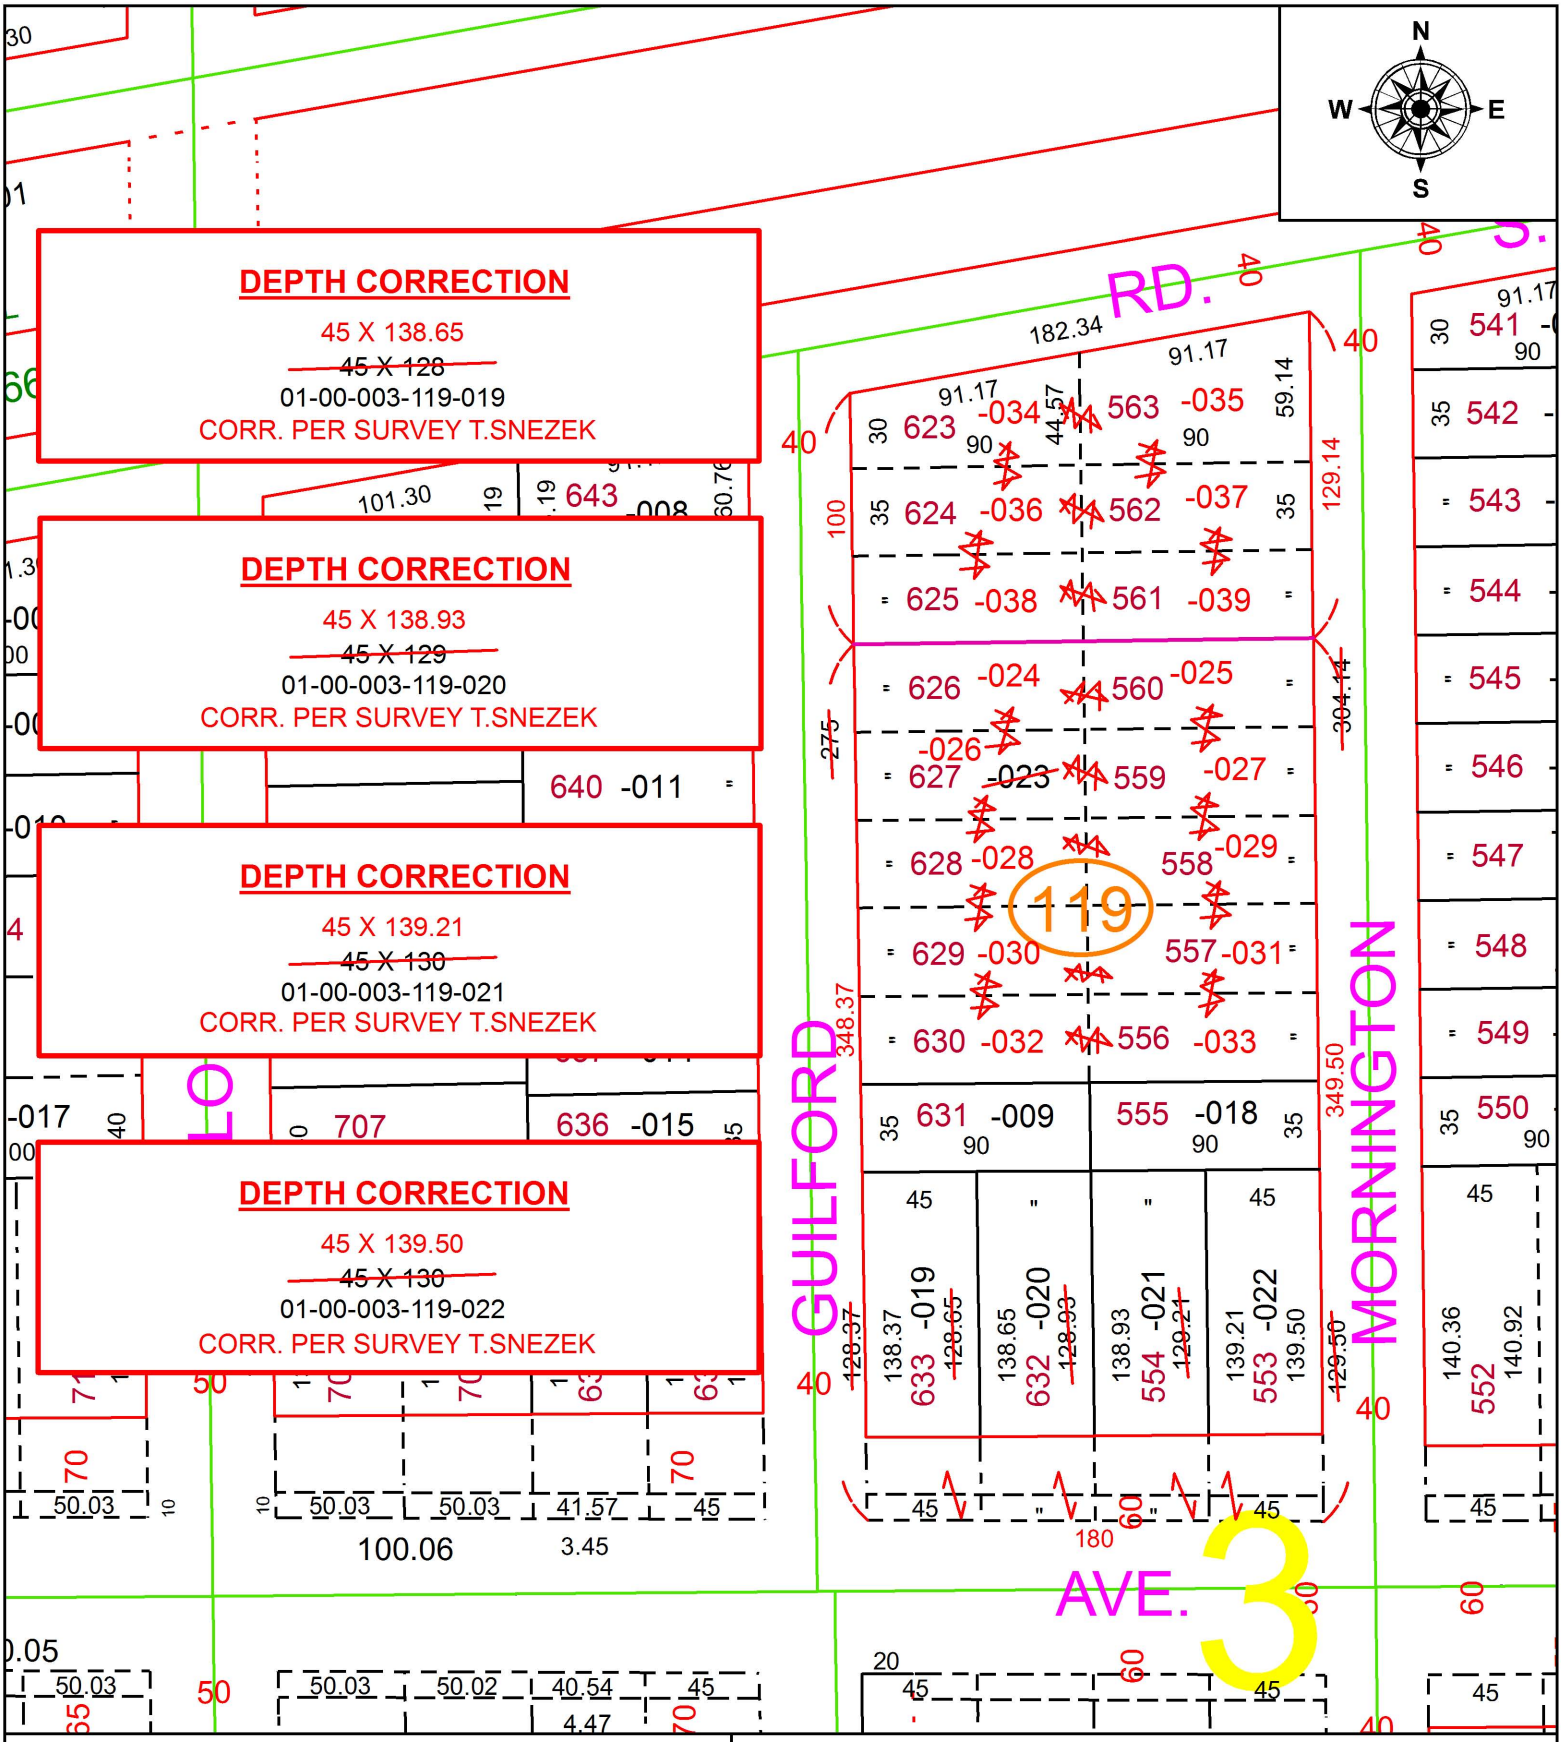

SPLITS/DEEDS PROCESSED

LORAIN COUNTY TAX MAP DEPARTMENT
226 MIDDLE AVE. ELYRIA, OH

SURVEYED BY: THOMAS M. SNEZEK
CLOSURE: 1: 298,093
MAP PAGE(S): 1-00-003
APPOVED BY: RRM **DATE:** 5-8-18
SCALE: 1" = 75 **PRIOR INSTRUMENT:** 20180659120