PARENT PARCEL: 04-00-020-104-485

CHILD PARCEL: 04-00-020-104-654 THRU -657

STARTING POINT: INTERSECTION OF C/L OF DORCHESTER DR. AND C/L LEAR RD.

18-03813

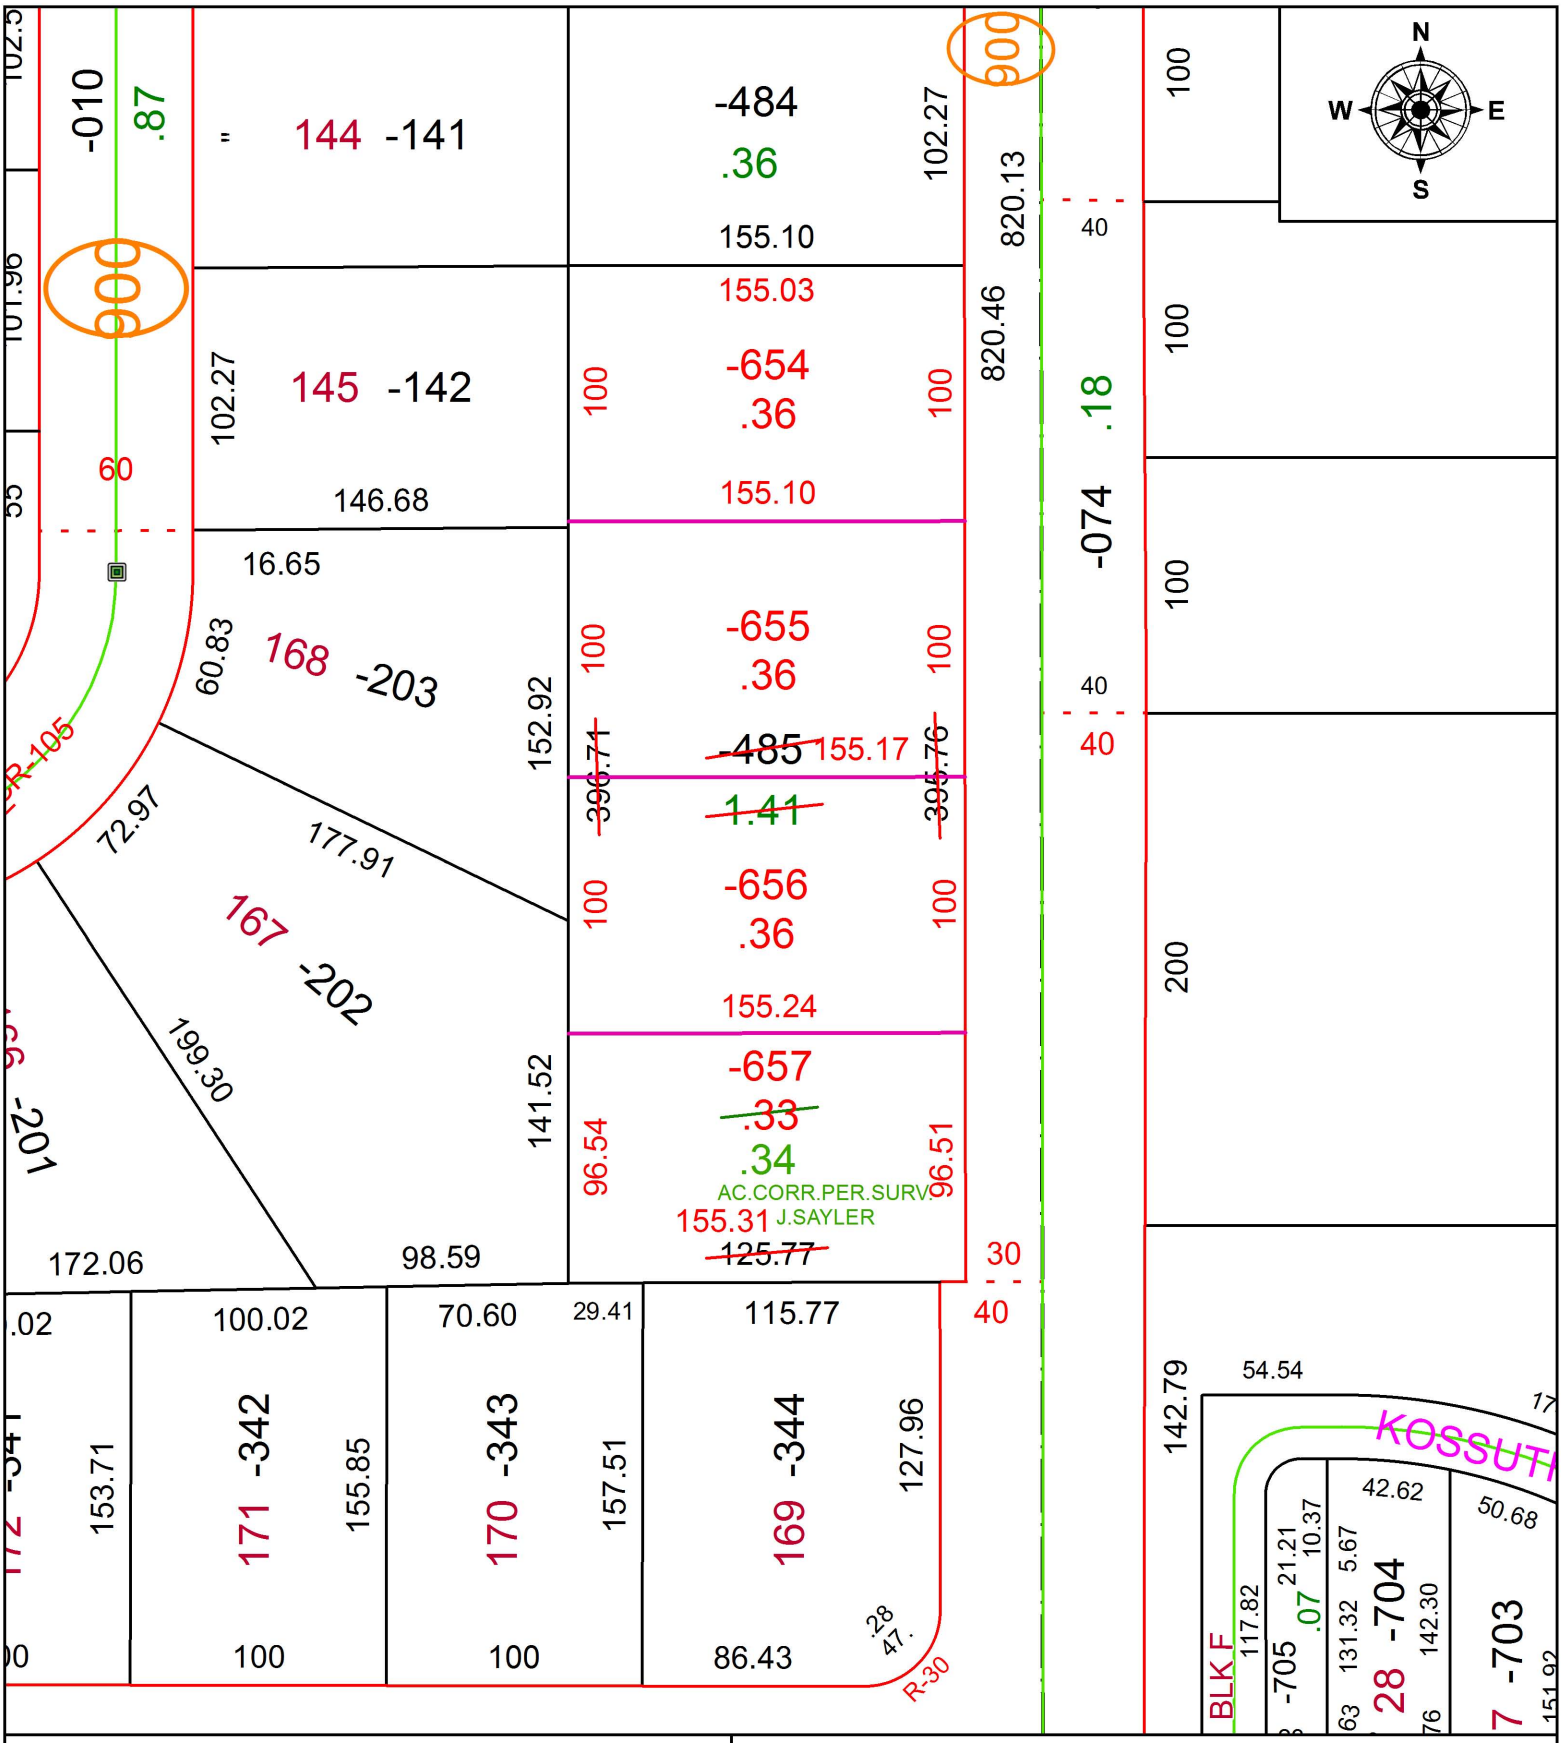

SPLITS/DEEDS PROCESSED

LORAIN COUNTY TAX MAP DEPARTMENT
226 MIDDLE AVE. ELYRIA, OH

SURVEYED BY: JAMES T. SAYLER
CLOSURE: 1: 1,711,103
MAP PAGE(S): 4-00-020
APPOVED BY: RRM **DATE:** 5-14-18
SCALE: 1" = 75 **PRIOR INSTRUMENT:** 20170644303