PARENT PARCEL: 02-01-003-110-008
CHILD PARCEL: XX-XX-XXX-XXX-XXX
STARTING POINT: INTERSECTION OF NORTH LINE OF COLORADO AVE. AND WEST LINE OF ALLEY

17-03815-A

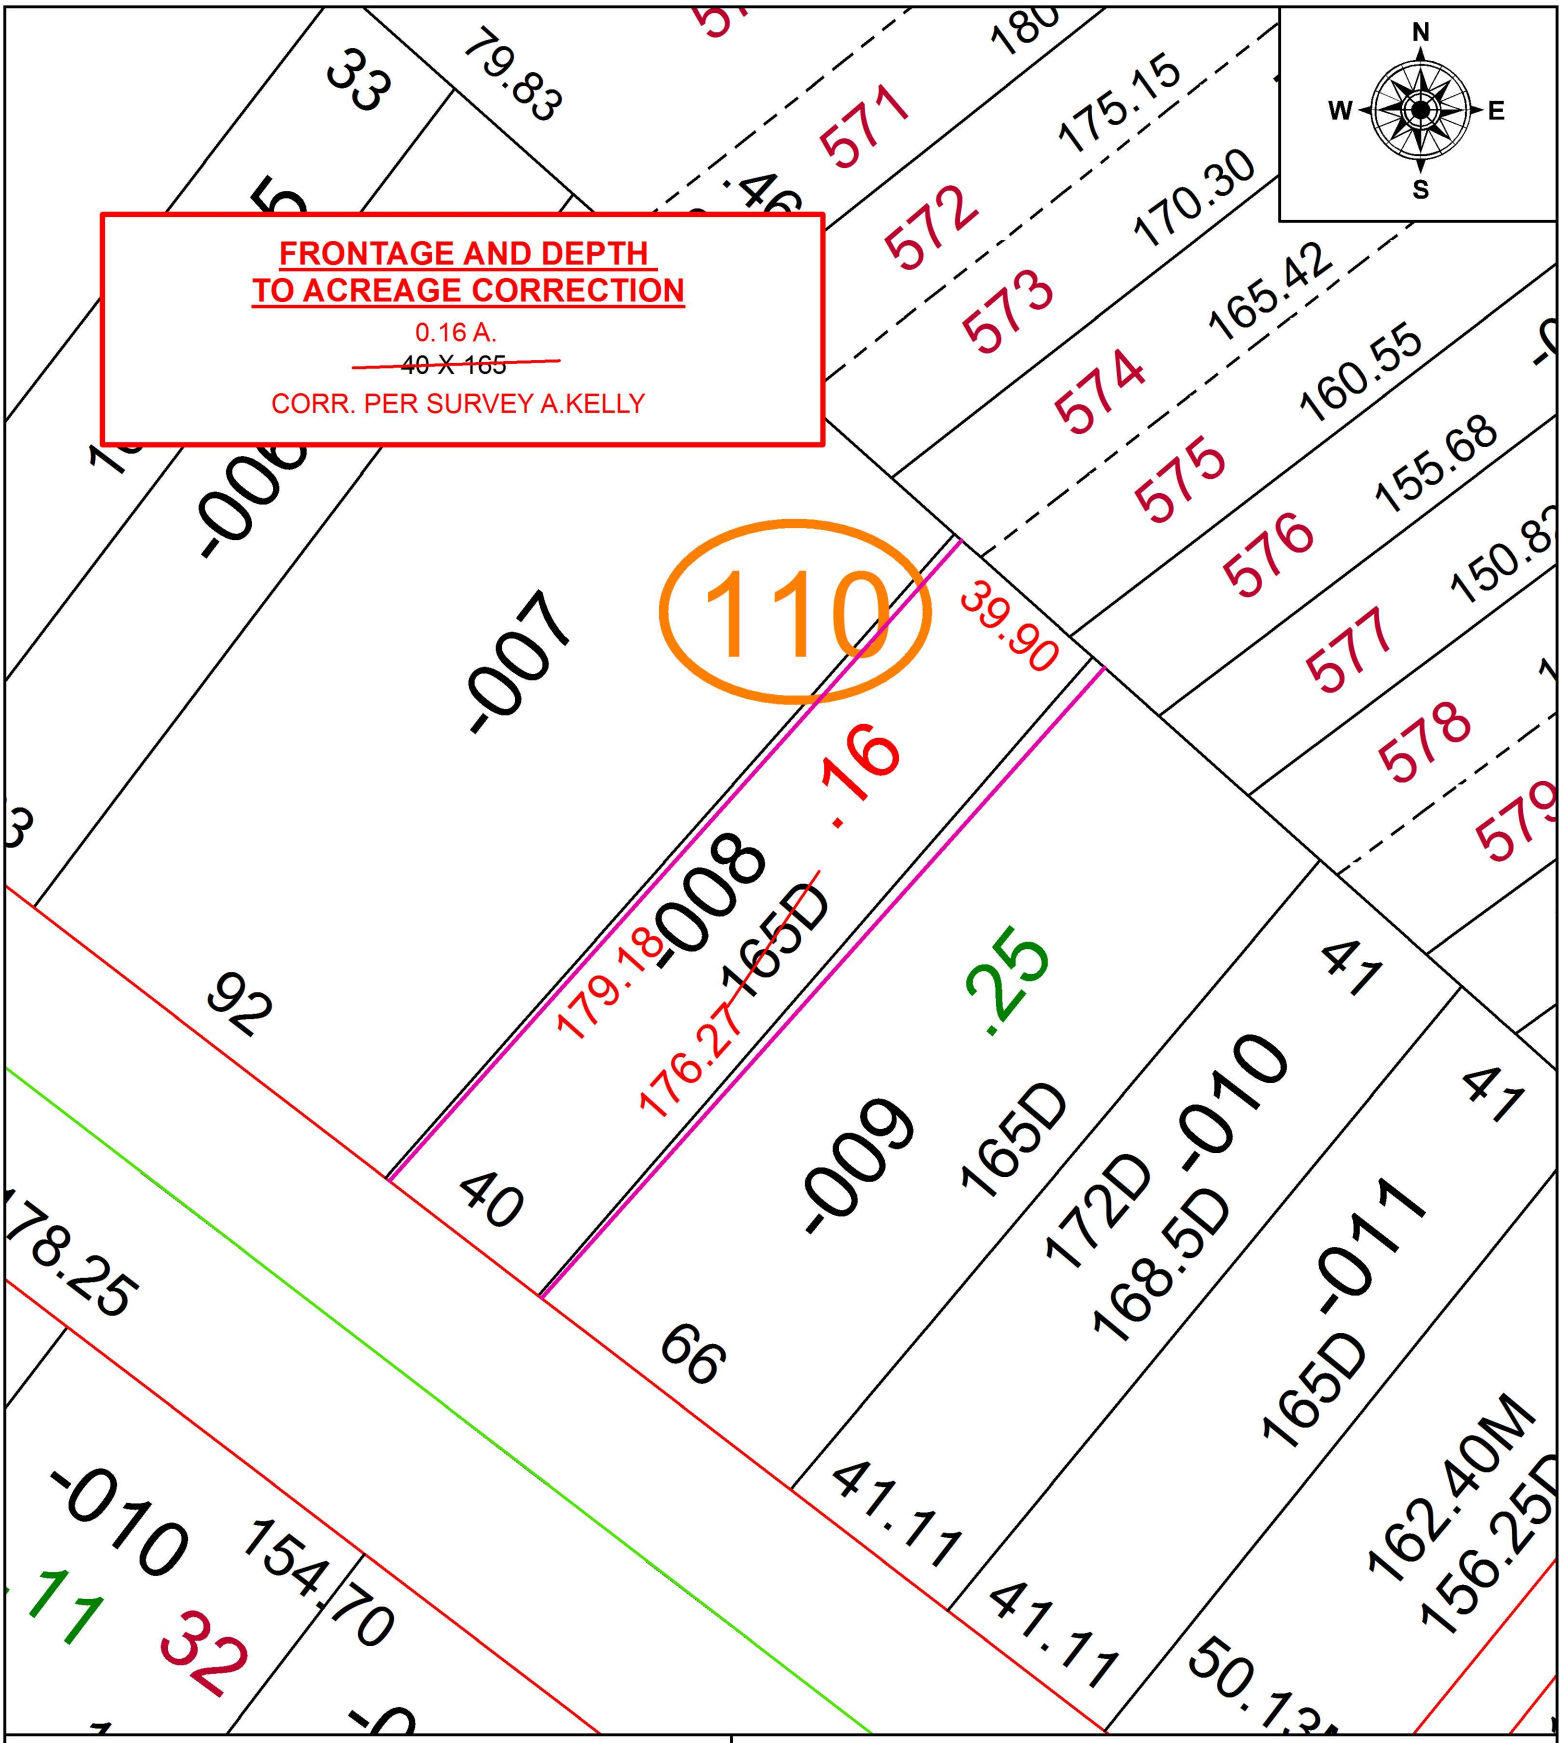

SPLITS/DEEDS PROCESSED
LORAIN COUNTY TAX MAP DEPARTMENT
226 MIDDLE AVE. ELYRIA, OH

SURVEYED BY: AMY M. KELLY
CLOSURE: 1: 59,825
MAP PAGE(S): 2-01-003
APPOVED BY: RRM **DATE:** 12-18-17
SCALE: 1" = 40 **PRIOR INSTRUMENT:** 19990649528