PARENT PARCEL: 06-23-016-101-044

CHILD PARCEL: 06-23-016-101-053, -054

STARTING POINT: INTERSECTION OF C/L OF S.R. 57 AND C/L OF GRISWOLD RD.

18-03815

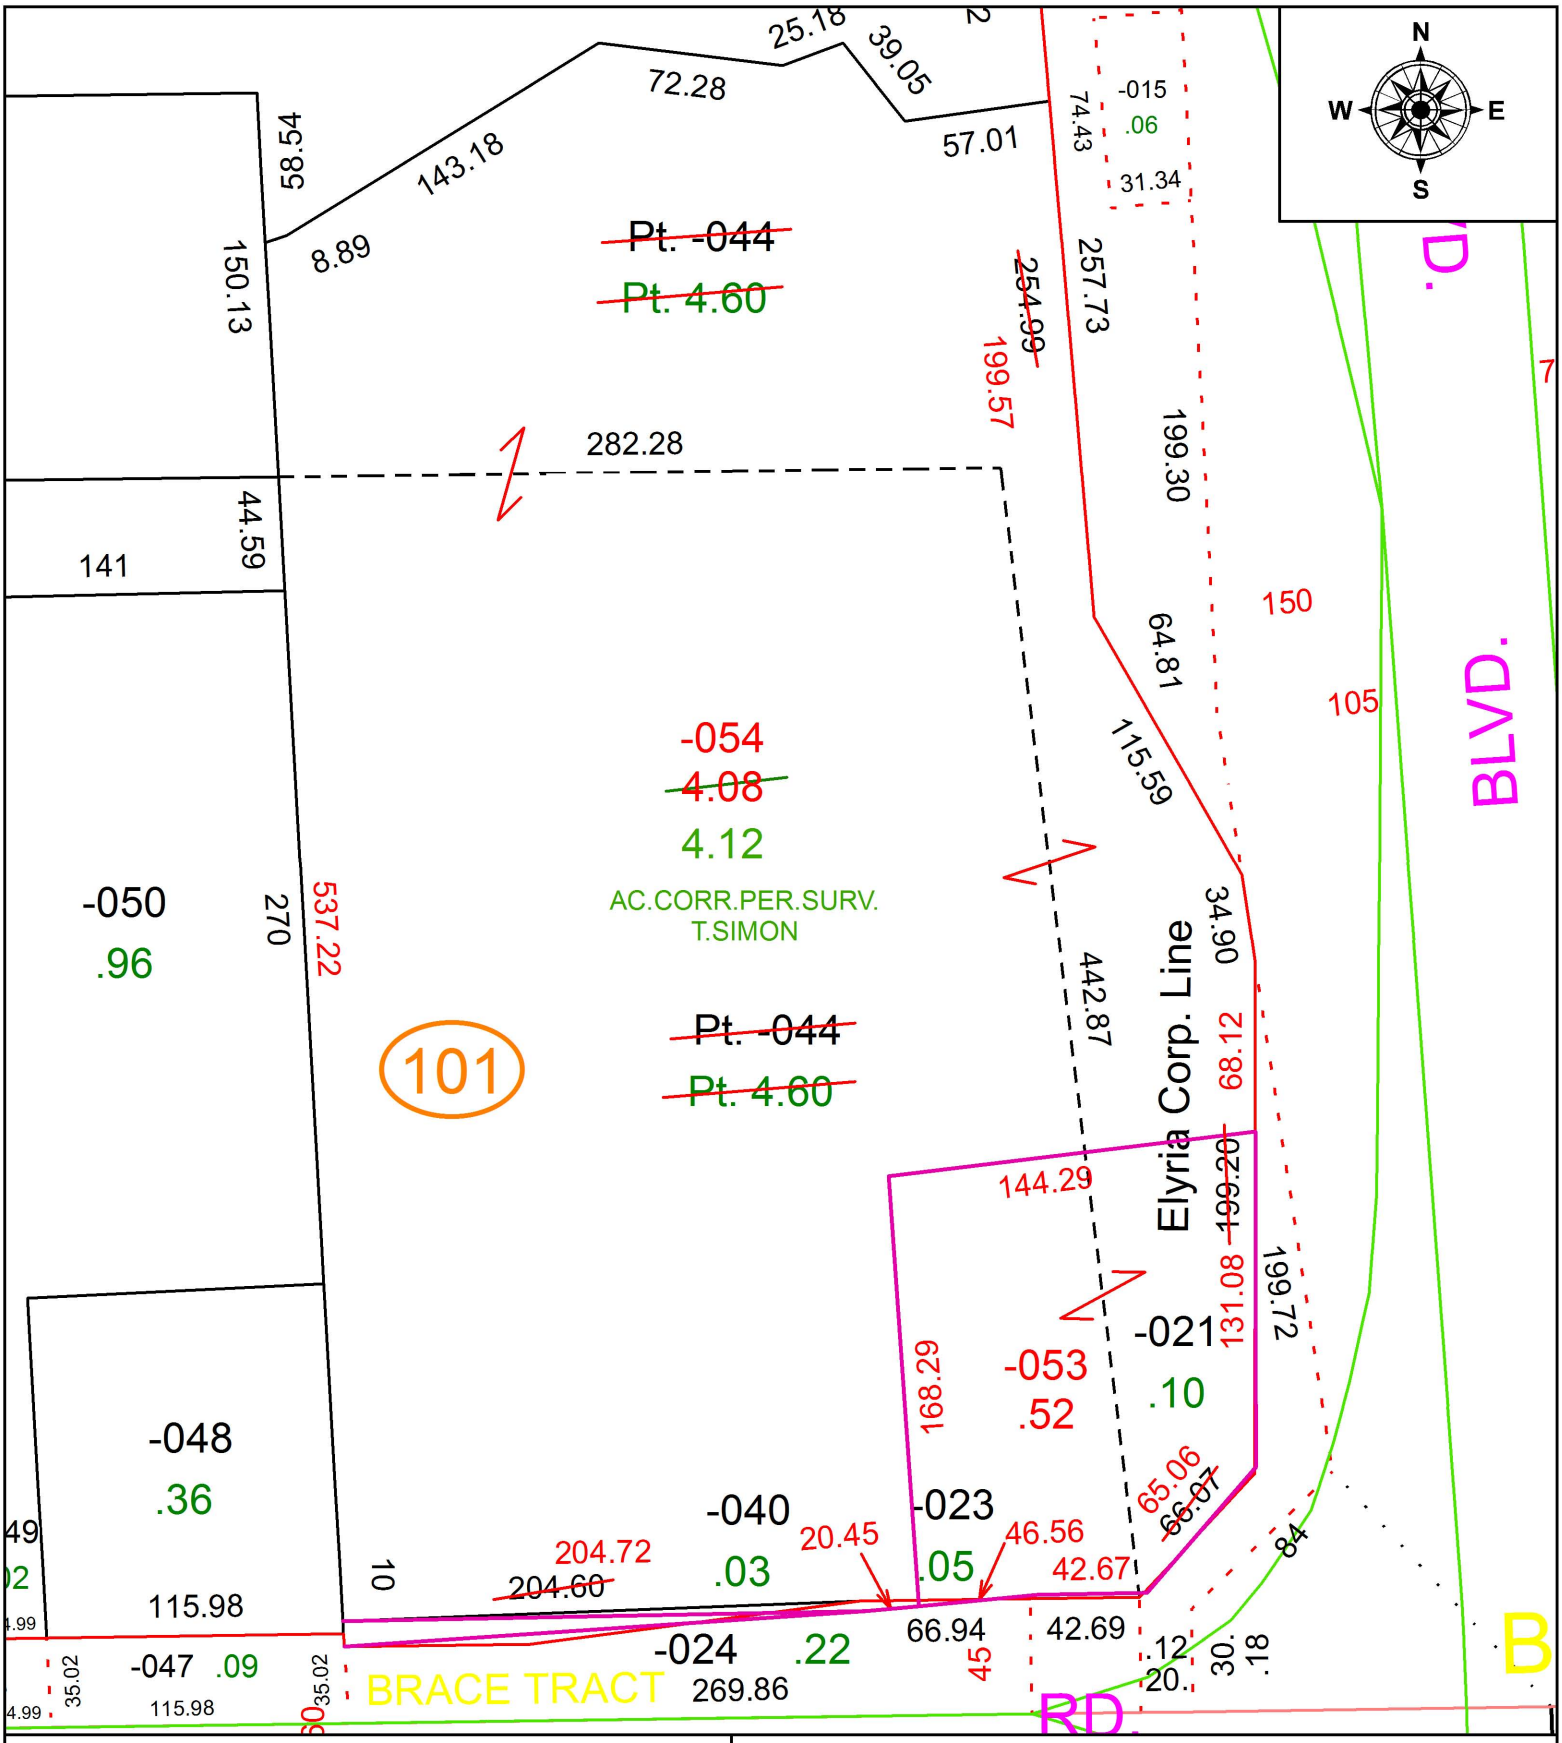

SPLITS/DEEDS PROCESSED

LORAIN COUNTY TAX MAP DEPARTMENT
226 MIDDLE AVE. ELYRIA, OH

SURVEYED BY: THOMAS A. SIMON
CLOSURE: 1: 190,252
MAP PAGE(S): 6-45
APPOVED BY: RRM **DATE:** 5-21-18
SCALE: 1" = 75 **PRIOR INSTRUMENT:** 20040999439