PARENT PARCEL: 10-00-008-112-014
CHILD PARCEL: XX-XX-XXX-XXX-XXX
STARTING POINT: INTERSECTION OF C/L OF LAGRANGE RD. AND C/L OF CARLISLE RD.

17-03816-D

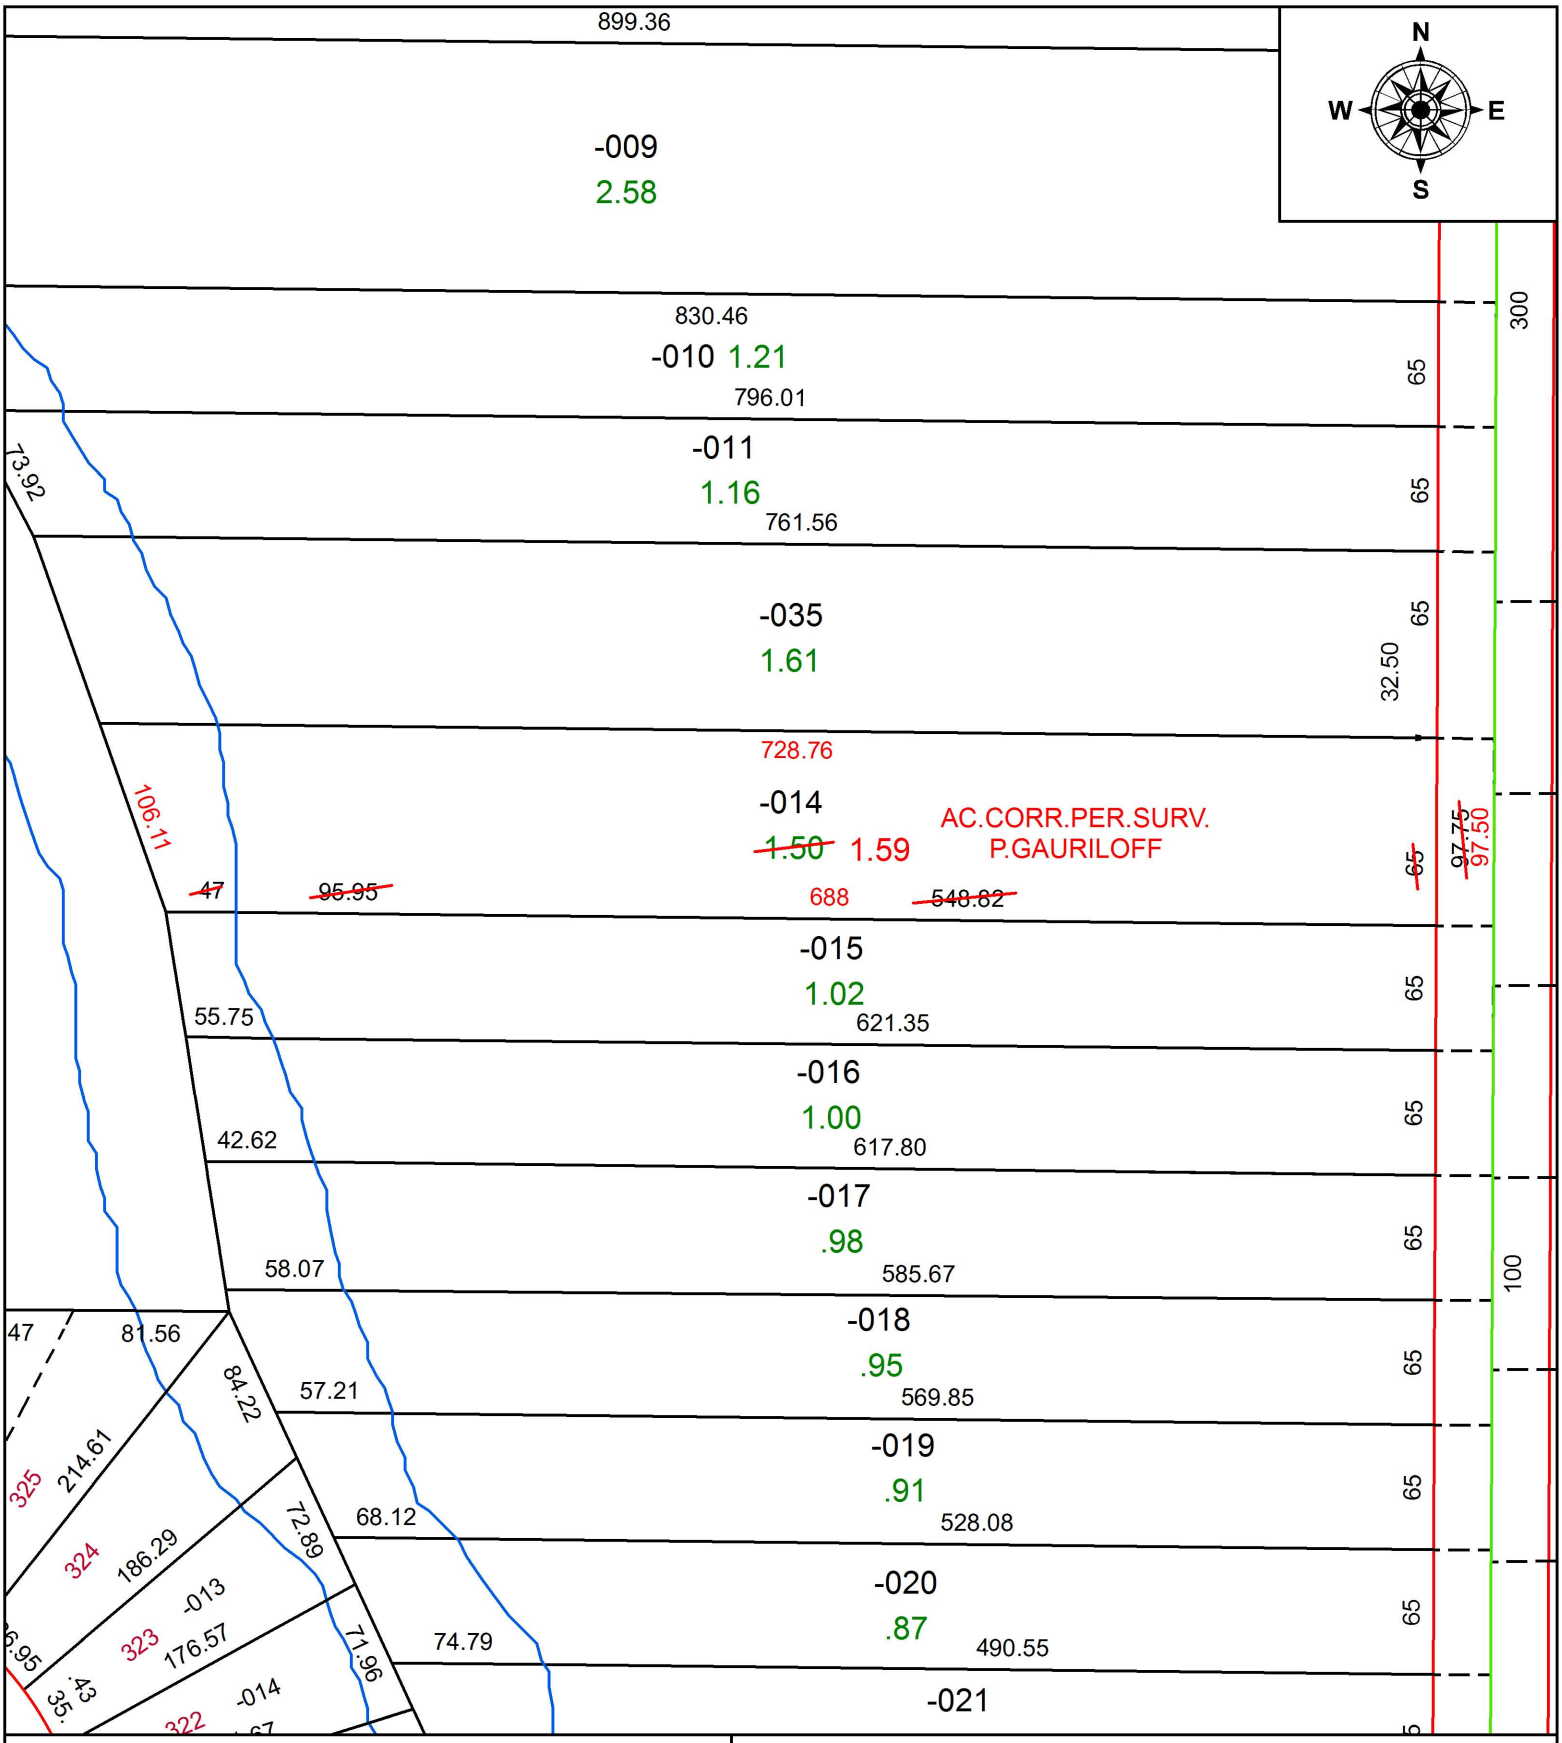

SPLITS/DEEDS PROCESSED
LORAIN COUNTY TAX MAP DEPARTMENT
226 MIDDLE AVE. ELYRIA, OH

SURVEYED BY: PETER JOHN GAURILOFF
CLOSURE: 1: 422,719
MAP PAGE(S): 10-00-008
APPOVED BY: RRM **DATE:** 12-18-17
SCALE: 1" = 100 **PRIOR INSTRUMENT:** 20170648757