PARENT PARCEL: 18-00-020-000-064, -127
CHILD PARCEL: 18-00-020-000-144 THRU -146
STARTING POINT: SOUTHEAST CORNER OF O.L.20

18-03817

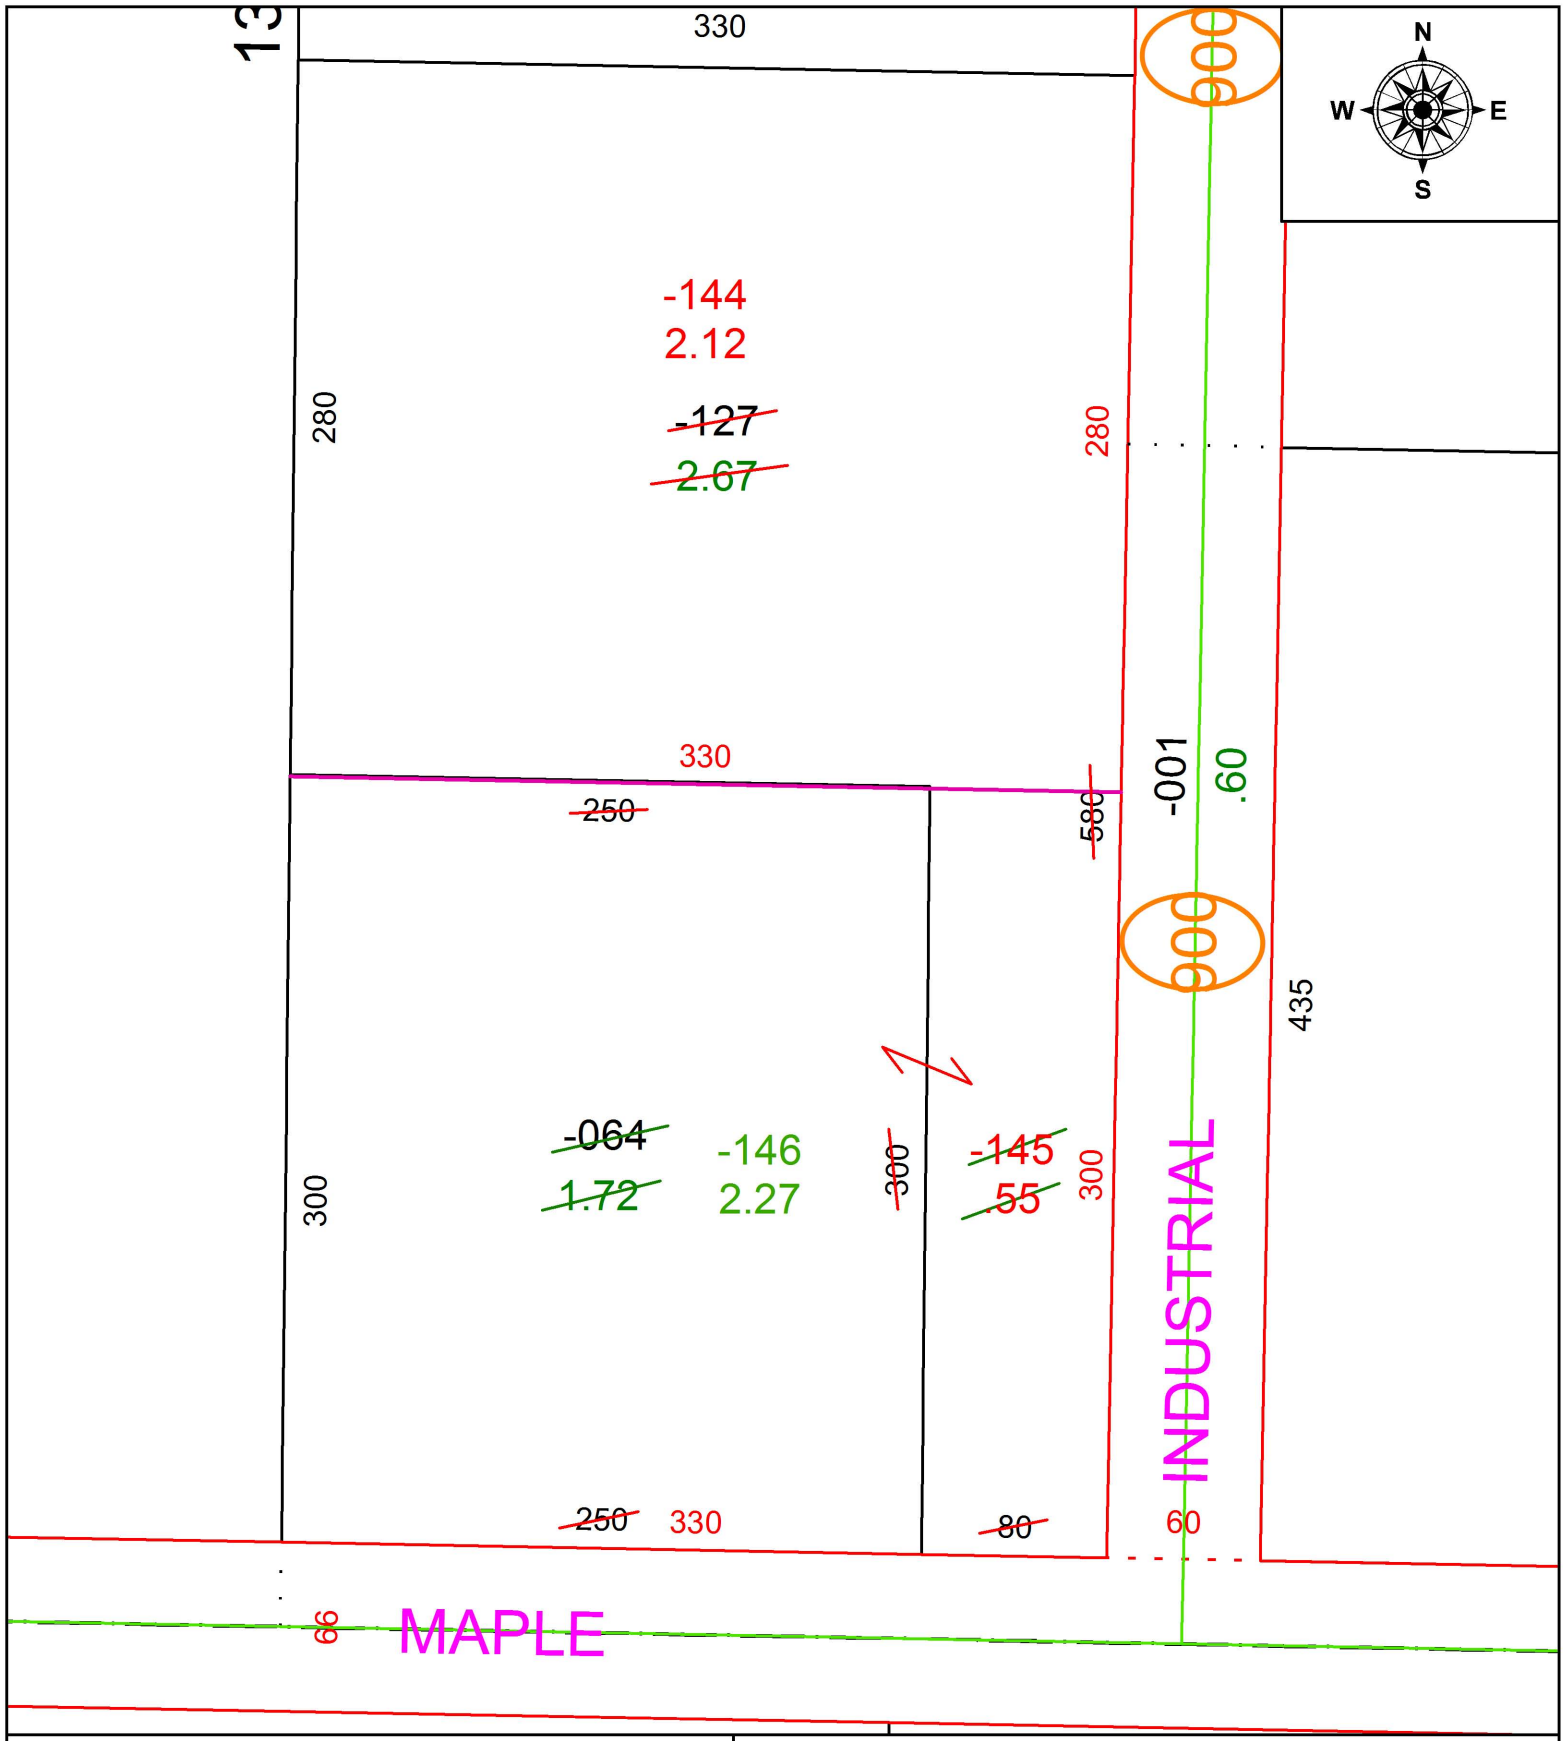

SPLITS/DEEDS PROCESSED
LORAIN COUNTY TAX MAP DEPARTMENT
226 MIDDLE AVE. ELYRIA, OH

SURVEYED BY: KEVIN CANAVAN
CLOSURE: 1: 2147483648
MAP PAGE(S): 18-00-020
APPOVED BY: RRM **DATE:** 5-22-18
SCALE: 1" = 75 **PRIOR INSTRUMENT:** 20110384109