PARENT PARCEL: 06-24-035-101-020, 06-24-042-000-006

CHILD PARCEL: XX-XX-XXX-XXX-XXX

STARTING POINT: INTERSECTION OF NORTH LINE OF SAMUEL ST. AND WEST LINE OF LAKE AVE.

17-03818-D

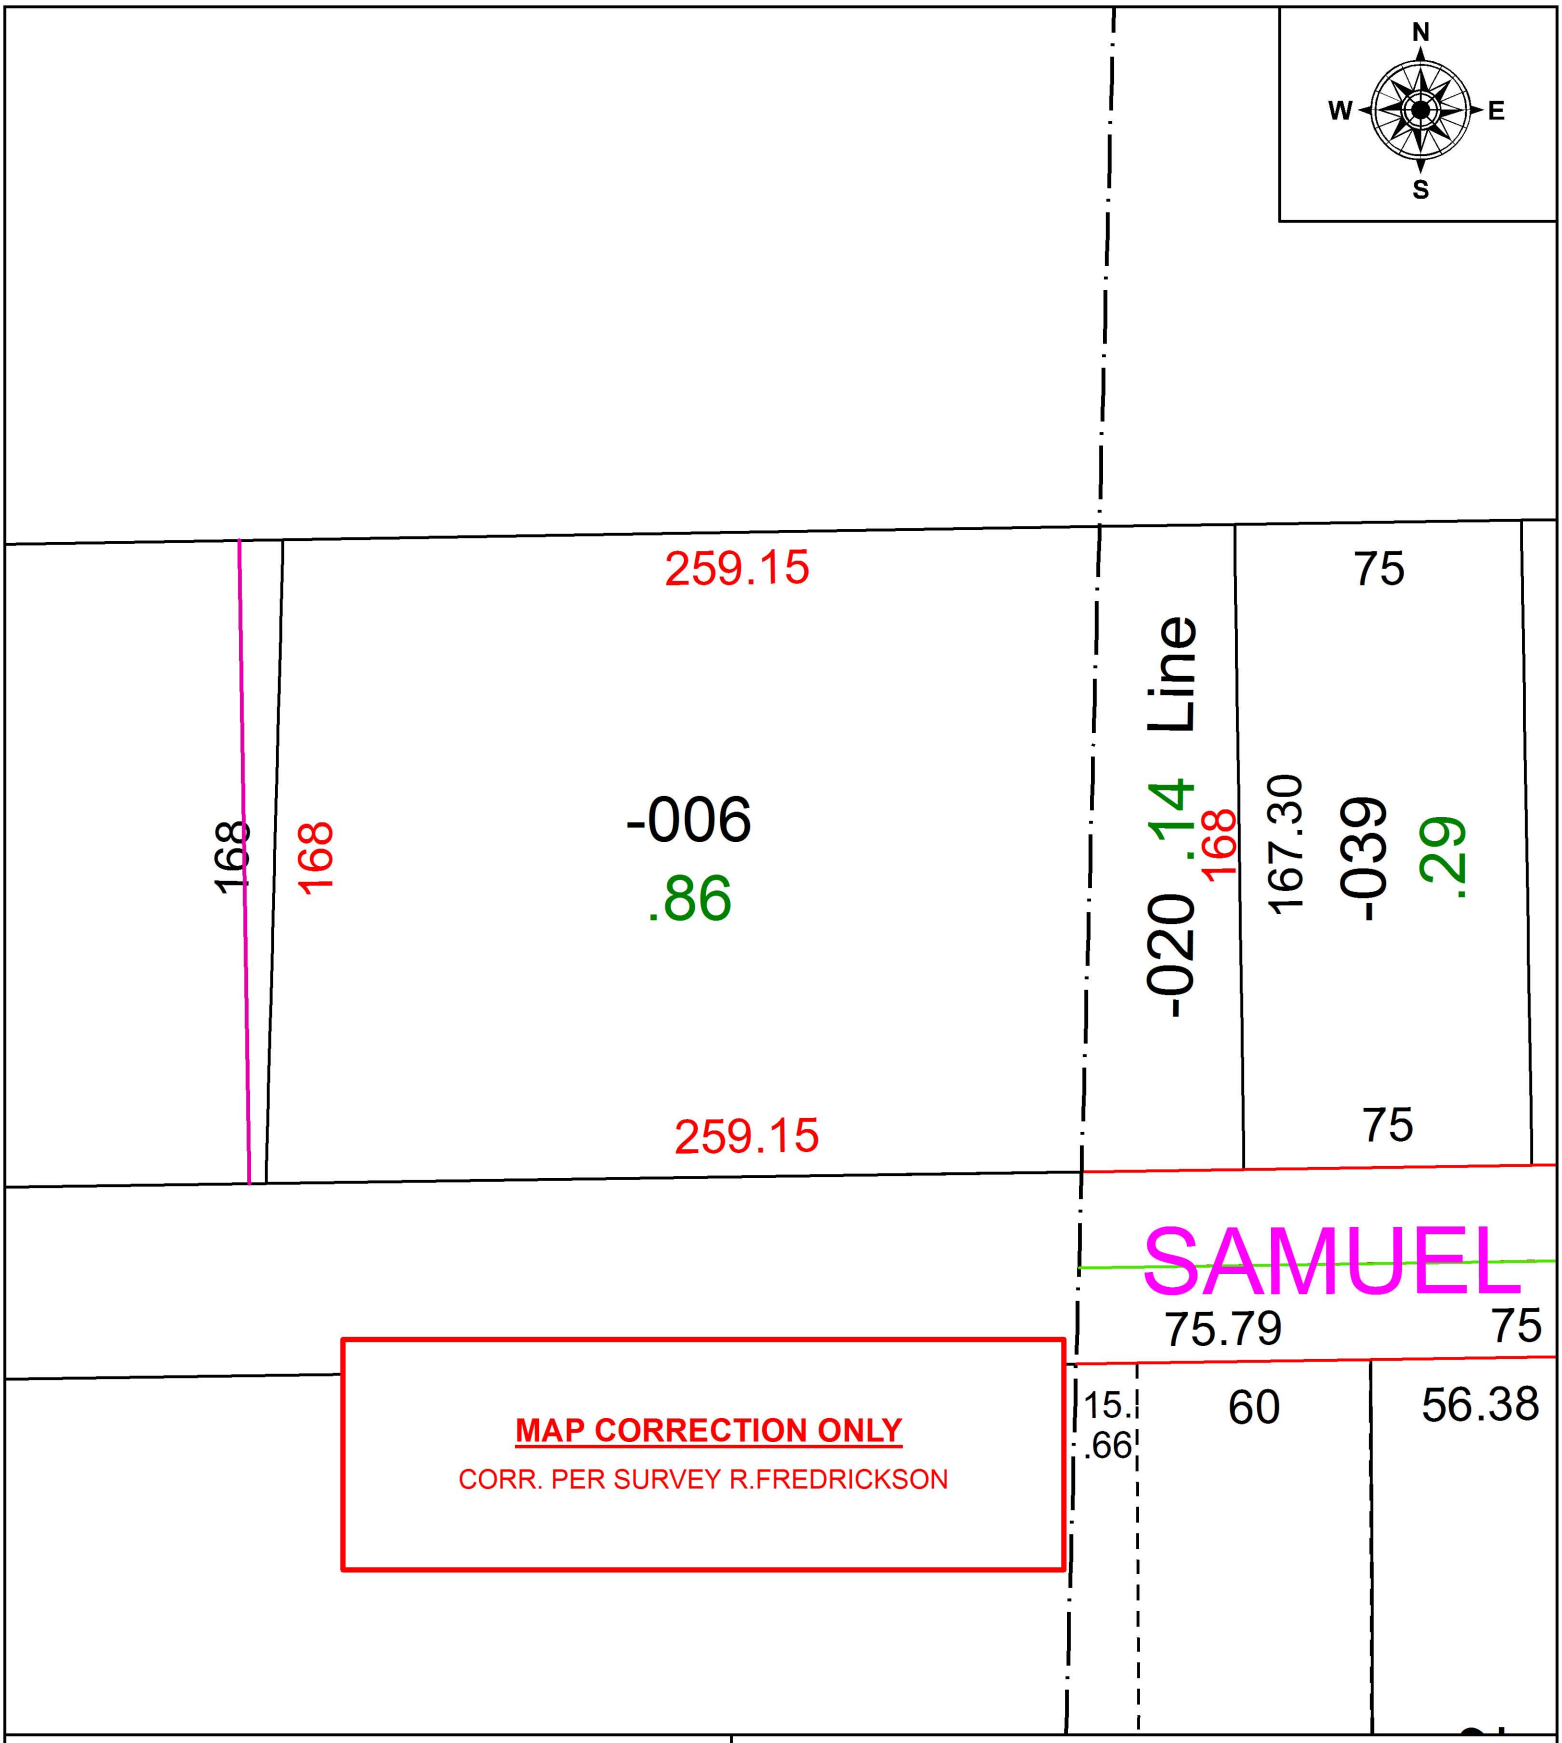

SPLITS/DEEDS PROCESSED

LORAIN COUNTY TAX MAP DEPARTMENT
226 MIDDLE AVE. ELYRIA, OH

SURVEYED BY: RICHARD A, FREDRICKSON
CLOSURE: 1: 2147483648
MAP PAGE(S): 6-59
APPOVED BY: RRM **DATE:** 12-21-17
SCALE: 1" = 50 **PRIOR INSTRUMENT:** 20140518093