PARENT PARCEL: 05-00-004-102-012
CHILD PARCEL: XX-XX-XXX-XXX-XXX
STARTING POINT: INTERSECTION OF C/L OF MILAN AVE AND WEST LINE OF GEORGE VOLLMER (DV 203/434)

18-03821-A

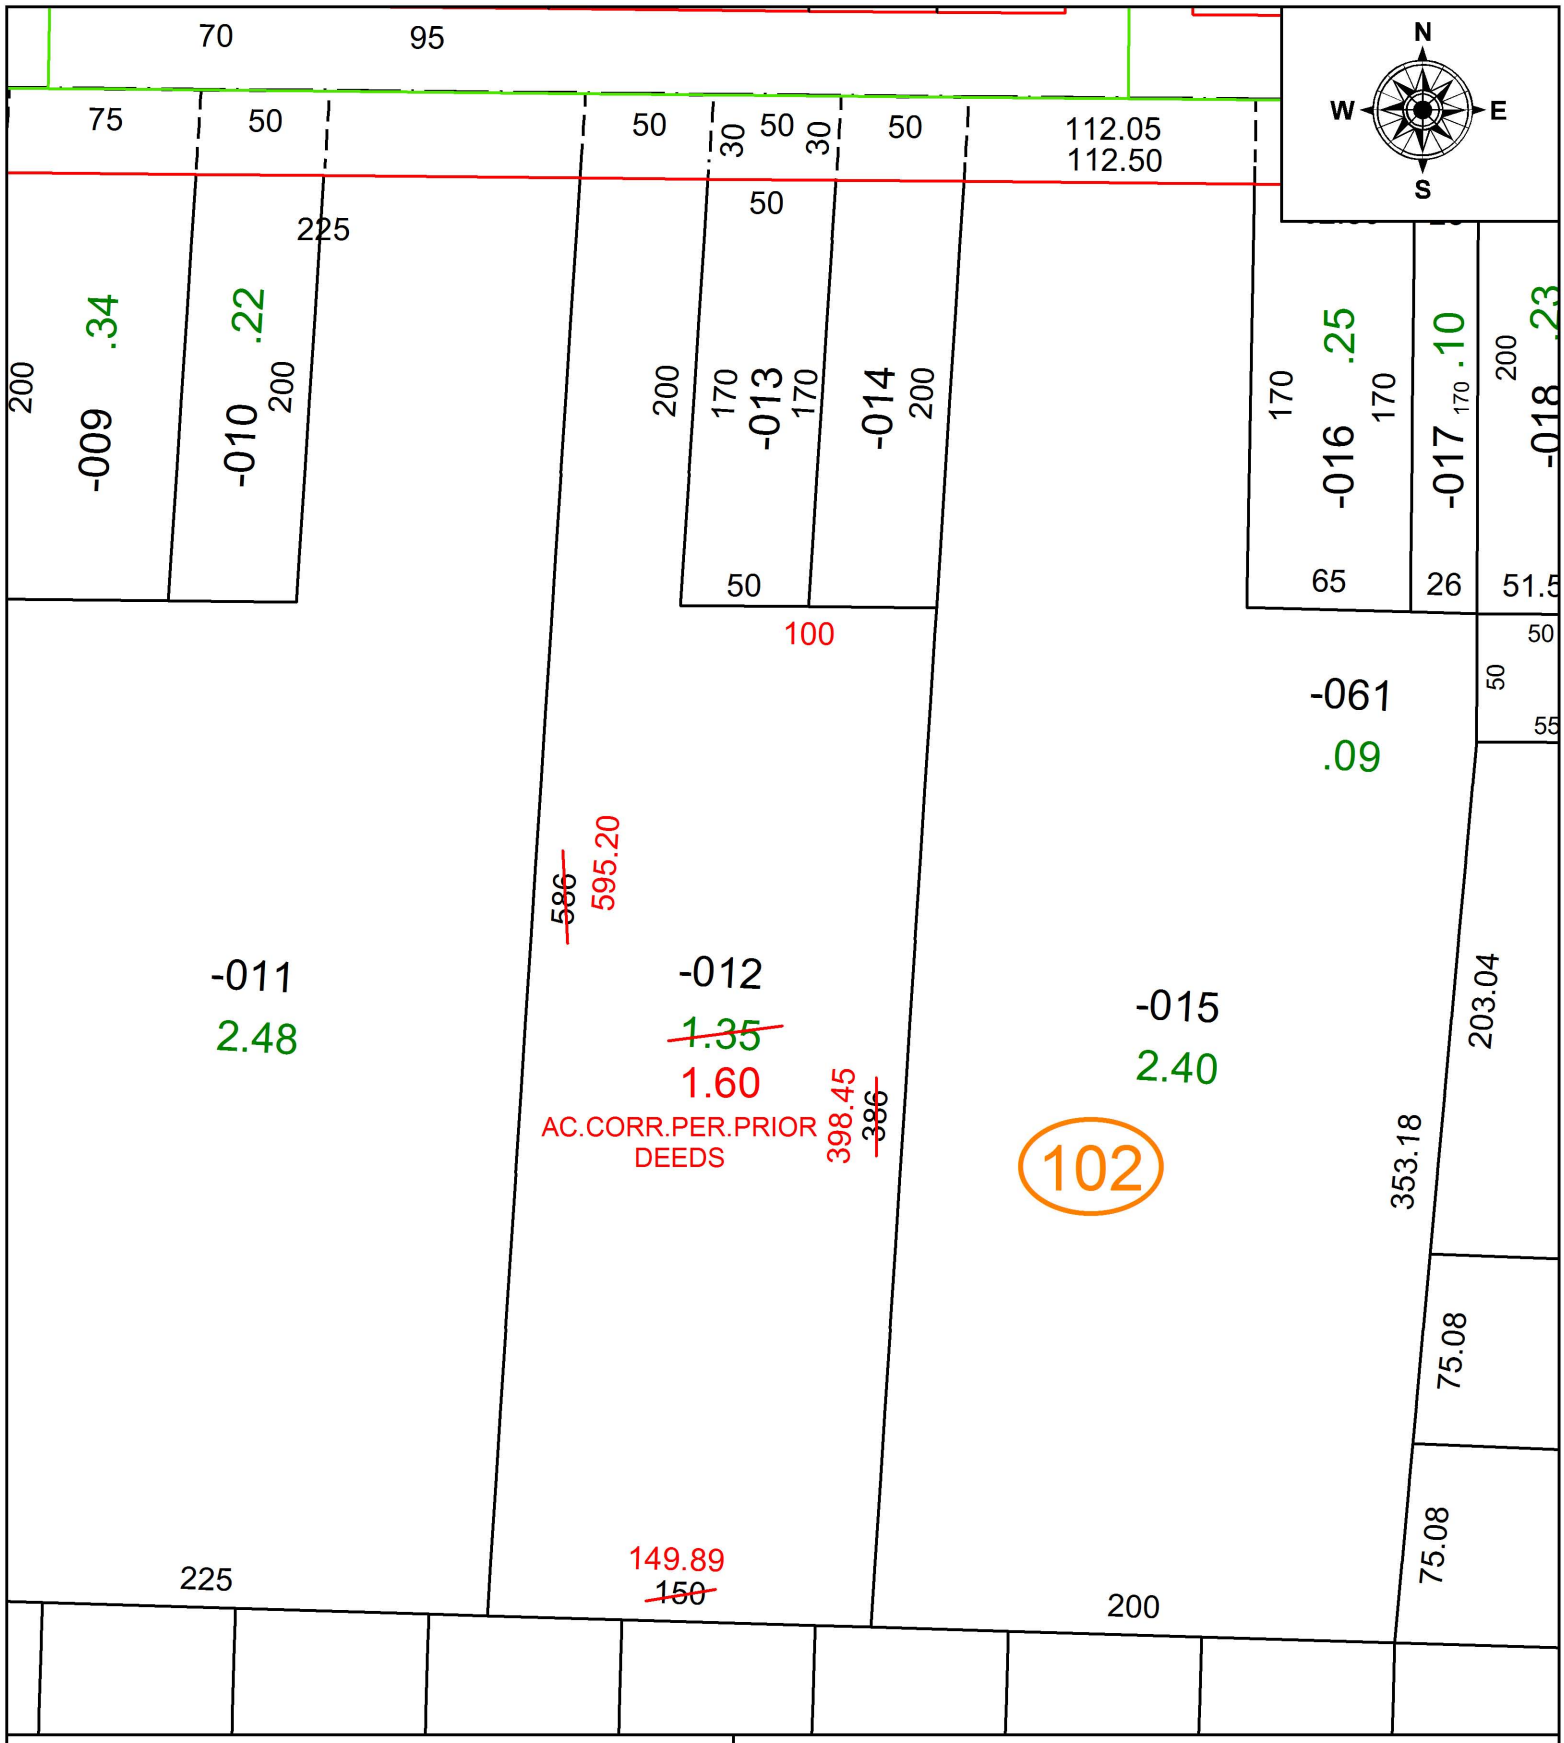

SPLITS/DEEDS PROCESSED
LORAIN COUNTY TAX MAP DEPARTMENT
226 MIDDLE AVE. ELYRIA, OH

SURVEYED BY: N/A
CLOSURE: N/A
MAP PAGE(S): 5-00-004
APPOVED BY: RRM **DATE:** 1-10-18
SCALE: 1" = 75 **PRIOR INSTRUMENT:** DV 1214/826