PARENT PARCEL: 12-00-077-000-002
CHILD PARCEL: XX-XX-XXX-XXX-XXX
STARTING POINT: INTERSECTION OF C/L OF STATION RD. AND C/L OF NICHOLS RD.

18-03823-D

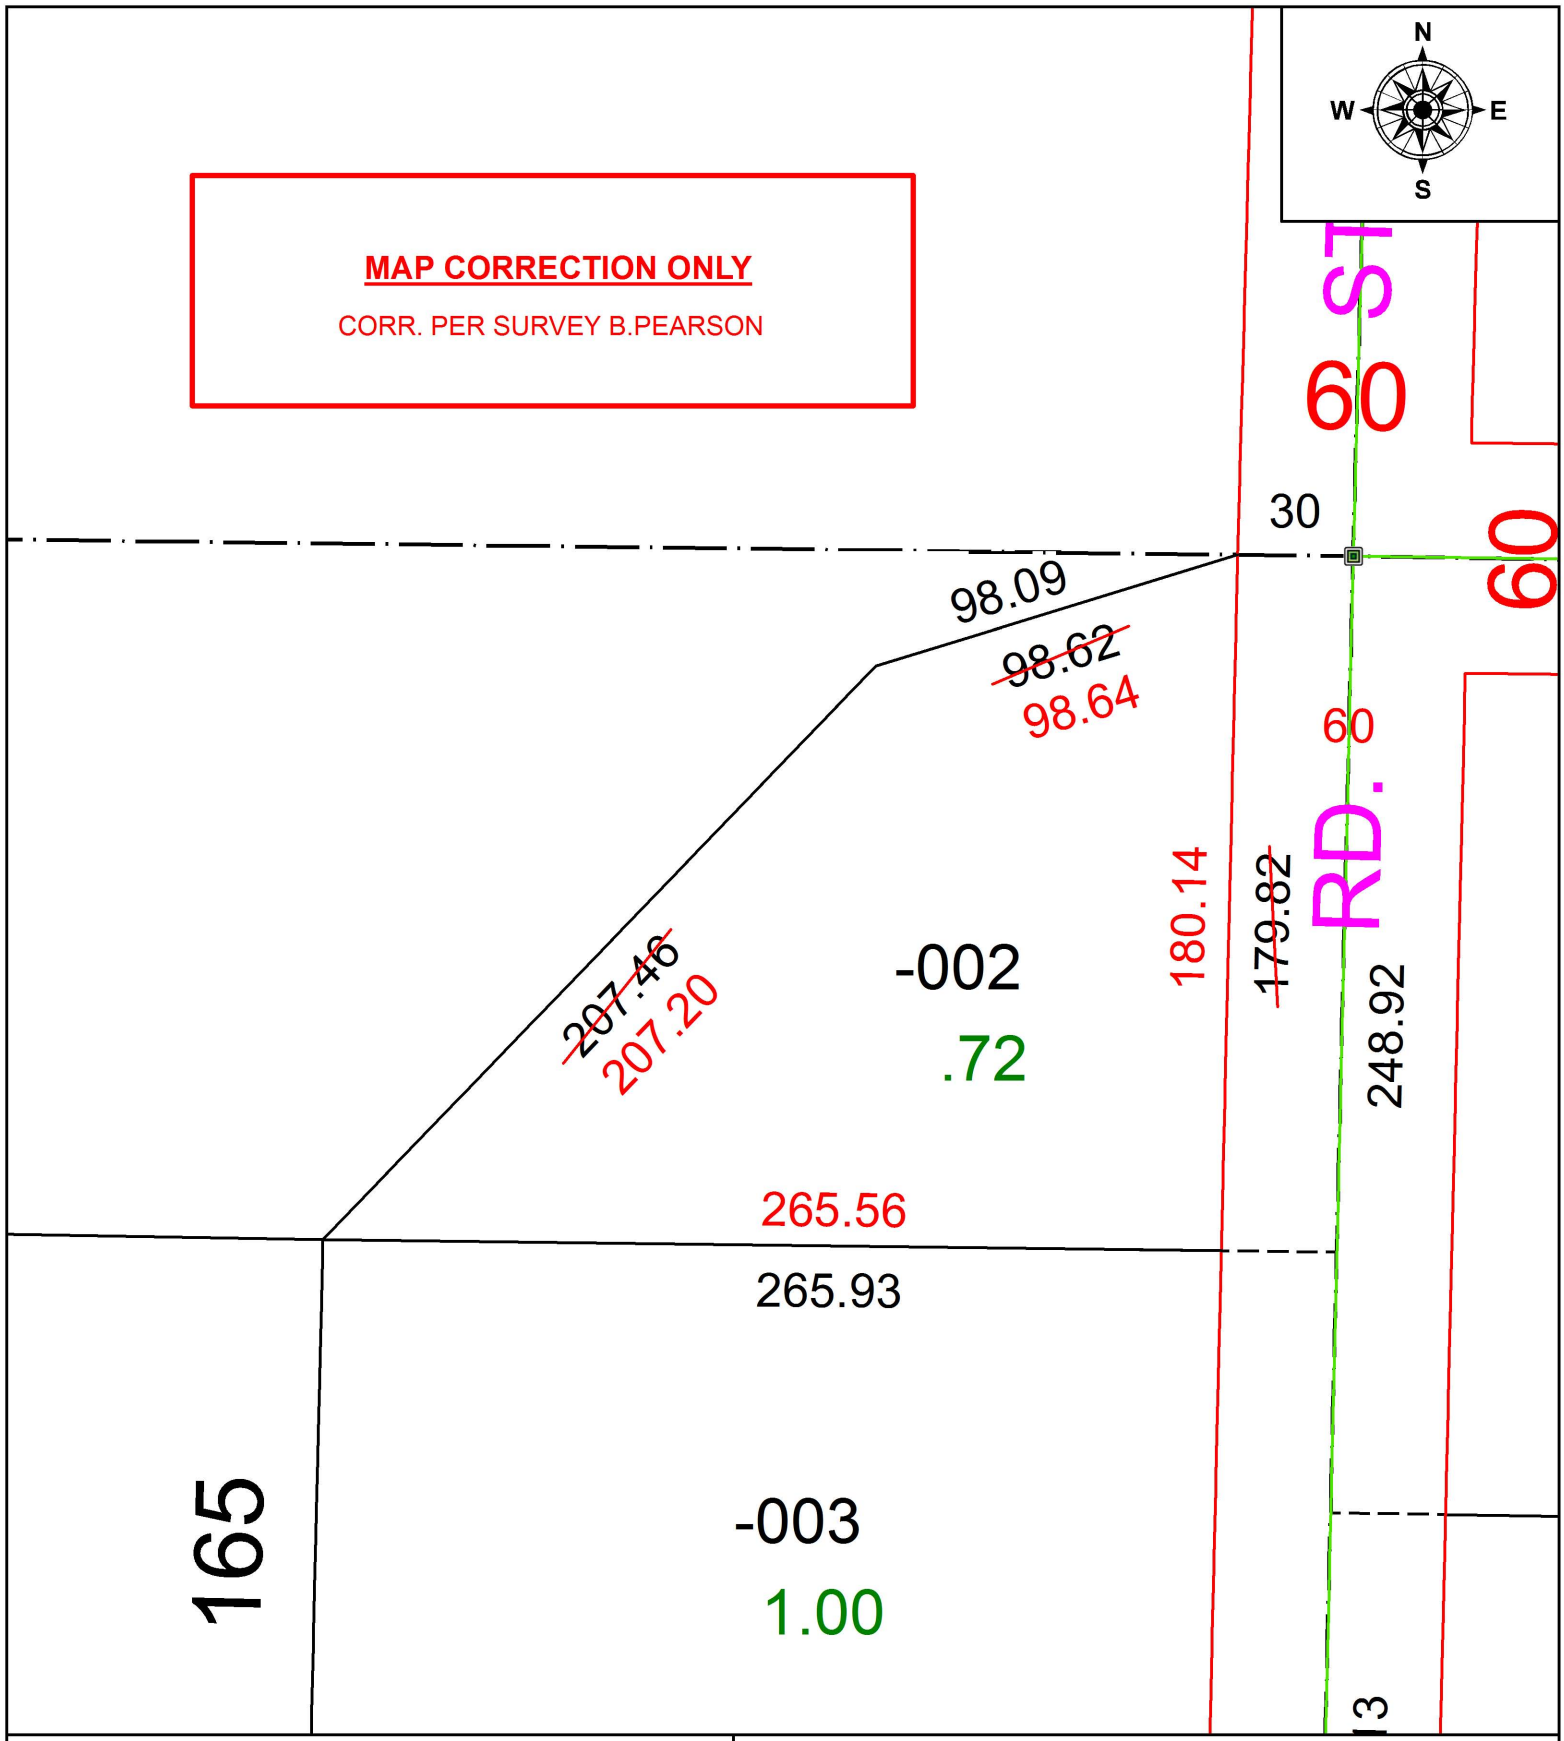

SPLITS/DEEDS PROCESSED
LORAIN COUNTY TAX MAP DEPARTMENT
226 MIDDLE AVE. ELYRIA, OH

SURVEYED BY: BETH A. PEARSON
CLOSURE: 1: 227,191
MAP PAGE(S): 12-00-077
APPOVED BY: RRM **DATE:** 1-25-18
SCALE: 1" = 50 **PRIOR INSTRUMENT:** 20160573803