**PARENT PARCEL:** 09-00-013-102-059, 09-00-014-101-062

**CHILD PARCEL:** XX-XX-XXX-XXX-XXX

**STARTING POINT:** INTERSECTION OF C/L OF SOUTH LAKE ST. AND C/L OF RUSSIA RD.

# 18-03824-A

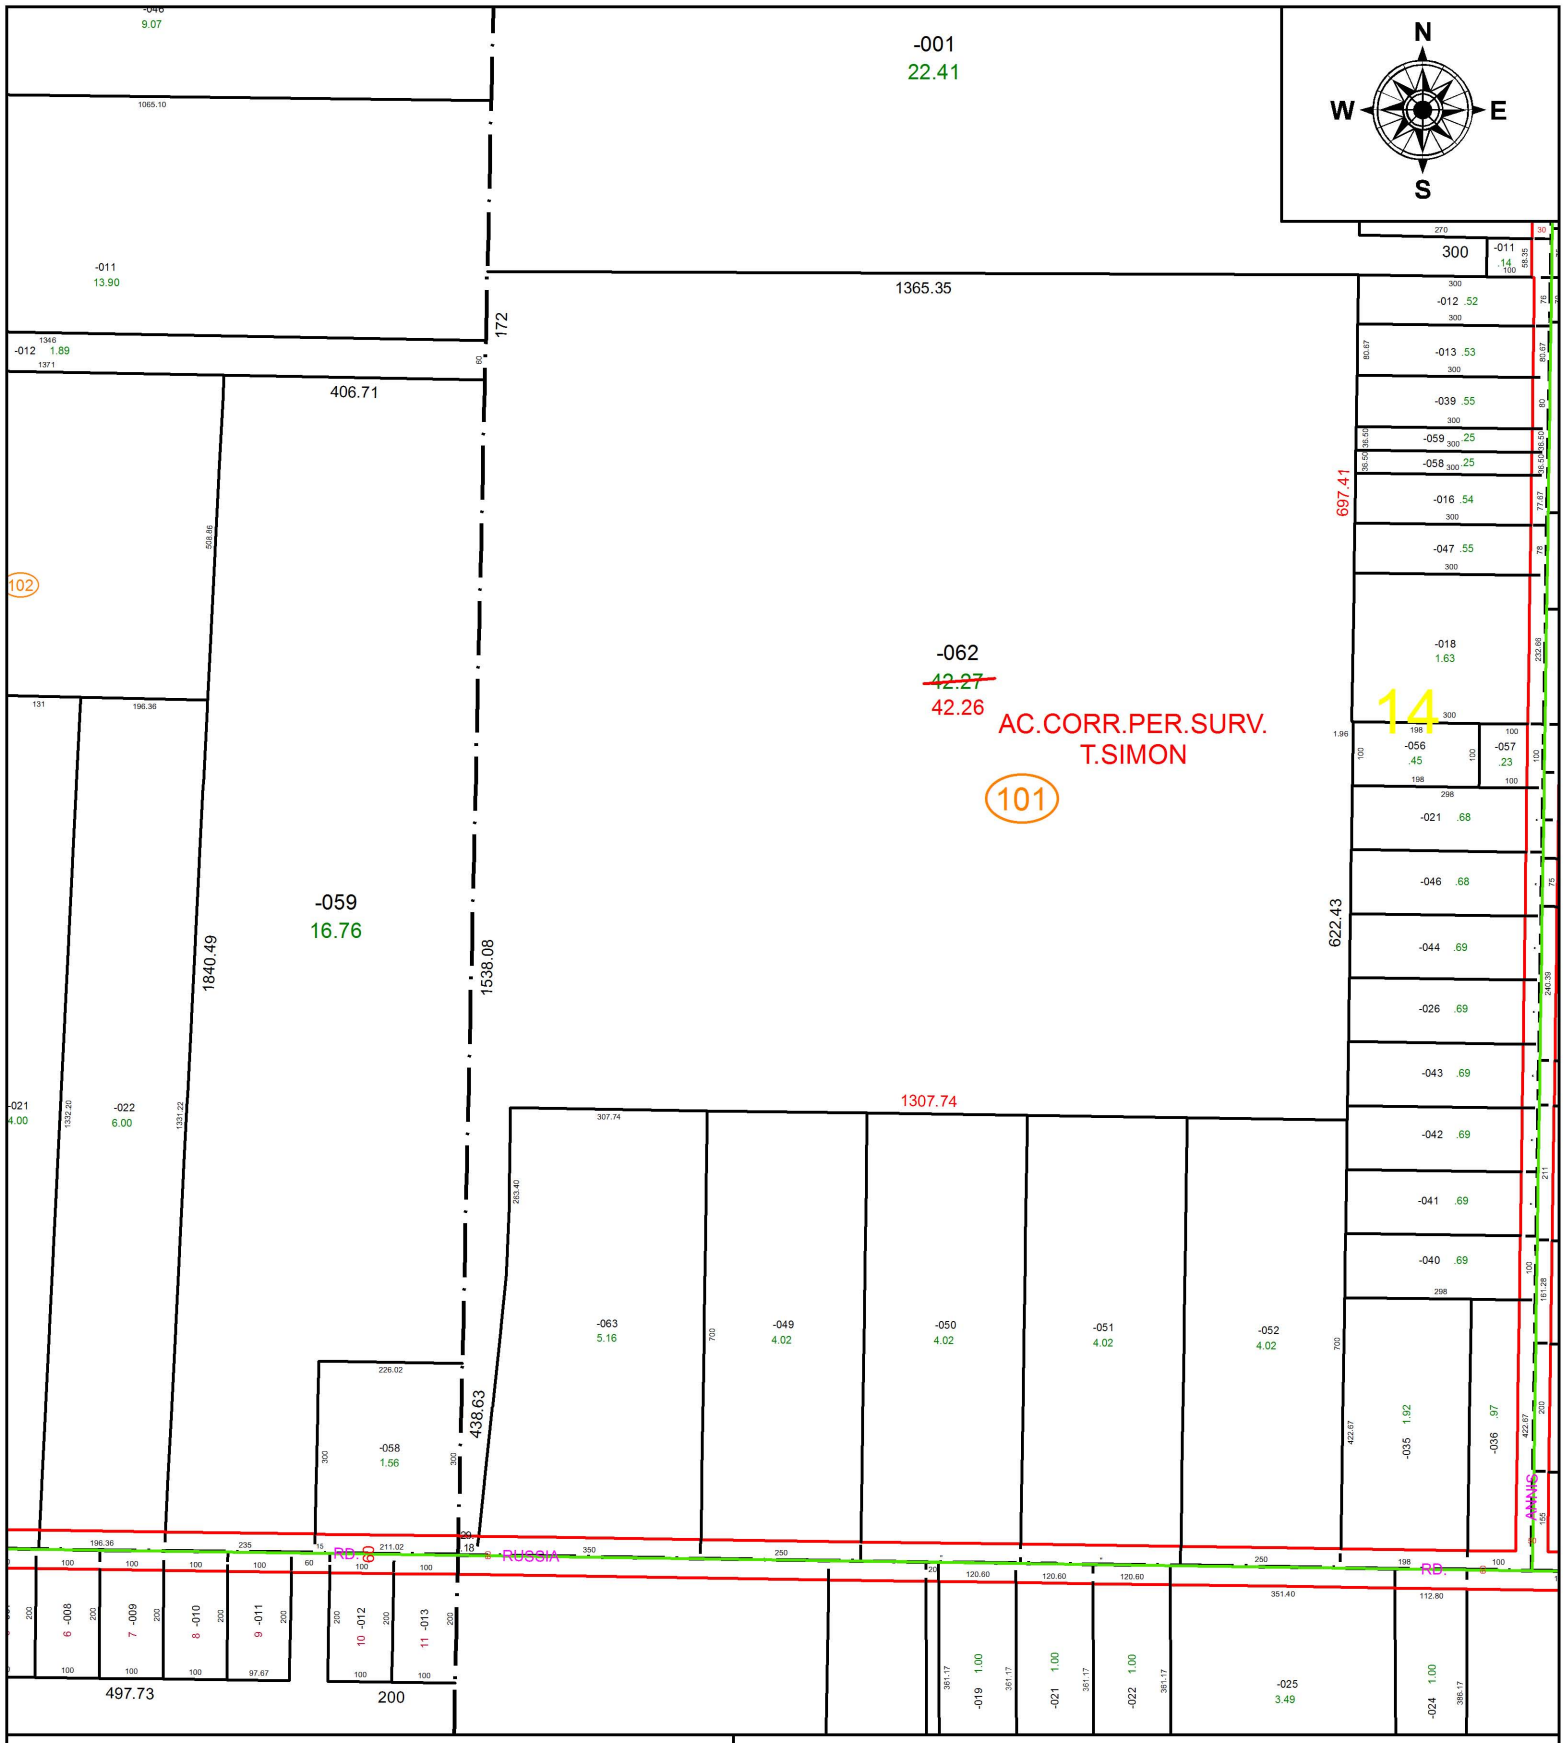


**SPLITS/DEEDS PROCESSED**

LORAIN COUNTY TAX MAP DEPARTMENT
226 MIDDLE AVE. ELYRIA, OH

**SURVEYED BY:** THOMAS A. SIMON
**CLOSURE:** 1: 540,008
**MAP PAGE(S):** 9-00-014
**APPOVED BY:** RRM **DATE:** 1-25-18
**SCALE:** 1" = 300 **PRIOR INSTRUMENT:** 20130487016