PARENT PARCEL: 15-00-044-000-020
CHILD PARCEL: XX-XX-XXX-XXX-XXX
STARTING POINT: INTERSECTION OF C/L OF WHITEHEAD RD. AND C/L OF S.R.303

18-03826-D

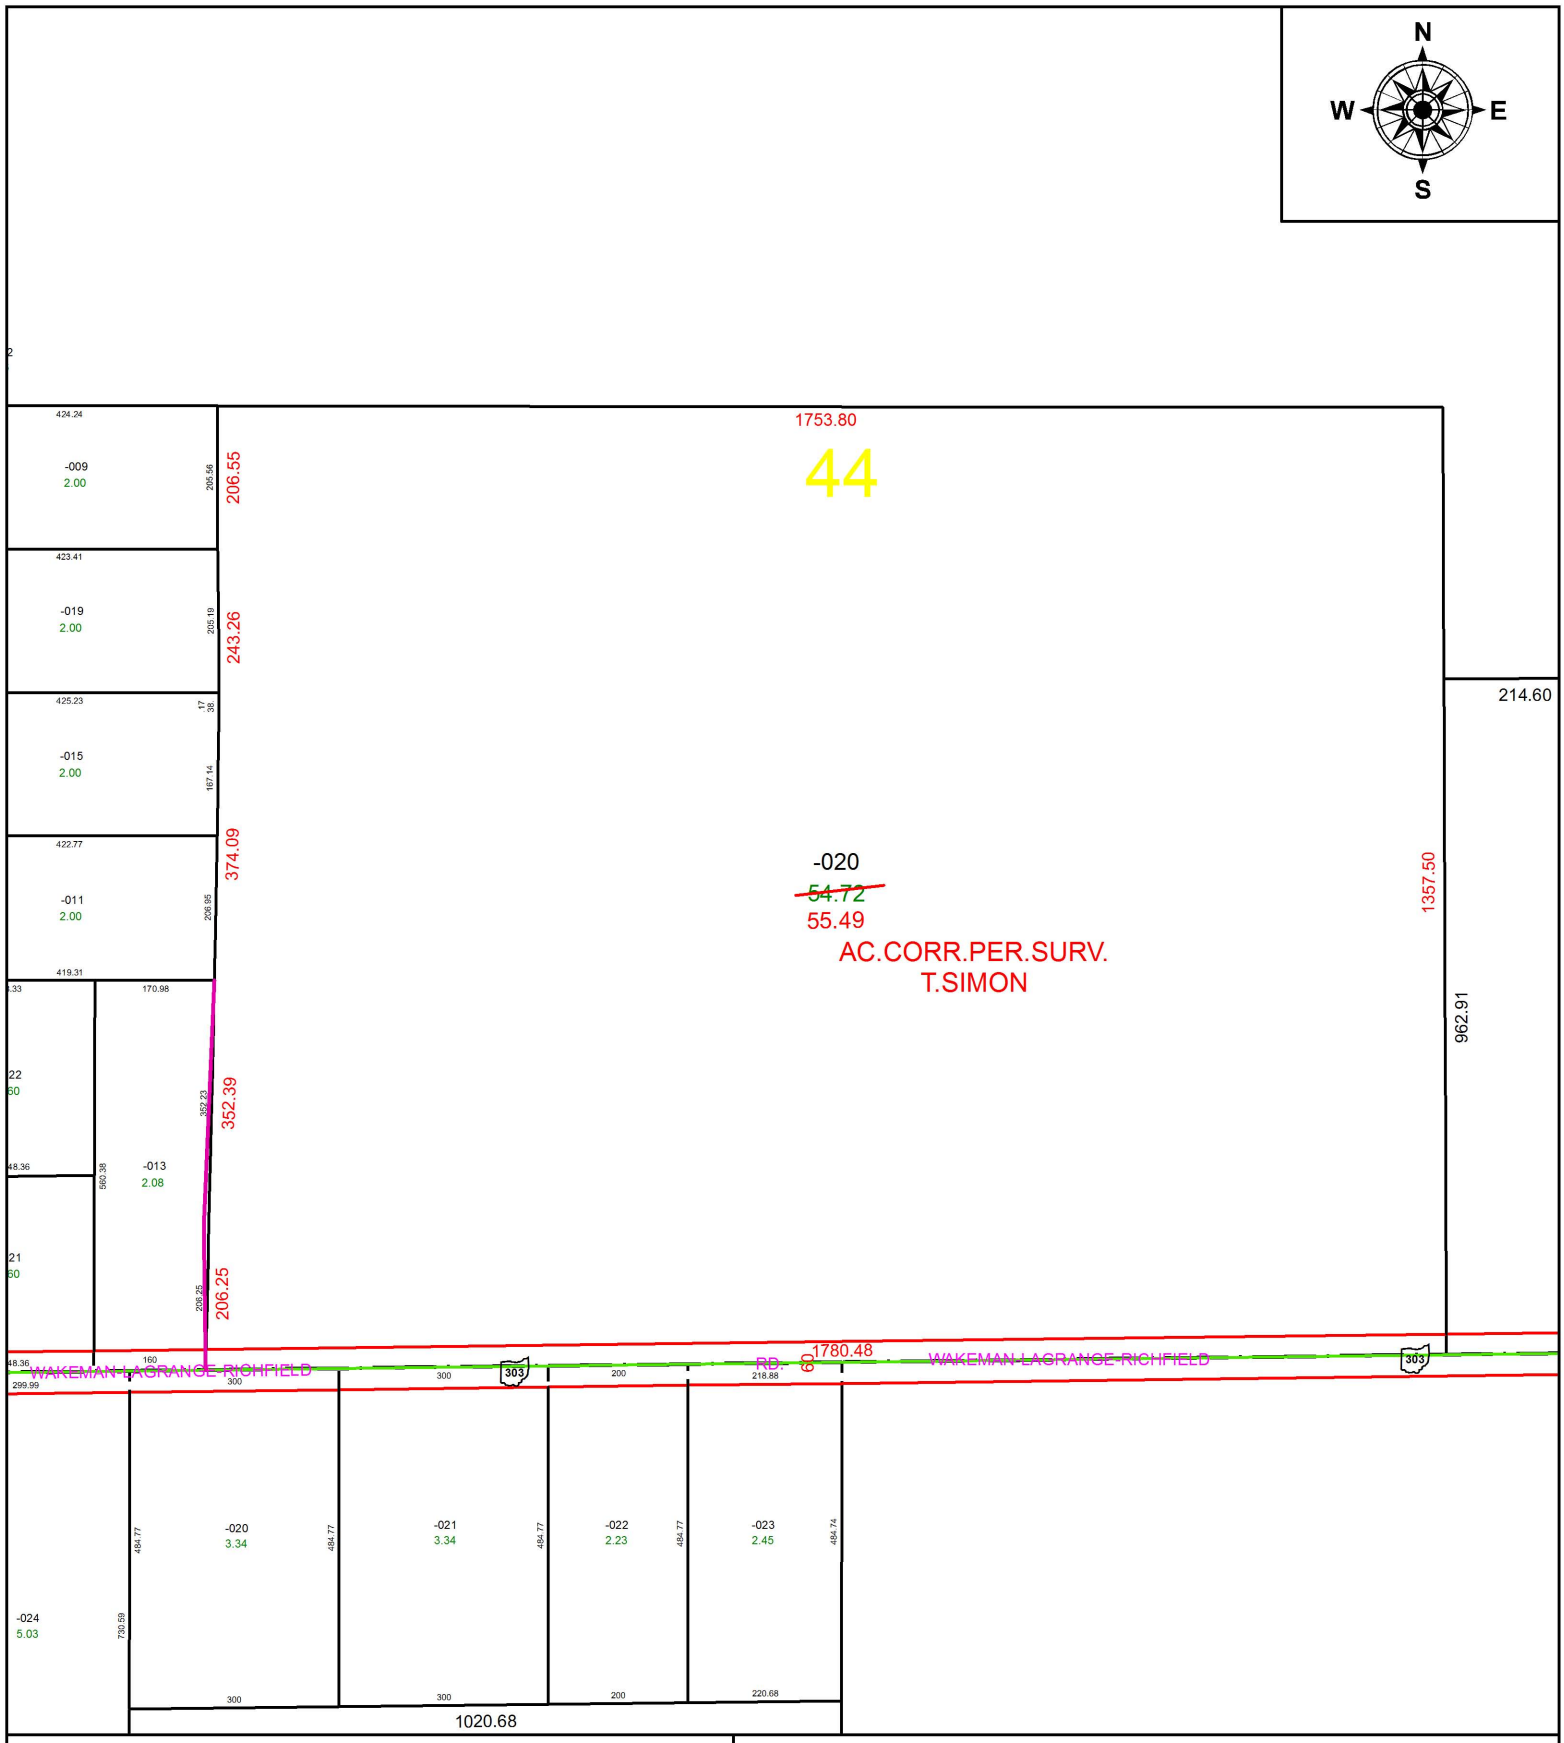

SPLITS/DEEDS PROCESSED

LORAIN COUNTY TAX MAP DEPARTMENT
226 MIDDLE AVE. ELYRIA, OH

SURVEYED BY: THOMAS A. SIMON
CLOSURE: 1: 996,250
MAP PAGE(S): 15-00-044
APPOVED BY: RRM **DATE:** 1-29-18
SCALE: 1" = 275 **PRIOR INSTRUMENT:** 20150566580