PARENT PARCEL: 14-00-124-000-006

CHILD PARCEL: XX-XX-XXX-XXX-XXX

STARTING POINT: NORTHEAST CORNER OF O.L.124

18-03831-A

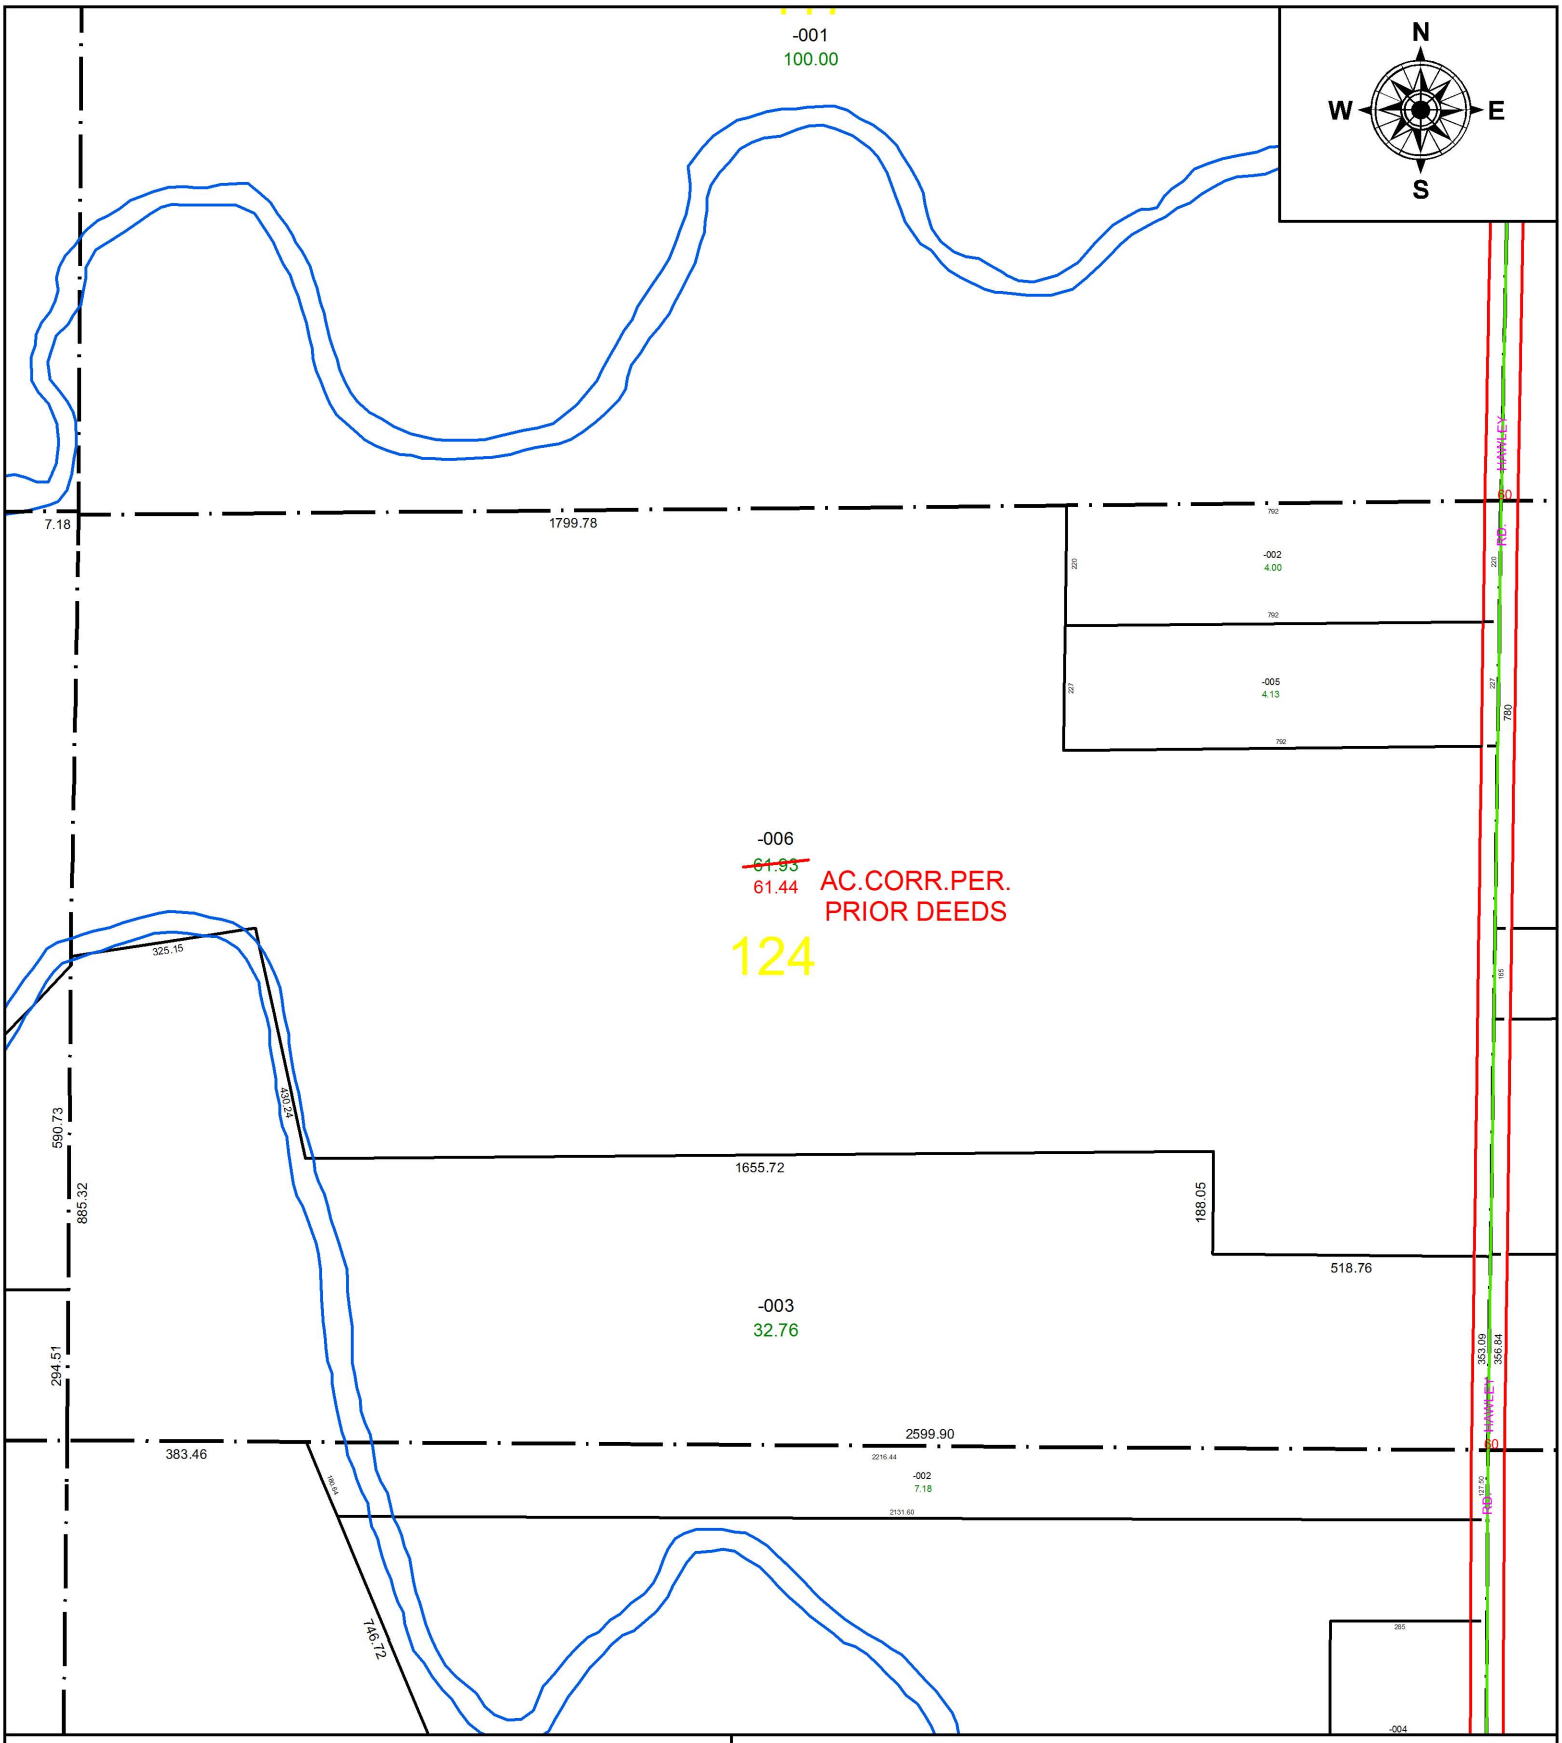

SPLITS/DEEDS PROCESSED

LORAIN COUNTY TAX MAP DEPARTMENT
226 MIDDLE AVE. ELYRIA, OH

SURVEYED BY: N/A

CLOSURE: N/A

MAP PAGE(S): 14-G

APPOVED BY: RRM **DATE:** 2-7-18

SCALE: 1" = 350 **PRIOR INSTRUMENT:** 20000694132