PARENT PARCEL: 09-00-065-000-019
CHILD PARCEL: 09-00-065-000-055, -056
STARTING POINT: INTERSECTION OF C/L OF N.PROFESSOR ST. AND C/L OF BUTTERNUT RIDGE RD.

18-03833

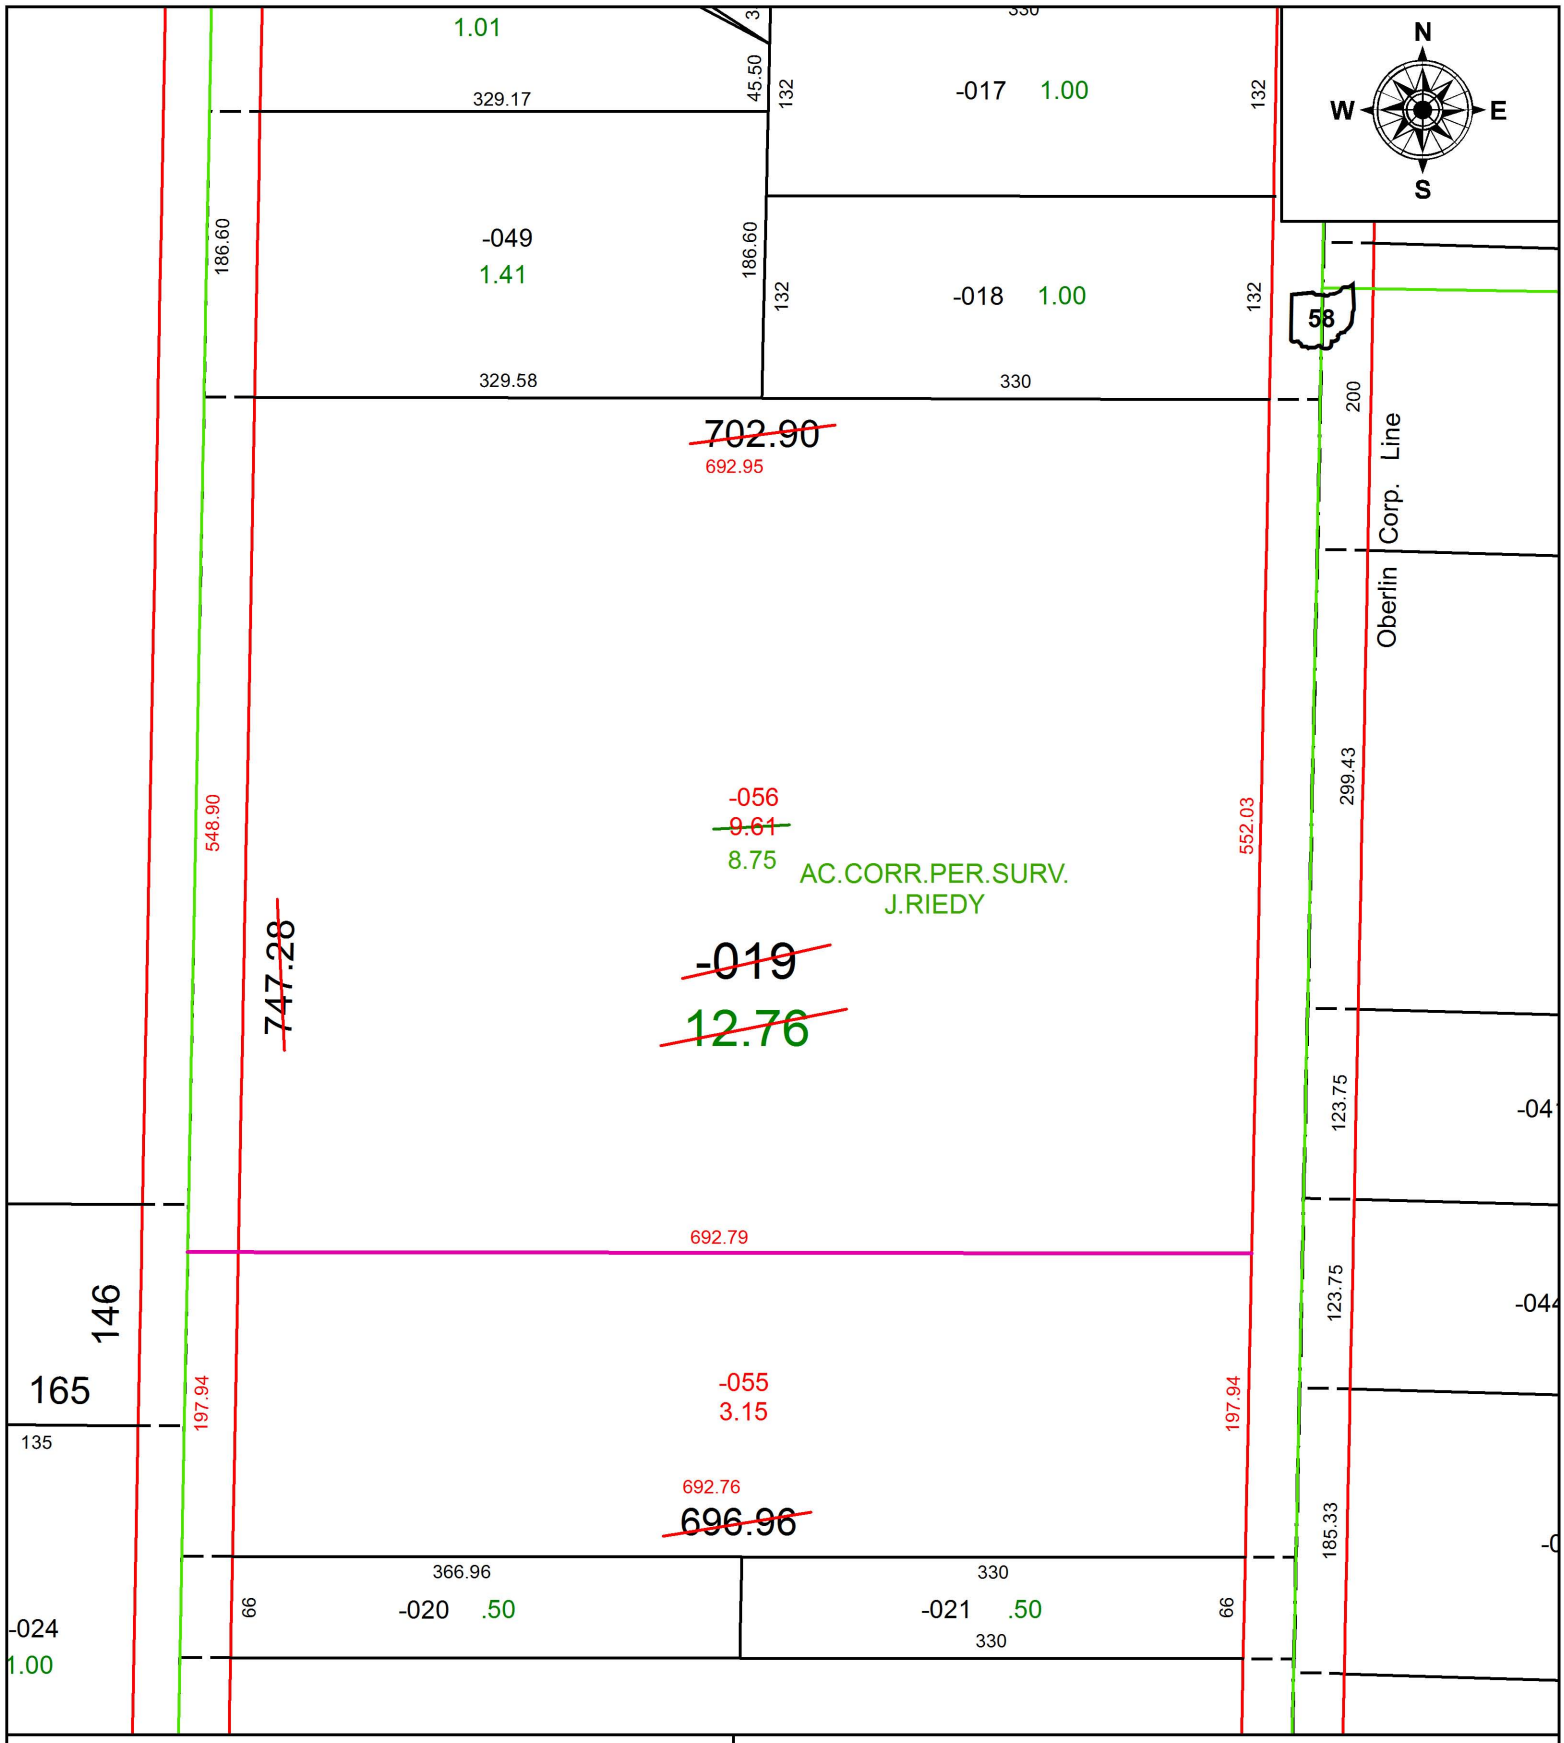

SPLITS/DEEDS PROCESSED

LORAIN COUNTY TAX MAP DEPARTMENT
226 MIDDLE AVE. ELYRIA, OH

SURVEYED BY: JOSHUA S. RIEDY
CLOSURE: 1: 658,245
MAP PAGE(S): 9-00-065
APPOVED BY: RRM **DATE:** 7-11-18
SCALE: 1" = 125 **PRIOR INSTRUMENT:** 20170651926