PARENT PARCEL: 12-00-044-000-021
CHILD PARCEL: XX-XX-XXX-XXX-XXX
STARTING POINT: INTERSECTION OF C/L OF WEST RIVER RD. AND C/L OF CASTLEBAR CT.

18-03834-C

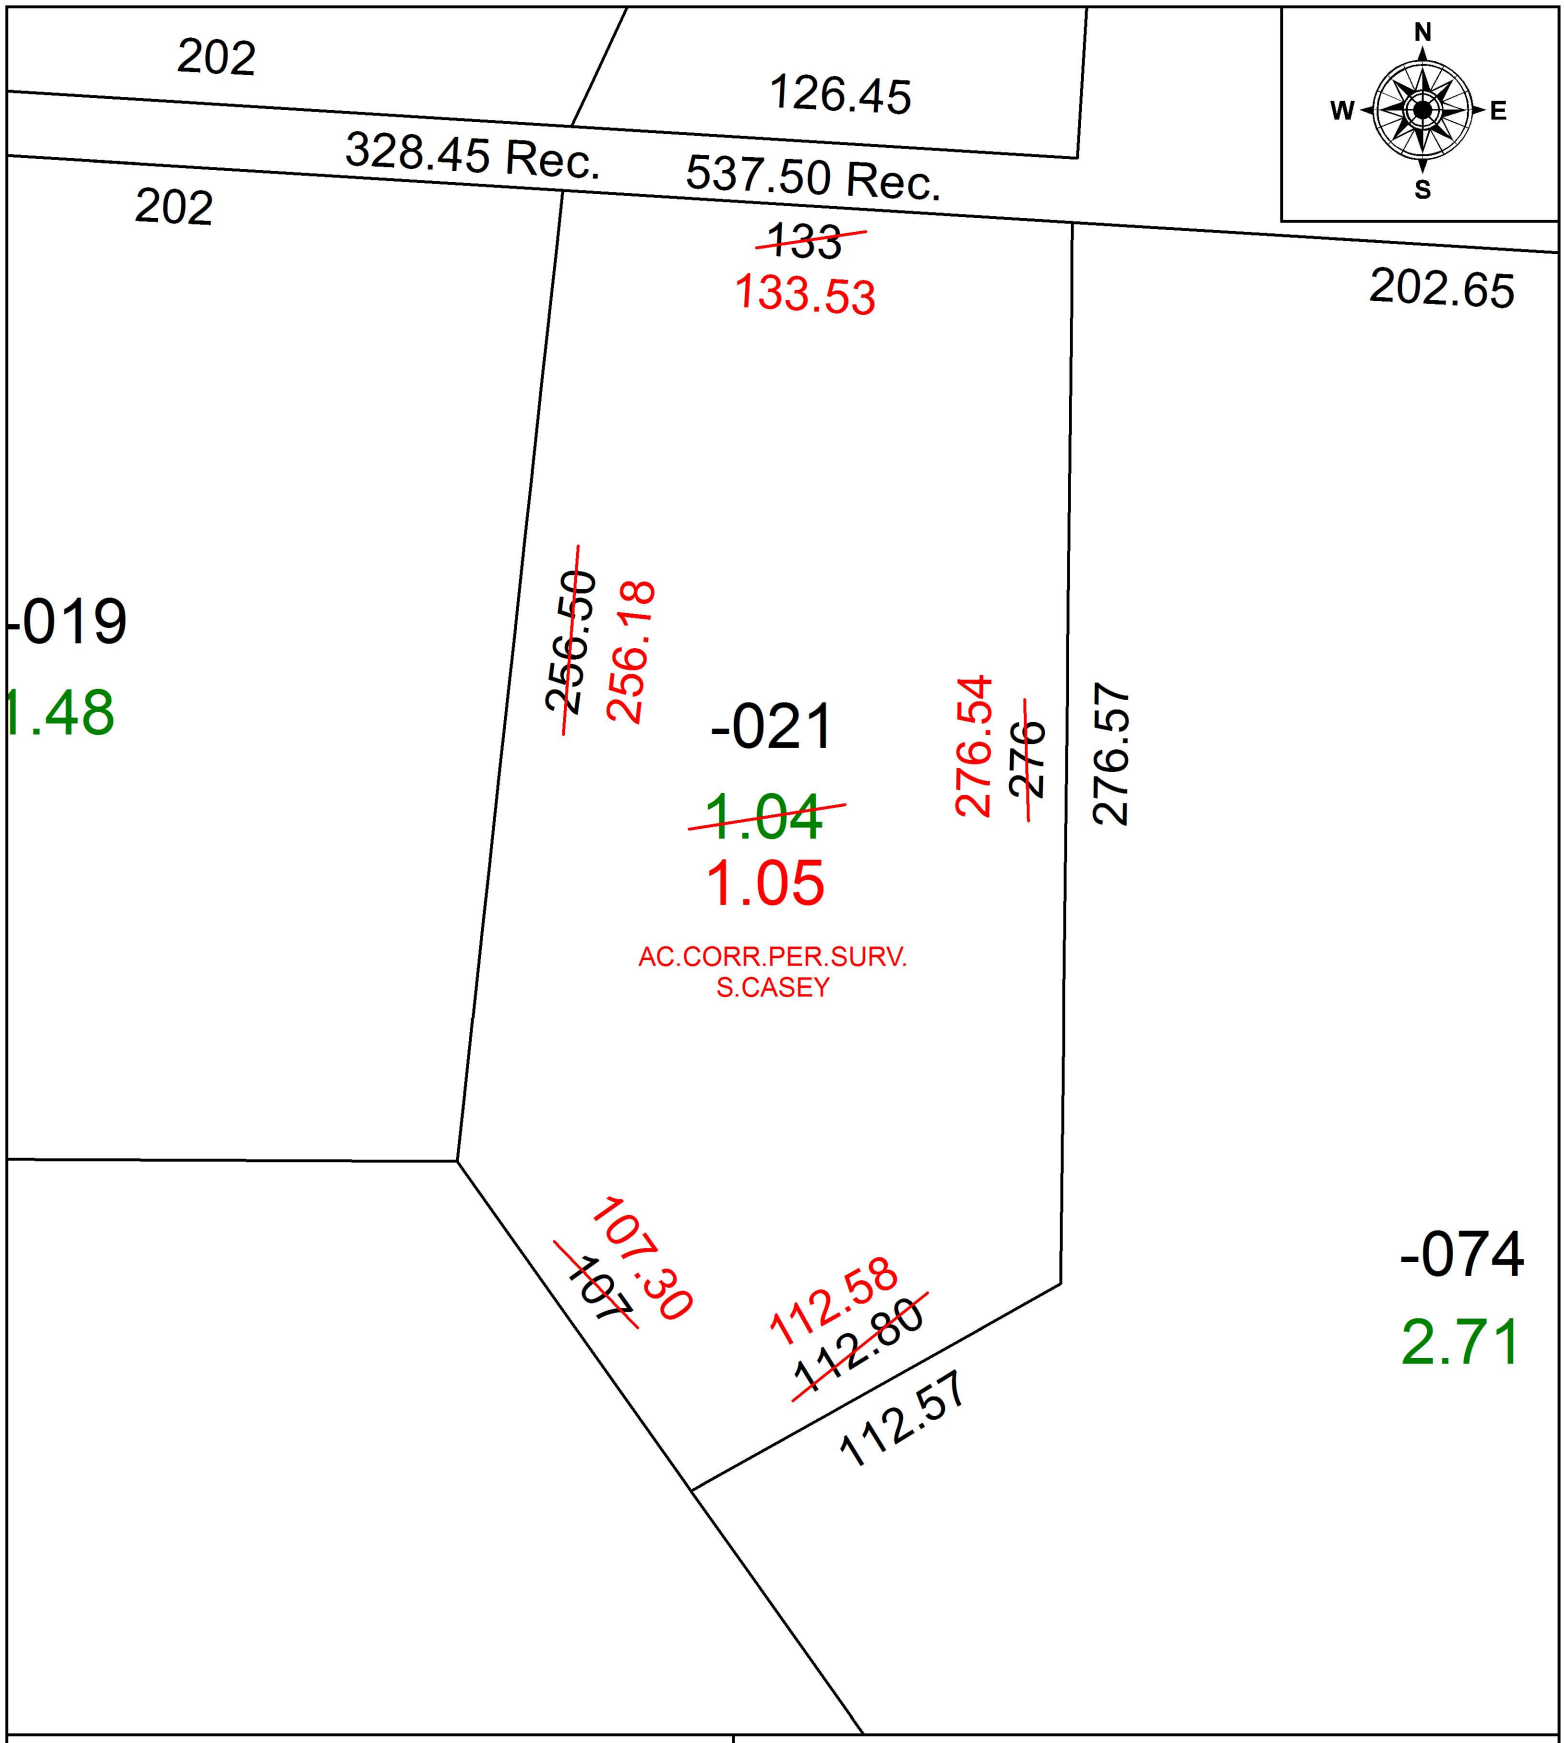

SPLITS/DEEDS PROCESSED
LORAIN COUNTY TAX MAP DEPARTMENT
226 MIDDLE AVE. ELYRIA, OH

SURVEYED BY: SCOTT J. CASEY
CLOSURE: 1: 145,864
MAP PAGE(S): 12-00-044
APPOVED BY: RRM **DATE:** 2-13-18
SCALE: 1" = 50 **PRIOR INSTRUMENT:** 20160605778