**PARENT PARCEL:** SPLIT 04-00-005-000-081 & STRAIGHT TRANSFER 04-00-005-701-008

**CHILD PARCEL:** 04-00-005-000-124 & -125

**STARTING POINT:** CL OF WALKER RD. & CL OF MILLER RD.

# 18-03834

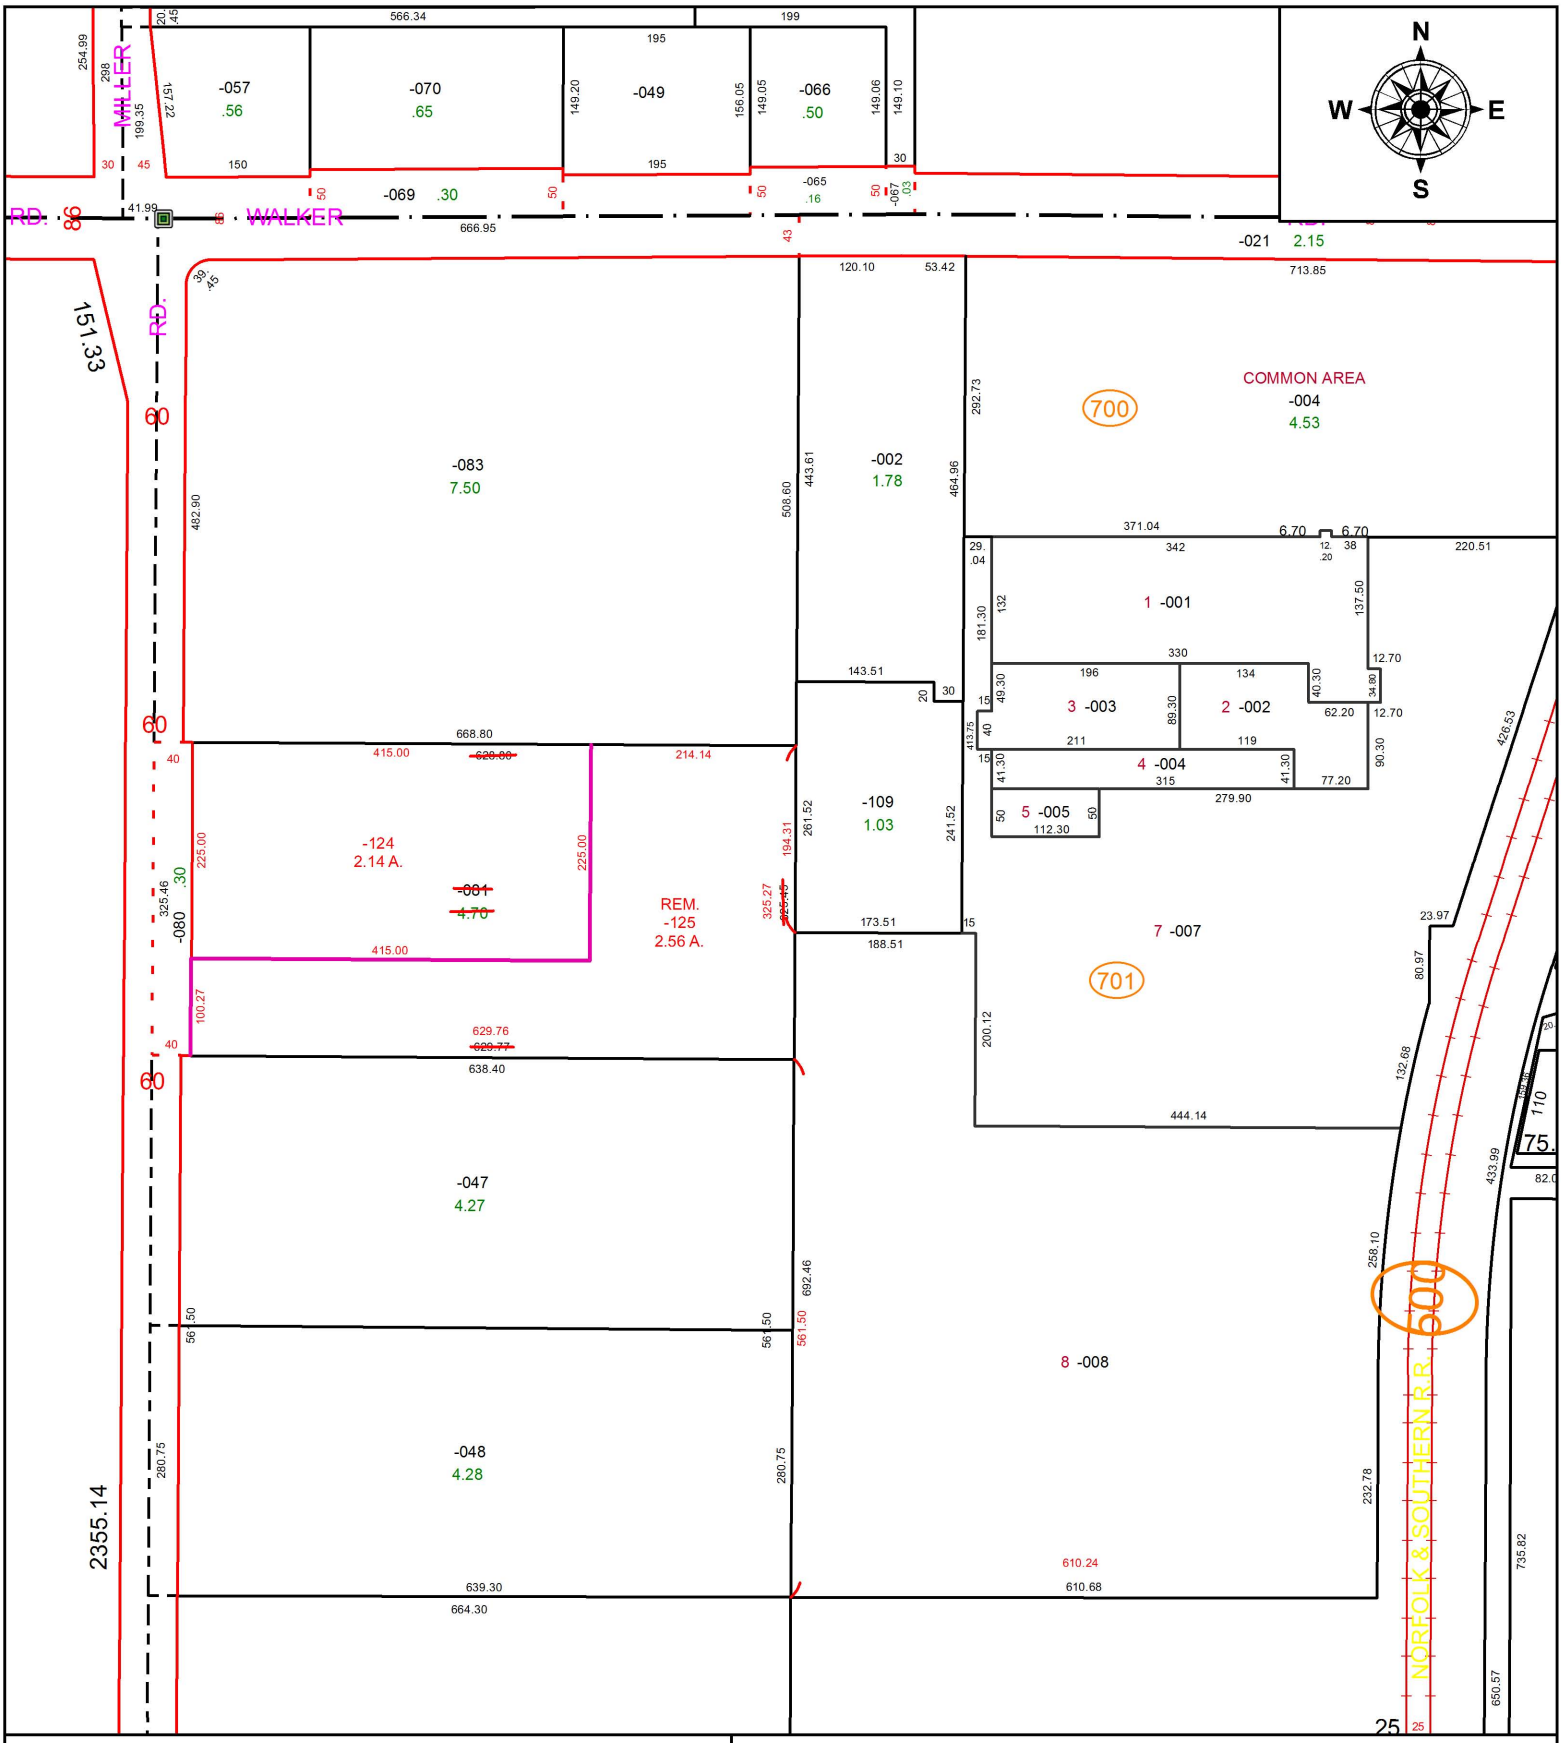


**SPLITS/DEEDS PROCESSED**

LORAIN COUNTY TAX MAP DEPARTMENT
226 MIDDLE AVE. ELYRIA, OH

**SURVEYED BY:** THOMAS SIMON
**CLOSURE:** 1: 33,000
**MAP PAGE(S):** 04-00-005
**APPOVED BY:** TJS **DATE:** 7/9/18
**SCALE:** 1" = 200 **PRIOR INSTRUMENT:** 2017-0647663