PARENT PARCEL: 06-21-003-101-032, -038

CHILD PARCEL: 06-21-003-101-040 THRU -042

STARTING POINT: INTERSECTION OF C/L OF NORTH RIDGE RD, AND C/L OF LAKE AVE.

18-03845

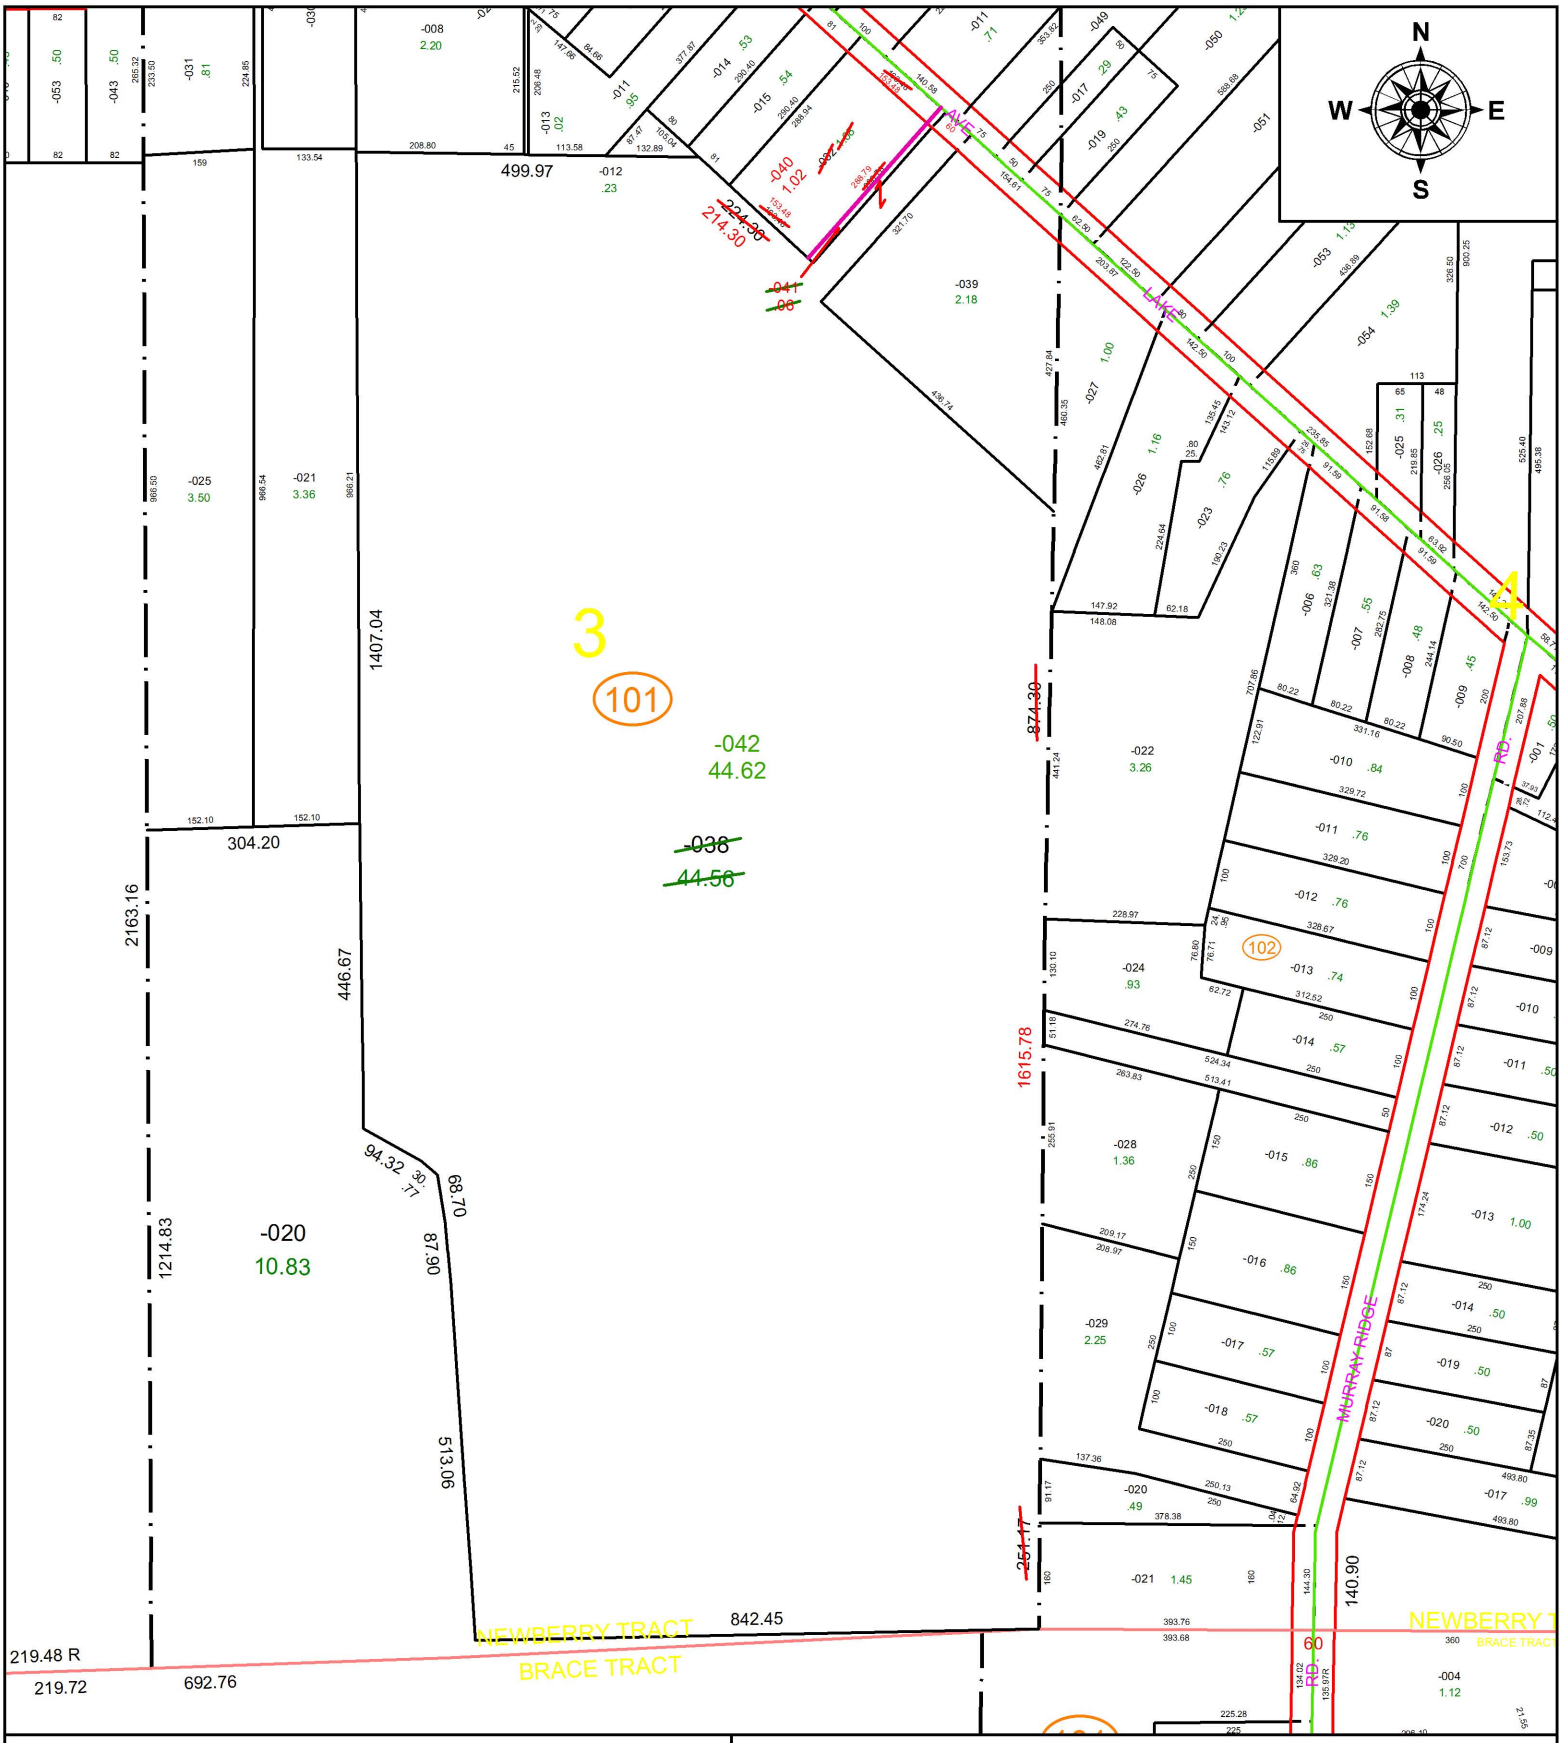

SPLITS/DEEDS PROCESSED

LORAIN COUNTY TAX MAP DEPARTMENT
226 MIDDLE AVE. ELYRIA, OH

SURVEYED BY: THOMAS A. SIMON
CLOSURE: 1: 2,806,060
MAP PAGE(S): 6-3
APPOVED BY: RRM **DATE:** 7-30-18
SCALE: 1" = 275 **PRIOR INSTRUMENT:** 20170629851