PARENT PARCEL: 05-00-044-000-082, -100
CHILD PARCEL: 05-00-044-000-082, -104, -105
STARTING POINT: INTERSECTION OF C/L OF LEAVITT RD. AND C/L OF PARK AVE.

18-03846

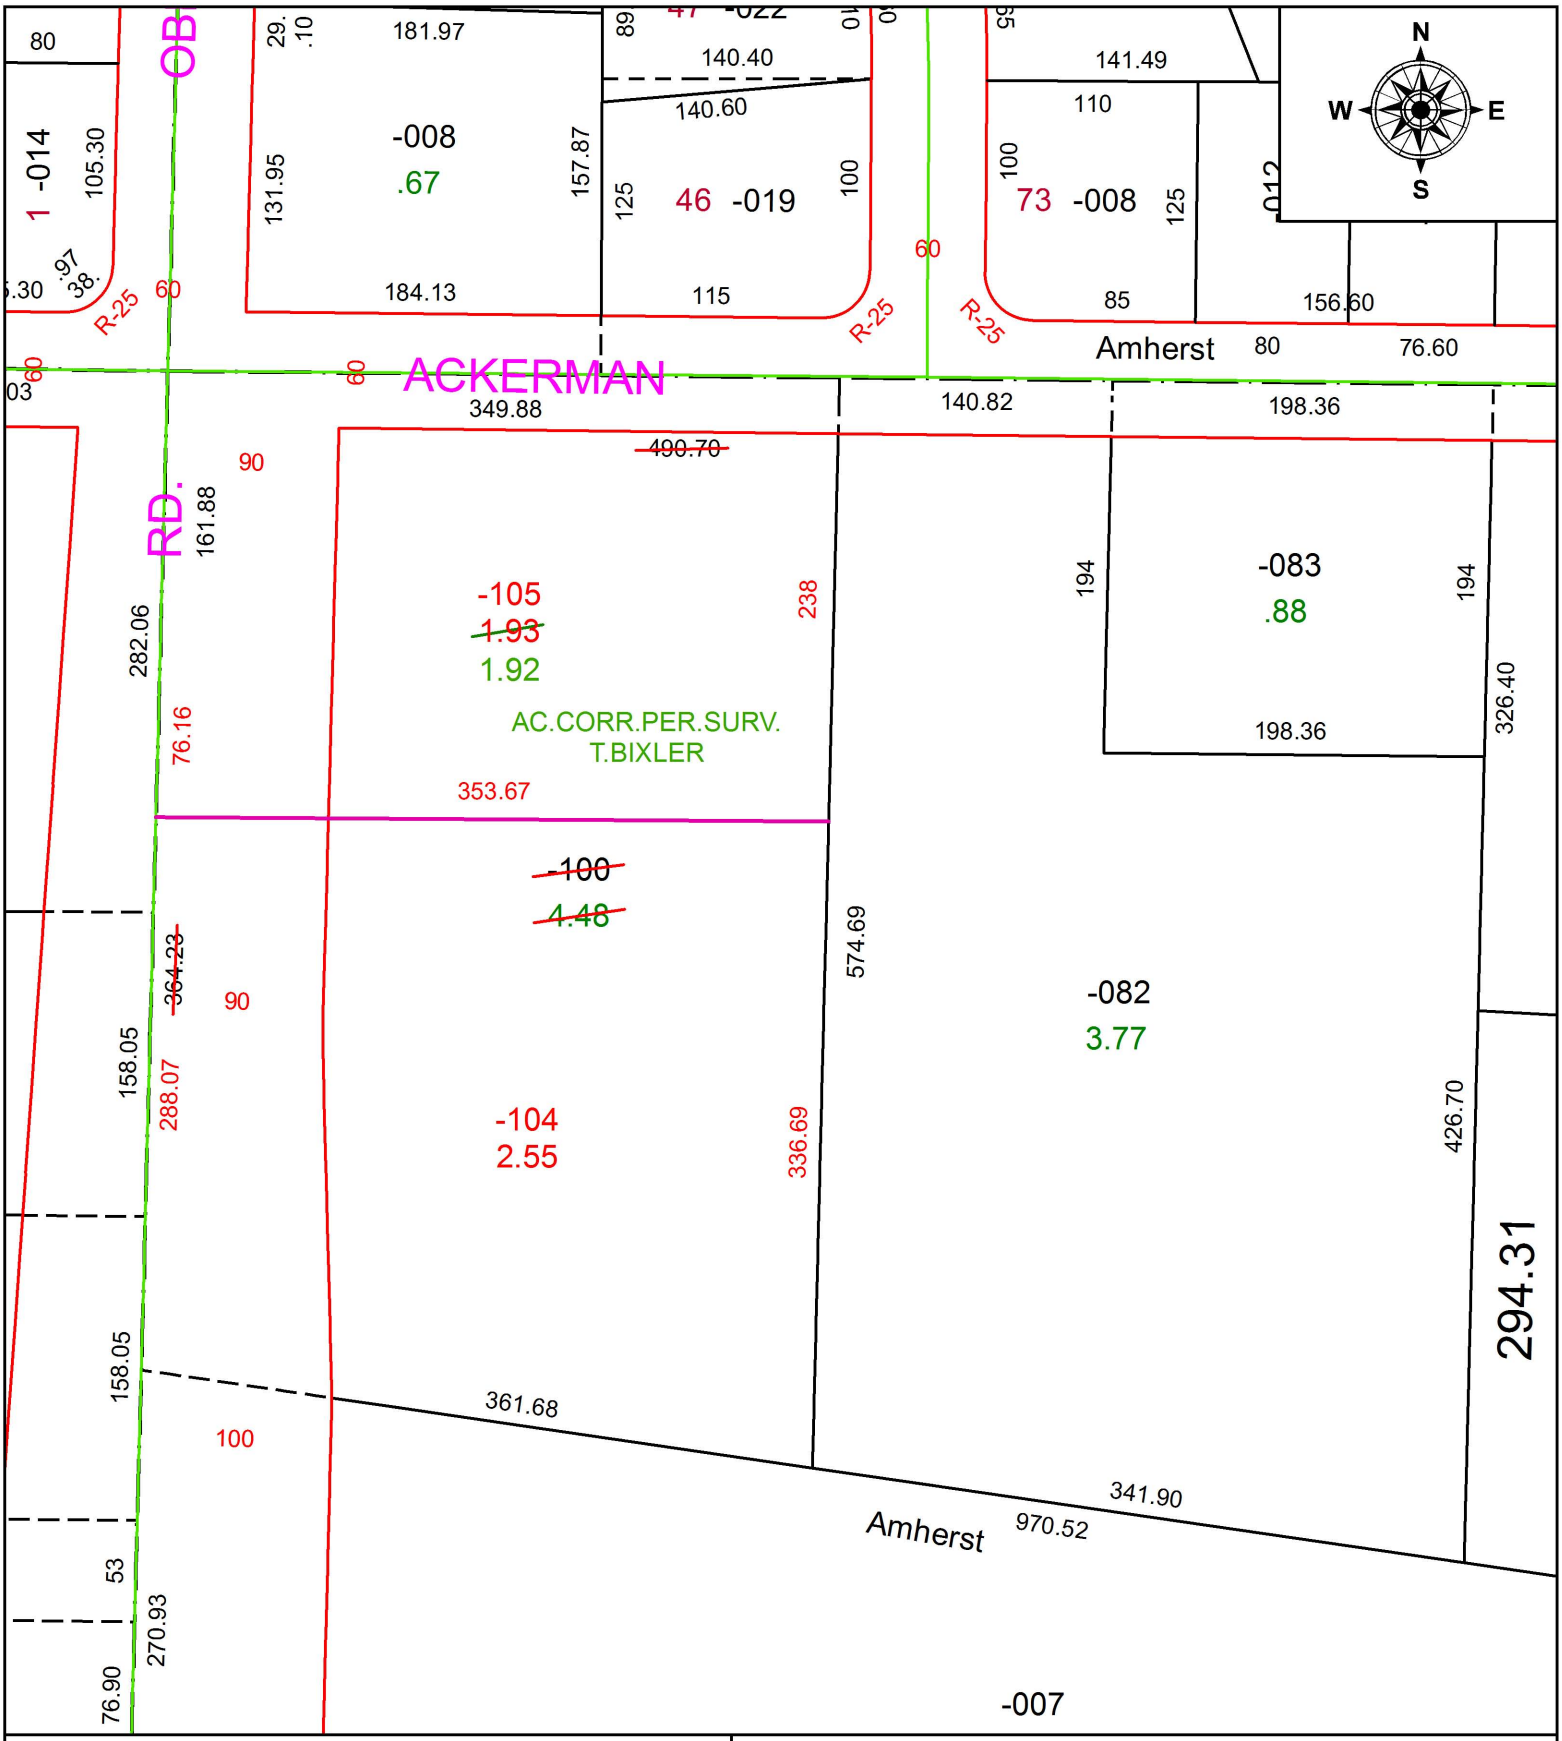

SPLITS/DEEDS PROCESSED
LORAIN COUNTY TAX MAP DEPARTMENT
226 MIDDLE AVE. ELYRIA, OH

SURVEYED BY: TREVOR A. BIXLER
CLOSURE: 1: 157,965
MAP PAGE(S): 5-00-044
APPOVED BY: RRM **DATE:** 7-31-18
SCALE: 1" = 100 **PRIOR INSTRUMENT:** 20110392471