PARENT PARCEL: 15-00-051-000-004, -007

CHILD PARCEL: 15-00-050-000-013, 15-00-051-000-023 THRU -028, 15-00-070-000-051

STARTING POINT: INTERSECTION OF C/L OF VERMONT ST. AND C/L OF S.R.303

18-03847

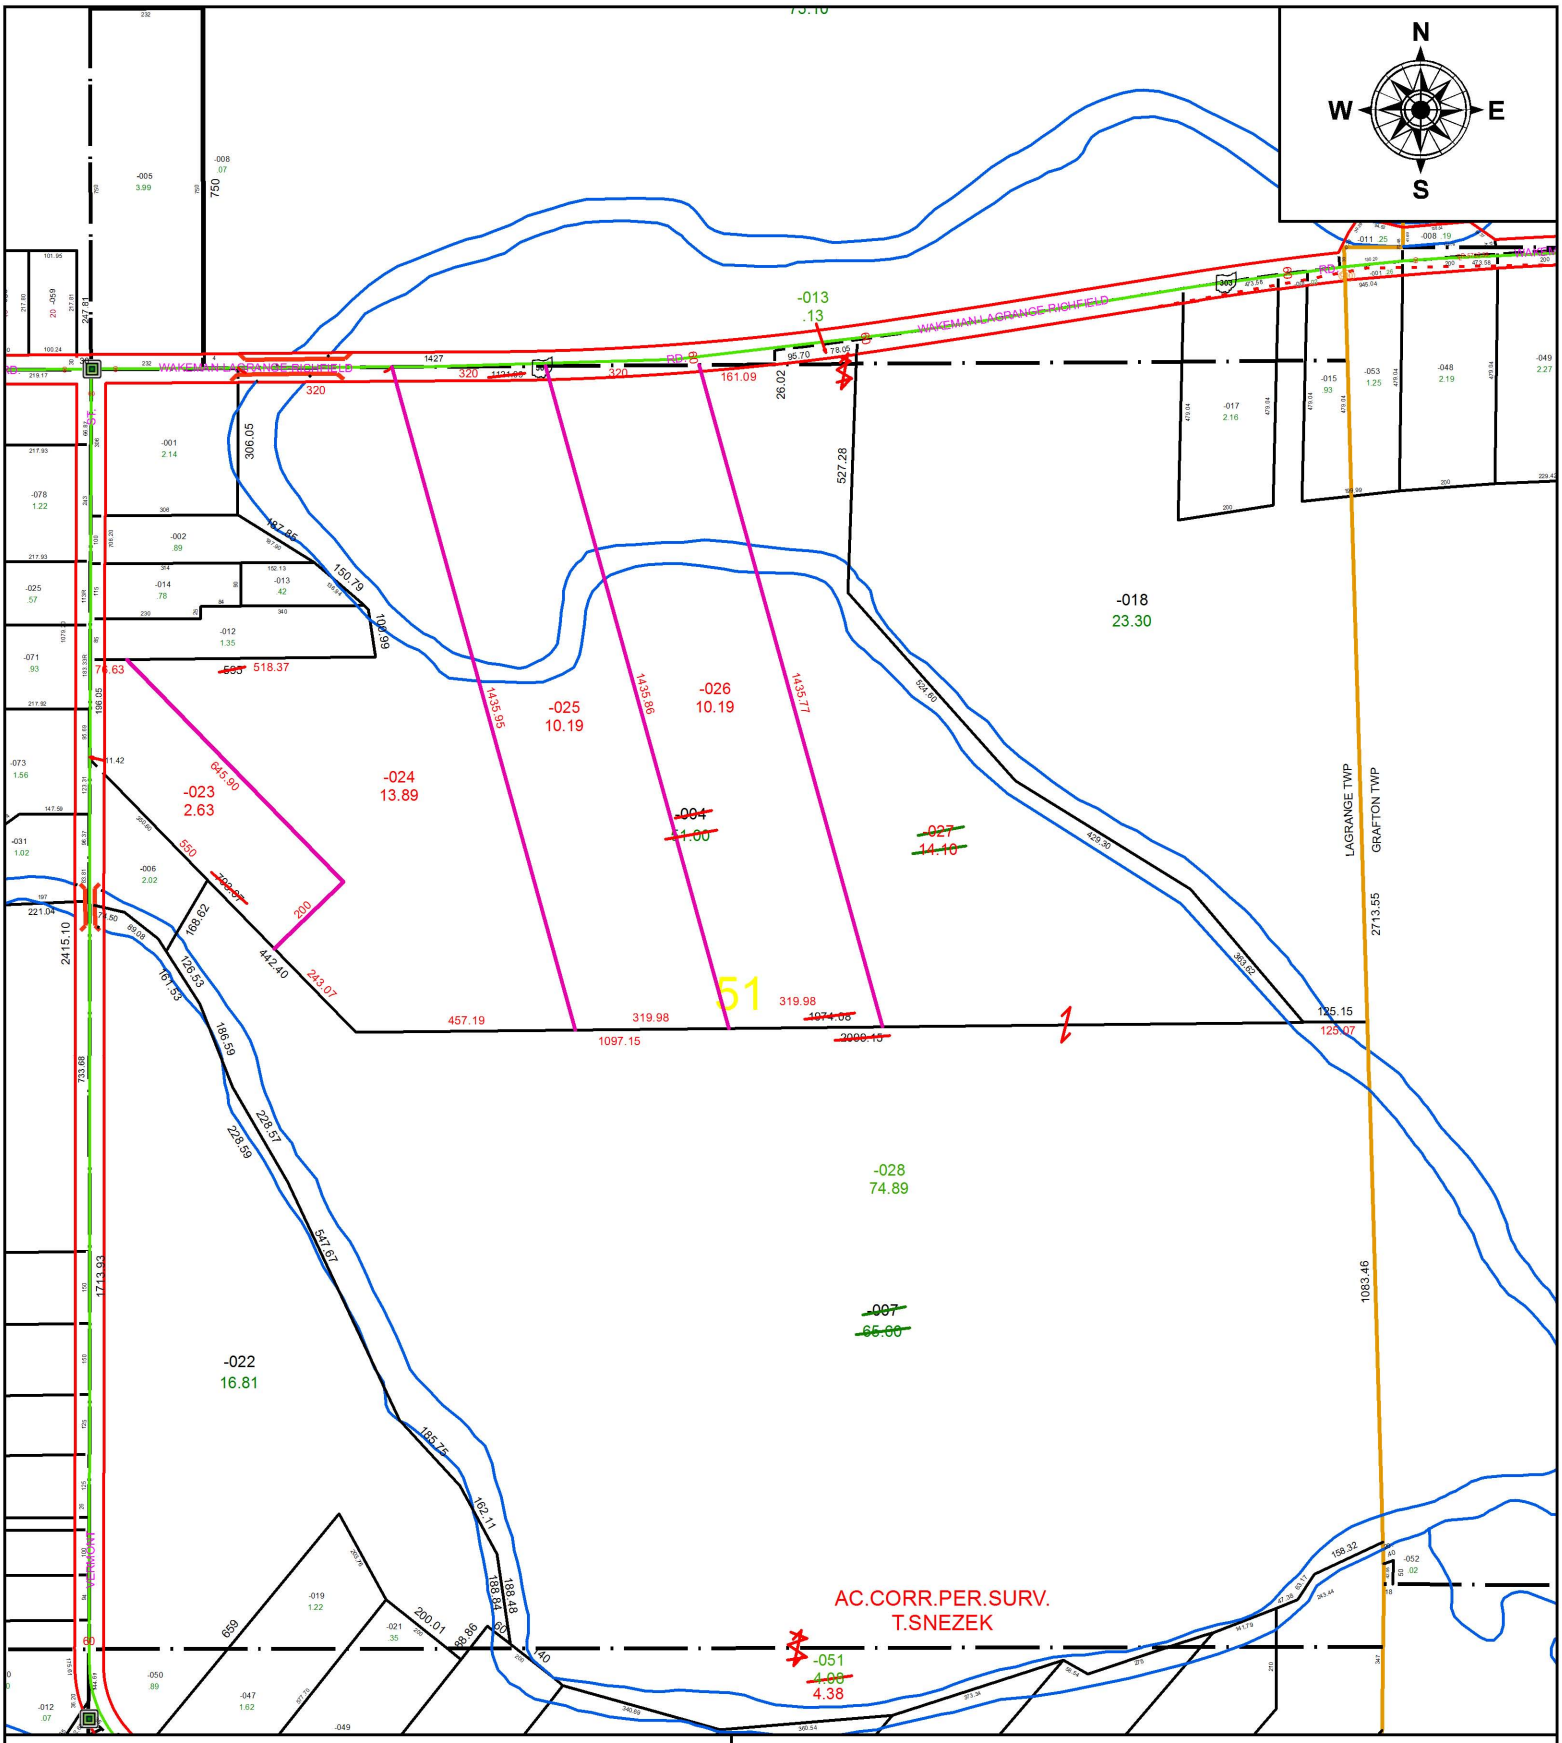

SPLITS/DEEDS PROCESSED

LORAIN COUNTY TAX MAP DEPARTMENT
226 MIDDLE AVE. ELYRIA, OH

SURVEYED BY: THOMAS M. SNEZEK
CLOSURE: 1: 336,222
MAP PAGE(S): 15-H
APPOVED BY: RRM **DATE:** 7-31-18
SCALE: 1" = 400 **PRIOR INSTRUMENT:** 20160572820