PARENT PARCEL: 02-02-016-116-038
CHILD PARCEL: XX-XX-XXX-XXX-XXX
STARTING POINT: INTERSECTION OF NORTH LINE OF MEISTER RD. AND WEST LINE OF ASHLAND AVE.

18-03849-D

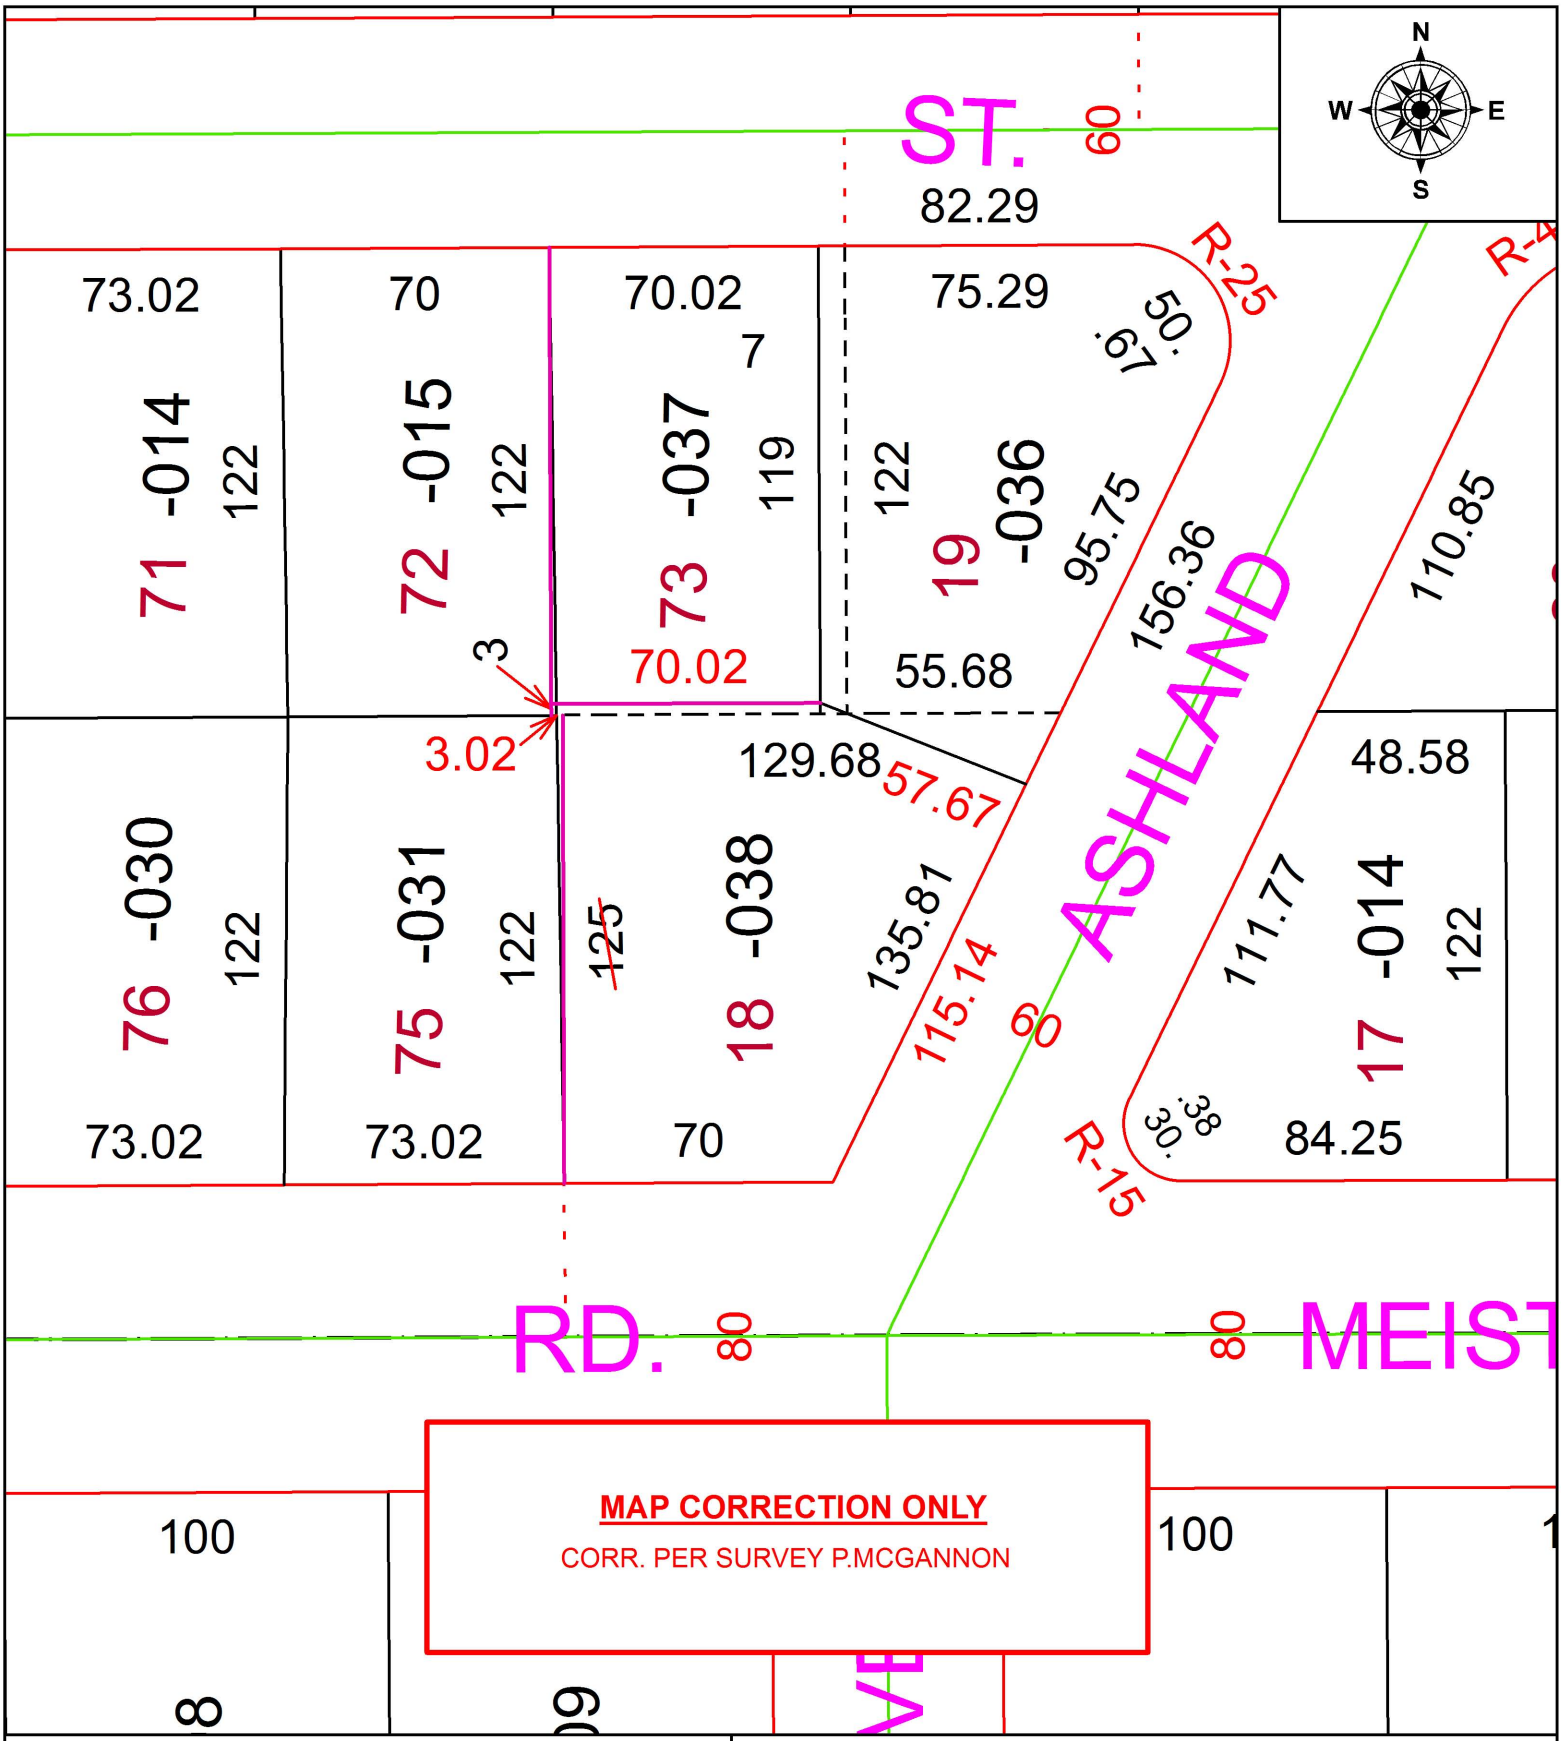

MAP CORRECTION ONLY
CORR. PER SURVEY P.MCGANNON

SPLITS/DEEDS PROCESSED
LORAIN COUNTY TAX MAP DEPARTMENT
226 MIDDLE AVE. ELYRIA, OH

SURVEYED BY: PATRICK A. MCGANNON
CLOSURE: 1: 20,245
MAP PAGE(S): 2-02-016
APPOVED BY: RRM **DATE:** 3-1-18
SCALE: 1" = 50 **PRIOR INSTRUMENT:** 20090285101