PARENT PARCEL: 06-24-174-000-008, -012, -014, -020

CHILD PARCEL: 06-24-173-000-026, 06-24-174-000-032

STARTING POINT: ANGLE POINT IN C/L OF FORD RD.

18-03849

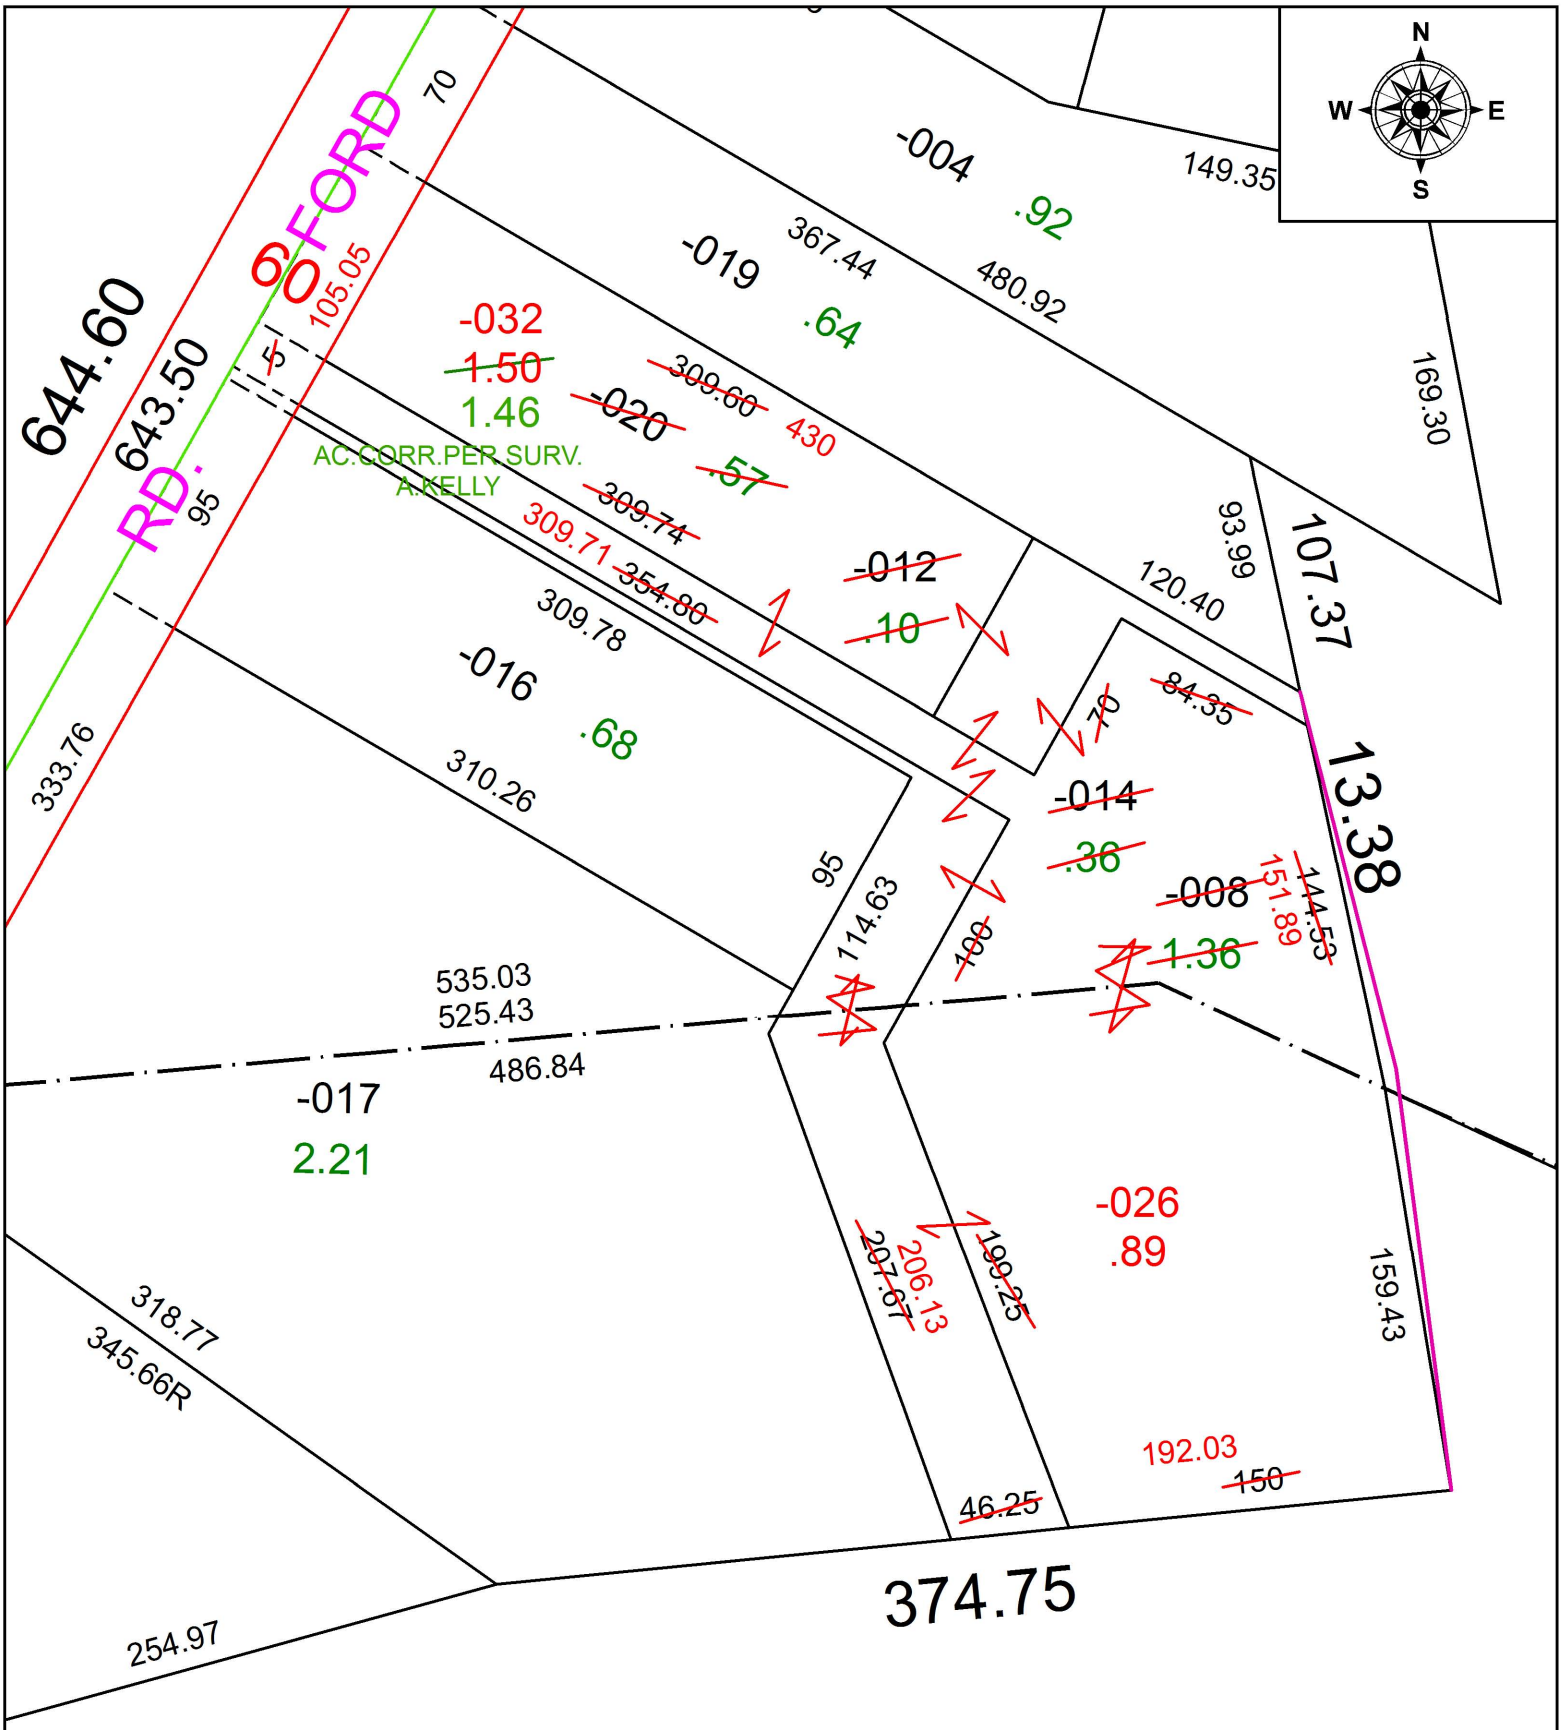

SPLITS/DEEDS PROCESSED

LORAIN COUNTY TAX MAP DEPARTMENT
226 MIDDLE AVE. ELYRIA, OH

SURVEYED BY: AMY M. KELLY
CLOSURE: 1: 191,499
MAP PAGE(S): 6-49
APPOVED BY: RRM **DATE:** 8-6-18
SCALE: 1" = 75 **PRIOR INSTRUMENT:** 20170650294