PARENT PARCEL: 13-08-007-000-001

CHILD PARCEL: XX-XX-XXX-XXX-XXX

STARTING POINT: SOUTHWEST CORNER OF O.L.7 TR.8

18-03851-A

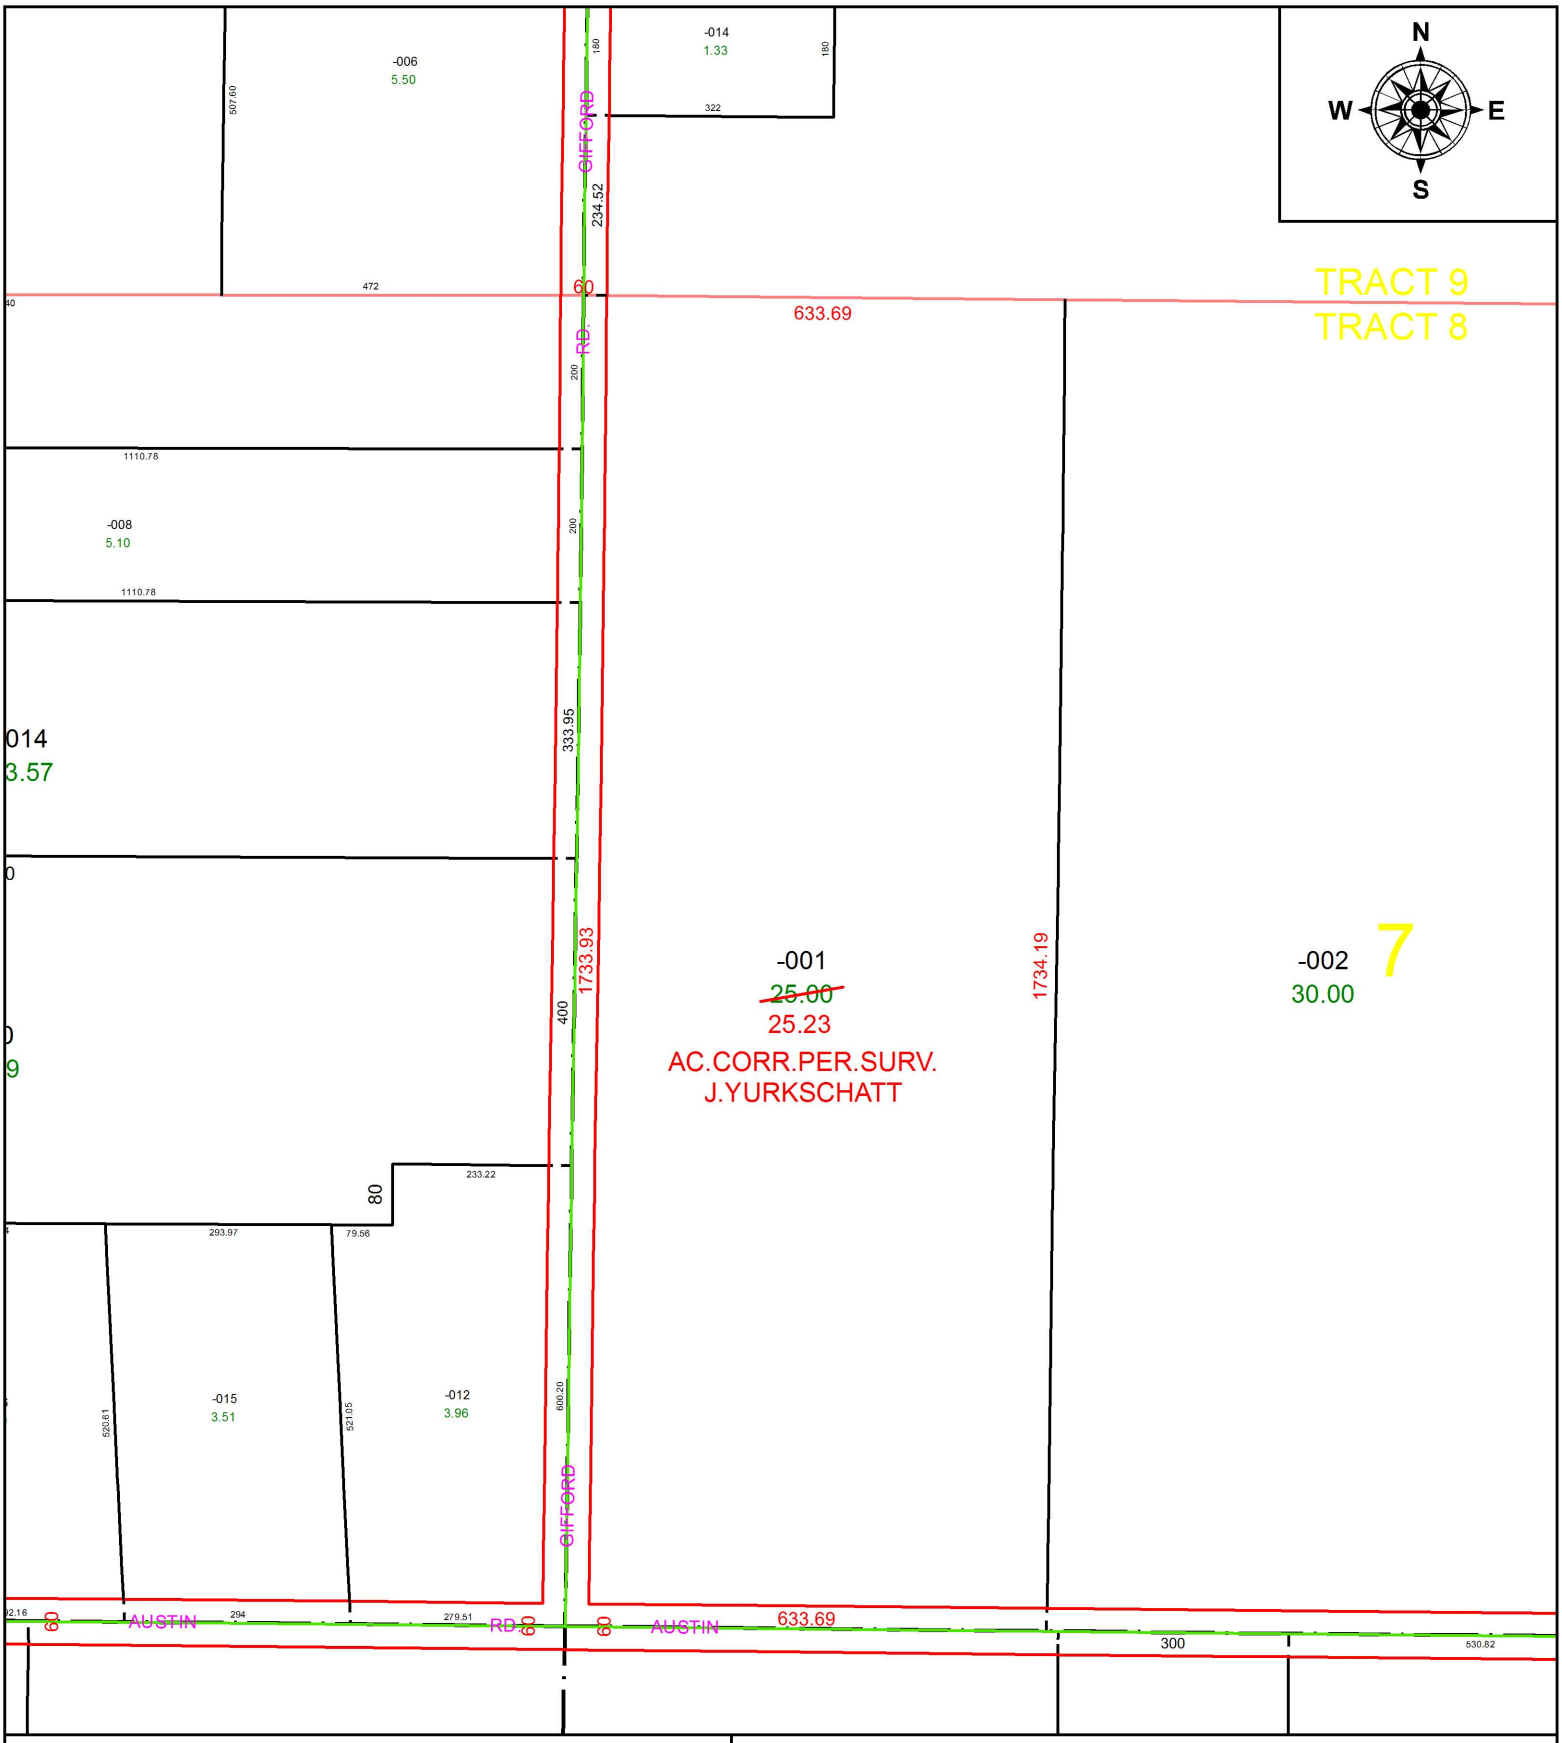

SPLITS/DEEDS PROCESSED

LORAIN COUNTY TAX MAP DEPARTMENT
226 MIDDLE AVE. ELYRIA, OH

SURVEYED BY: JAMES P. YURKSCHATT
CLOSURE: 1: 2,213,239
MAP PAGE(S): 13-H
APPOVED BY: RRM **DATE:** 3-6-18
SCALE: 1" = 250 **PRIOR INSTRUMENT:** 19990603288