PARENT PARCEL: 05-00-023-107-023, -029

CHILD PARCEL: 05-00-023-107-030, -031

STARTING POINT: SOUTHEAST CORNER OF S/L 2 IN KOLBE'S 1ST ADD.

18-03852

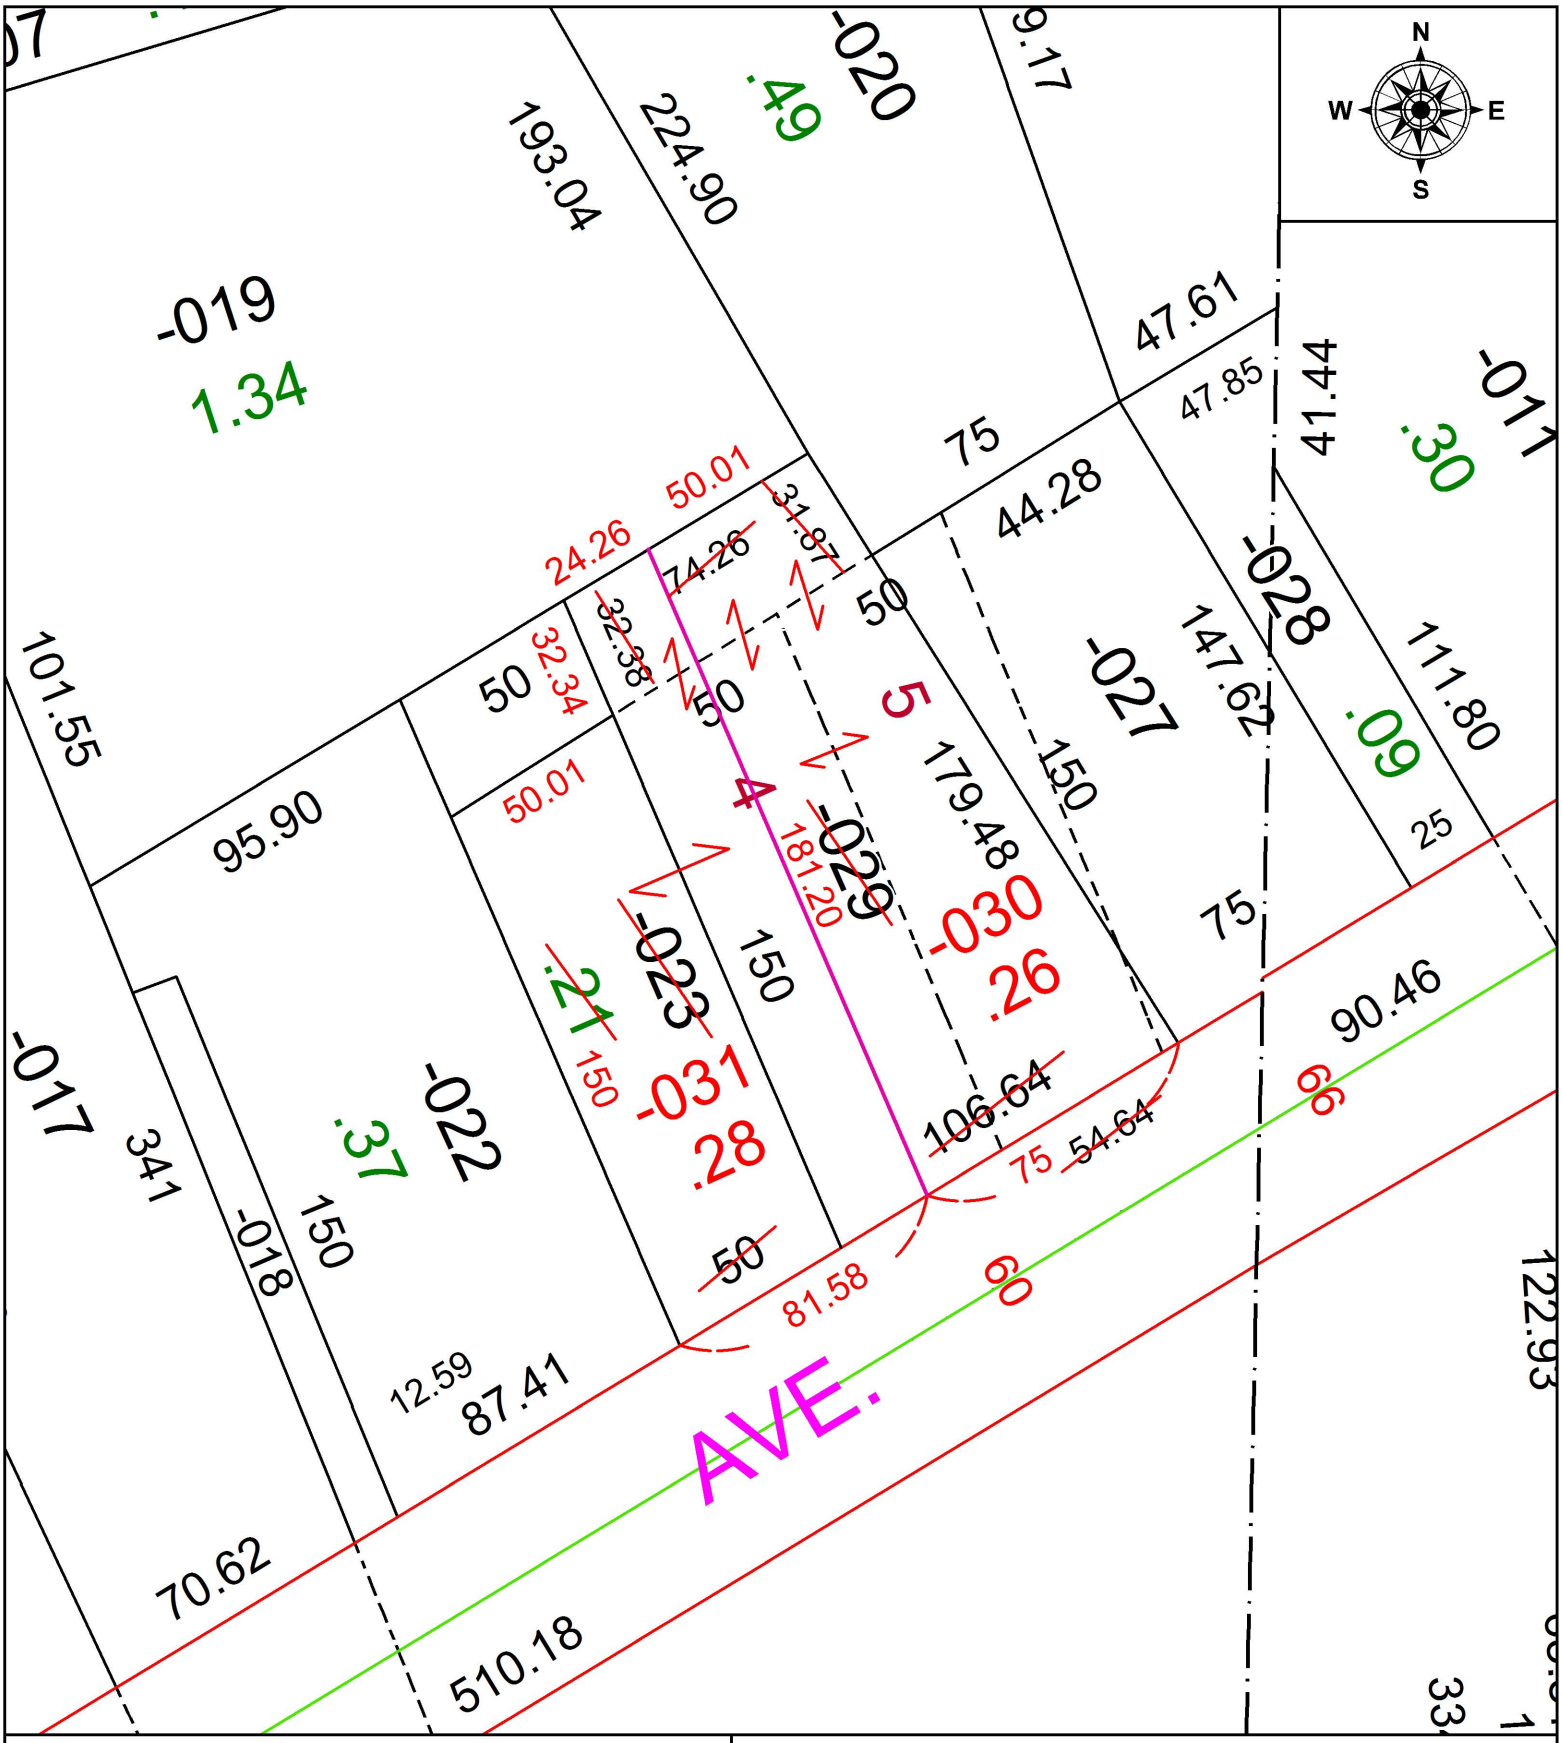

SPLITS/DEEDS PROCESSED

LORAIN COUNTY TAX MAP DEPARTMENT
226 MIDDLE AVE. ELYRIA, OH

SURVEYED BY: PATRICK A. MCGANNON
CLOSURE: 1: 257,017
MAP PAGE(S): 5-00-023
APPOVED BY: RRM **DATE:** 9-7-18
SCALE: 1" = 50 **PRIOR INSTRUMENT:** 20140509834