PARENT PARCEL: 02-02-007-101-054

CHILD PARCEL: 02-02-007-101-062, -063

STARTING POINT: INTERSECTION OF C/L OF LEAVITT RD. AND SOUTH LINE OF O.L.8

18-03854

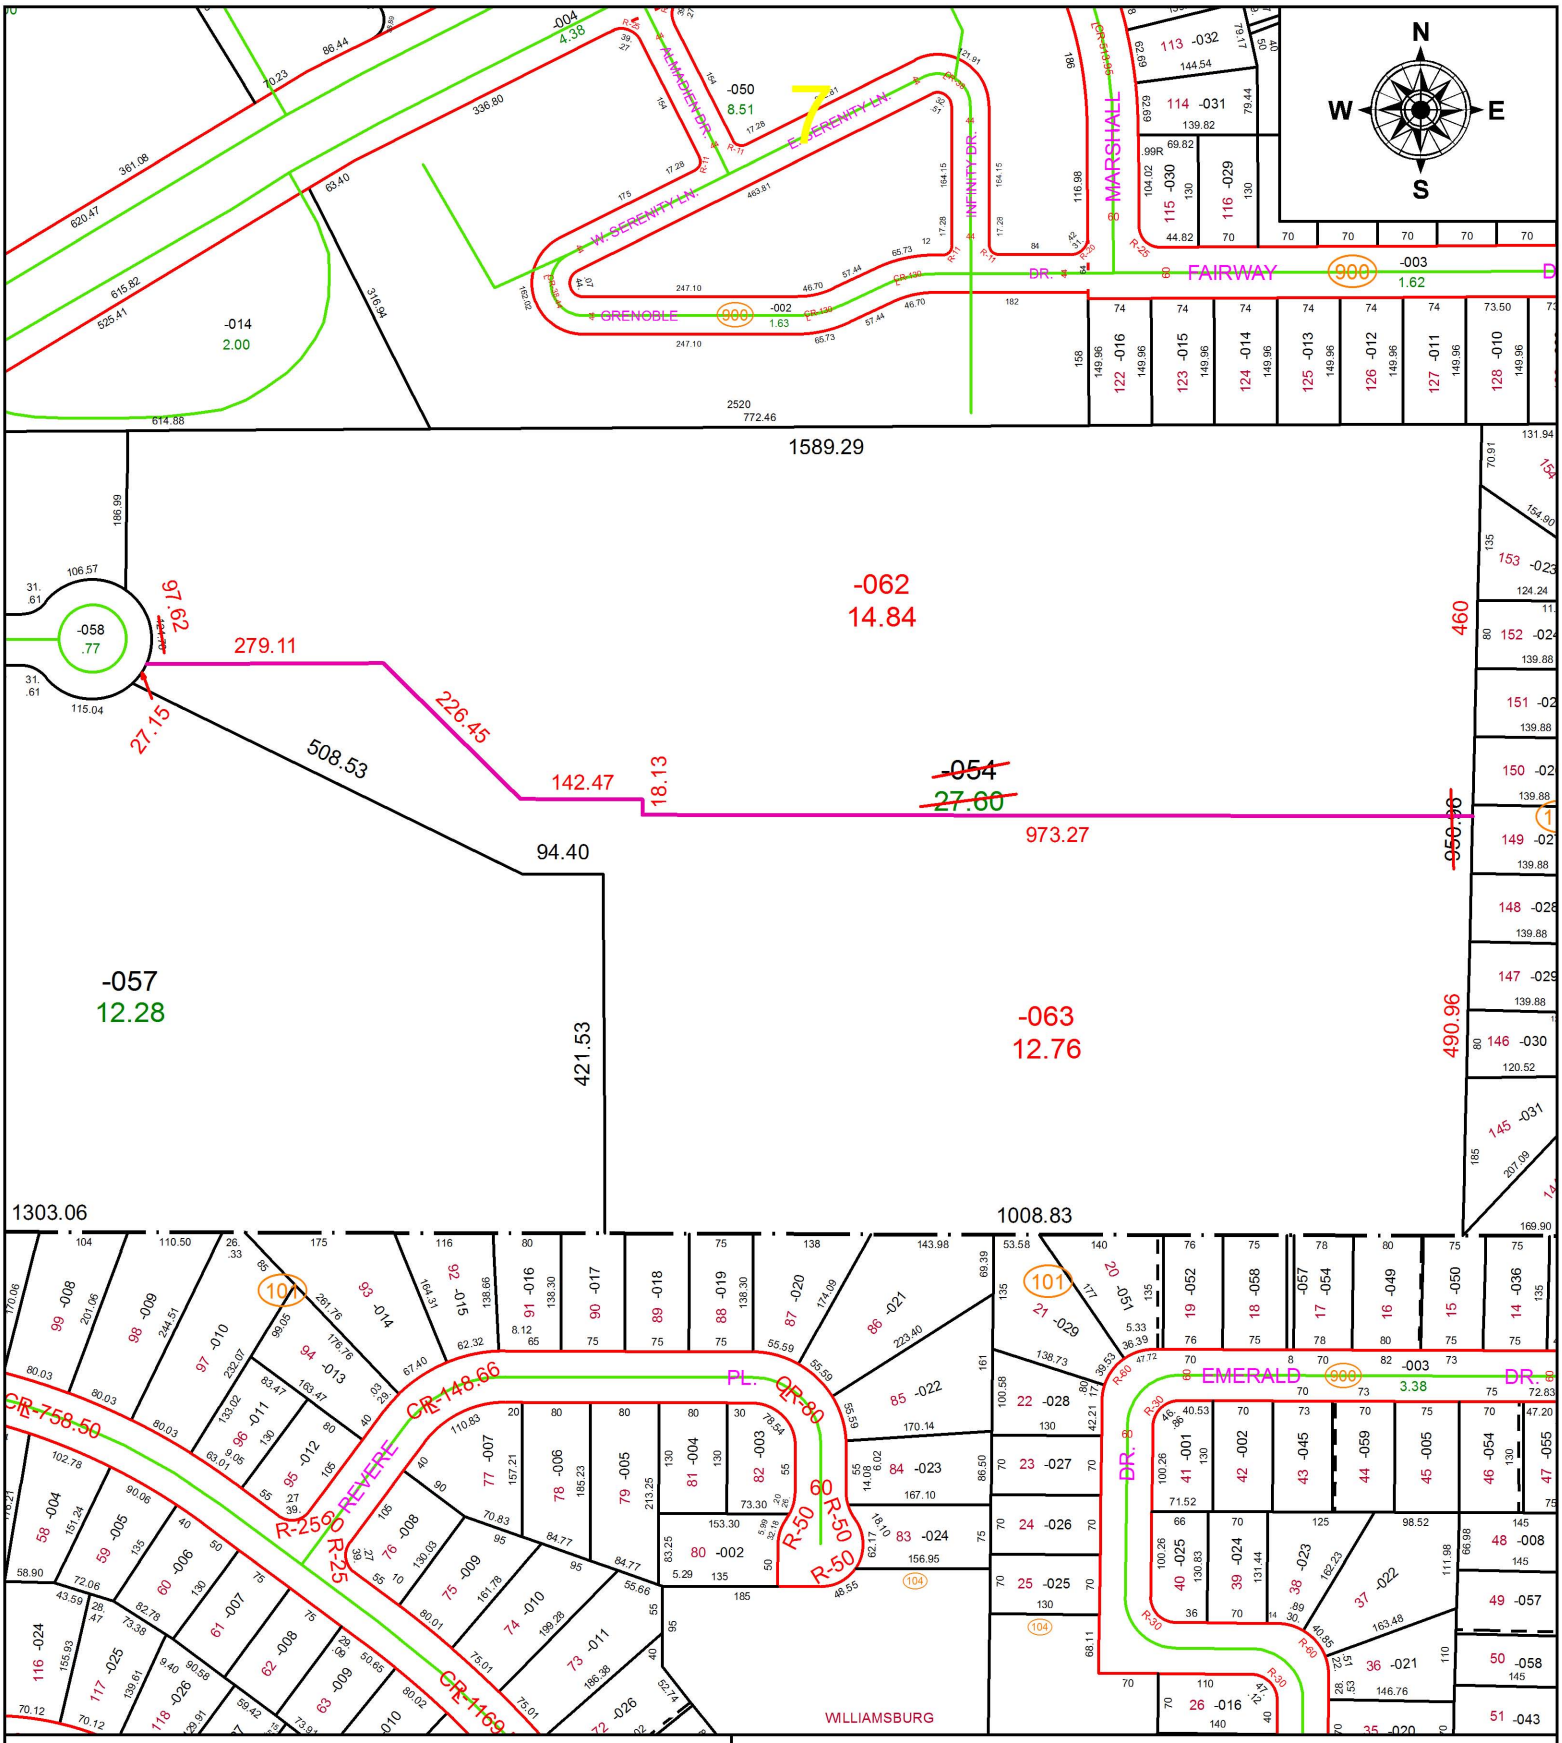

SPLITS/DEEDS PROCESSED

LORAIN COUNTY TAX MAP DEPARTMENT
226 MIDDLE AVE. ELYRIA, OH

SURVEYED BY: ANDREW G. PLANET

CLOSURE: 1: 3,692,540

MAP PAGE(S): 2-02-007

APPOVED BY: RRM **DATE:** 8-9-18

SCALE: 1" = 225 **PRIOR INSTRUMENT:** 20130486378